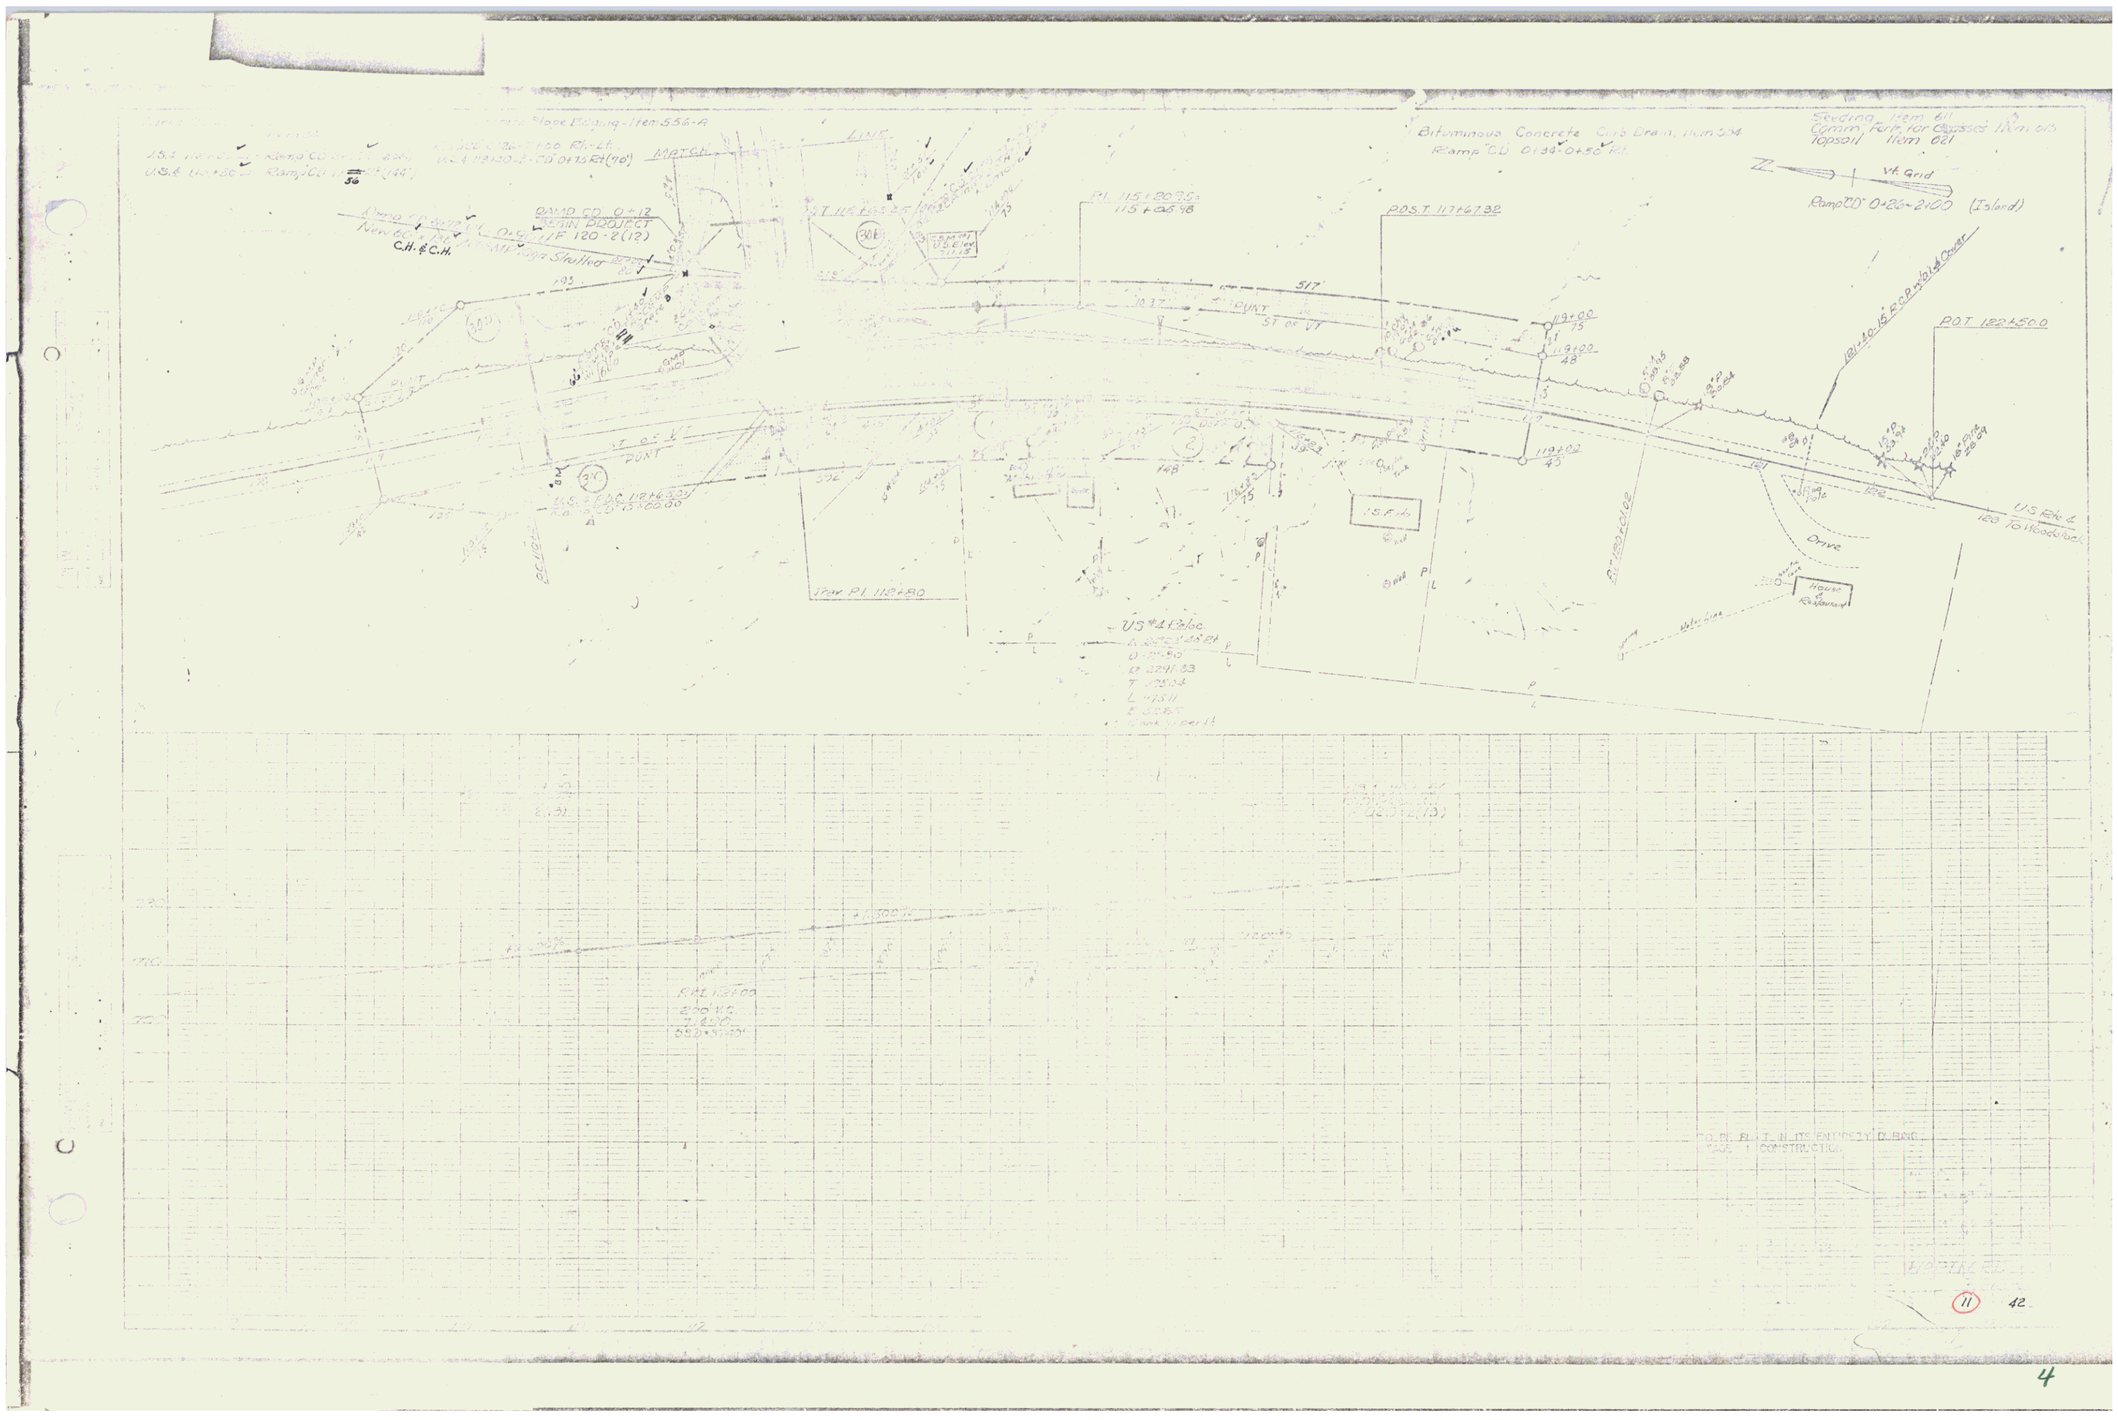
Bituminous Concrete Curb Drain, Item 534
Ramp "CD" 0+38-0+56 Rt.
Seeding, Item 611
Comm. Fert. for Grasses Item 615
Topsoil Item 621
Vt. Grid
Ramp "CD" 0+26-2+00 (Island)
C.H. & C.H.
MAIN PROJECT
P.O.S.T. 117+67.32
P.O.T. 122+50.0
Drive
House & Restaurant
