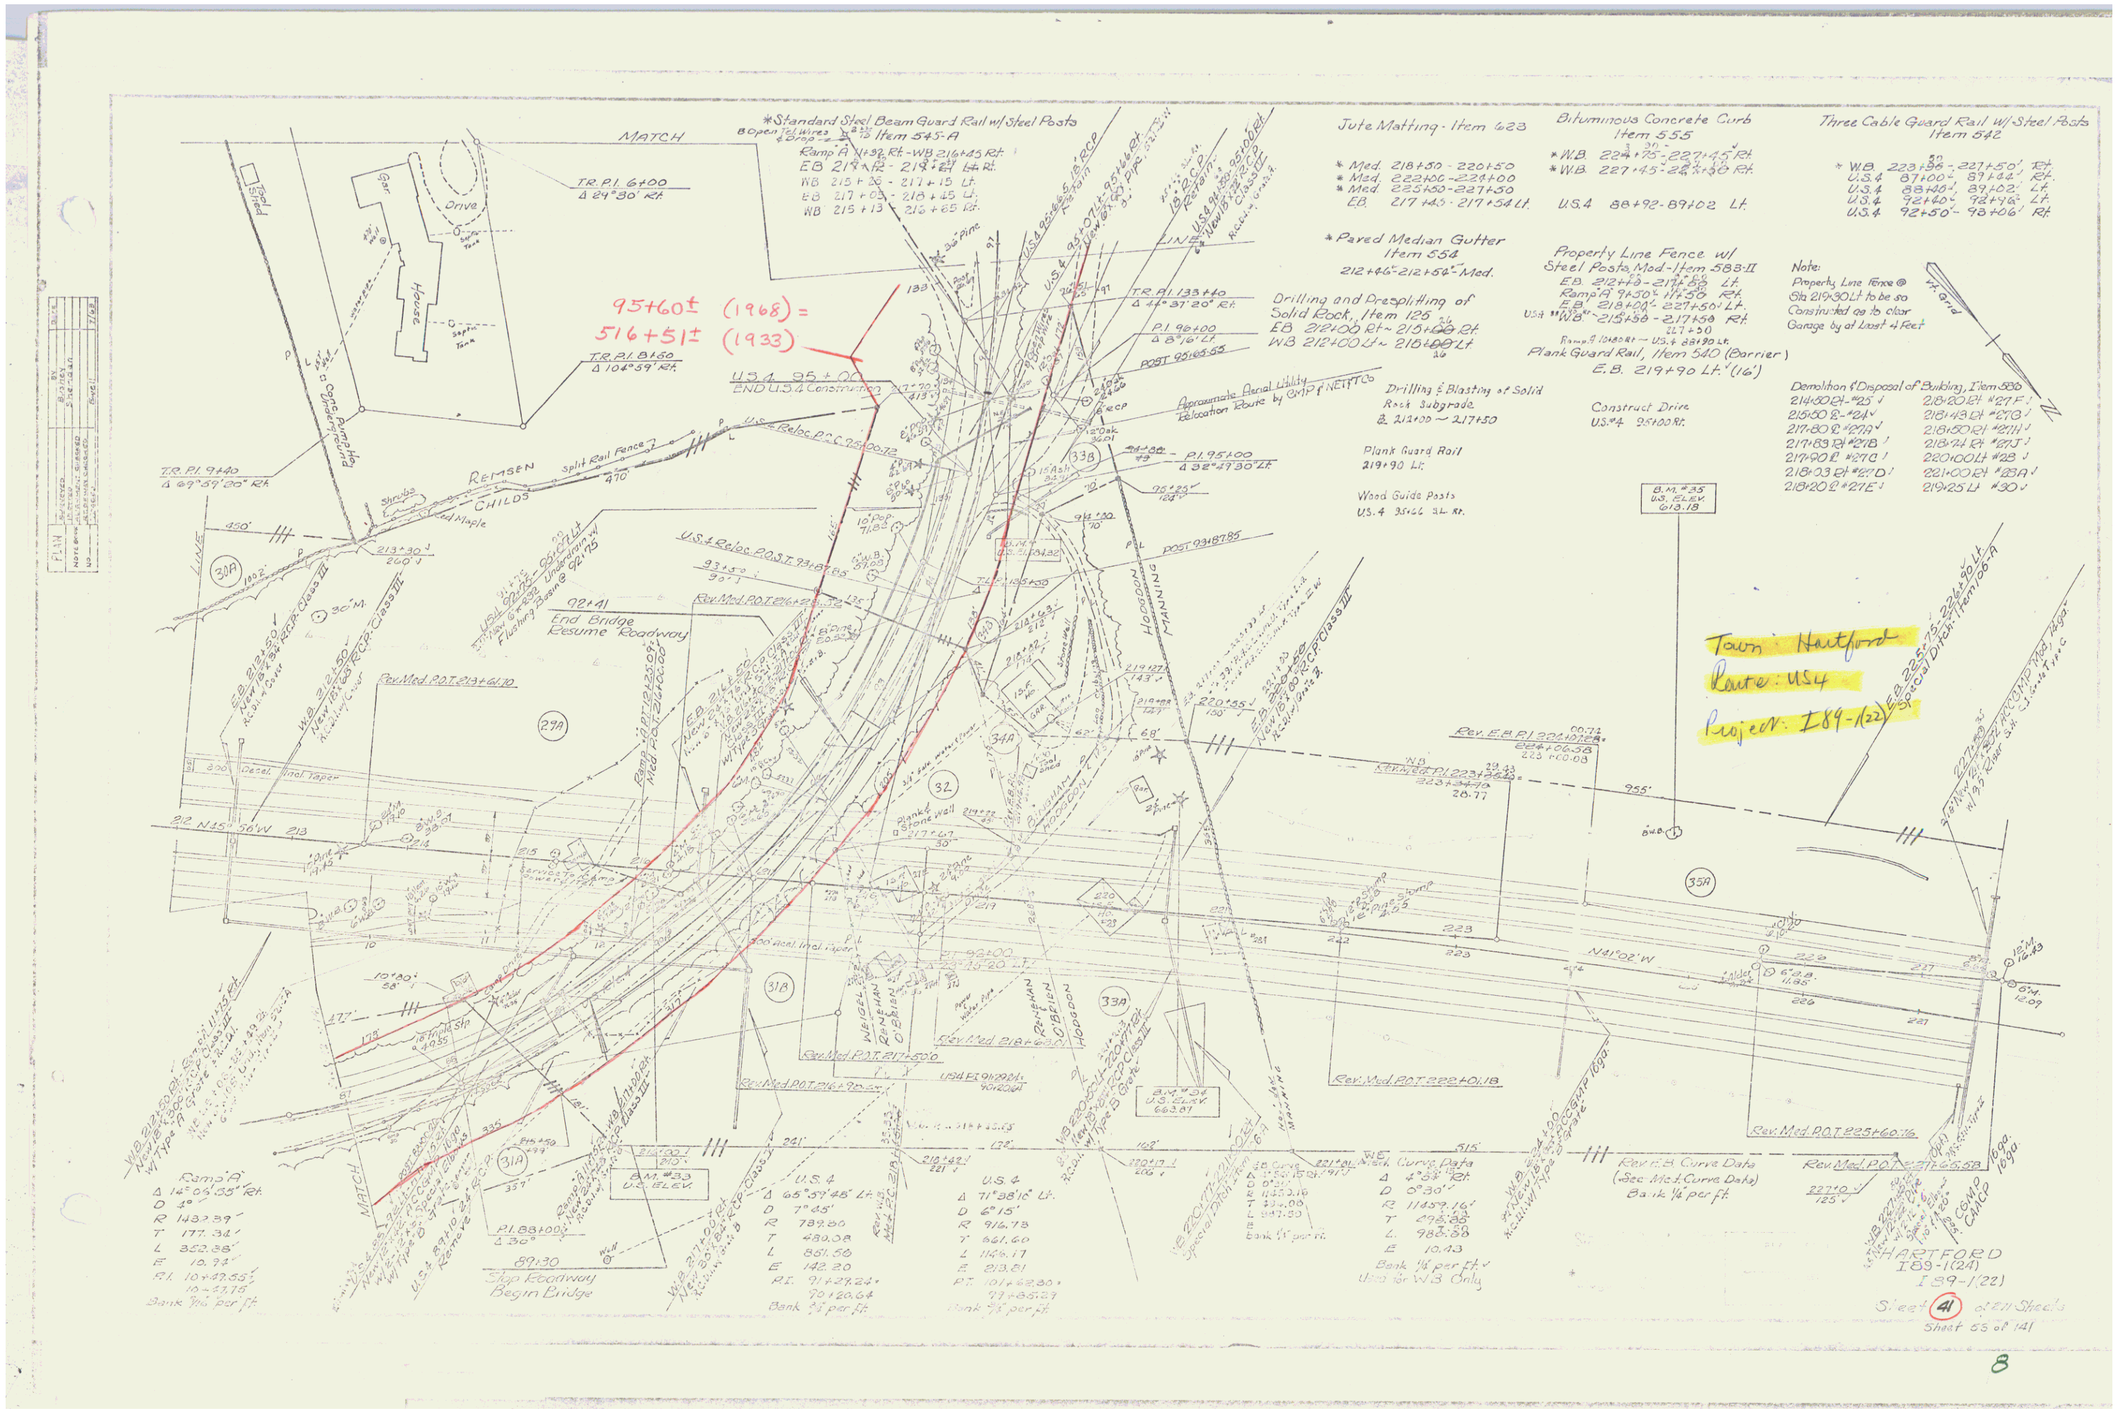
Town: Hartford
Route: US4
Project: I89-1(22)
HARTFORD
I89-1(24)
I89-1(22)
Sheet 41 of 211 Sheets
Sheet 55 of 141
*Standard Steel Beam Guard Rail w/Steel Posts
Item 545-A
Jute Matting - Item 628
Bituminous Concrete Curb
Item 555
Three Cable Guard Rail w/Steel Posts
Item 542
*Paved Median Gutter
Item 554
Property Line Fence w/
Steel Posts, Mod-Item 588-II
Drilling and Presplitting of
Solid Rock, Item 125
Plank Guard Rail, Item 540 (Barrier)
Drilling & Blasting of Solid
Rock Subgrade
Construct Drive
Demolition & Disposal of Building, Item 580
Approximate Aerial Utility
Relocation Route by GMP & NETT Co
Plank Guard Rail
Wood Guide Posts
Note:
Property Line Fence @
Sta 219+30 Lt to be so
Constructed as to clear
Garage by at Least 4 Feet
95+60± (1968) =
516+51± (1933)
MATCH
REIMSEN
CHILDS
Split Rail Fence
End Bridge
Resume Roadway
Stop Roadway
Begin Bridge
Ramp A
Ramp B
Curve Data
Rev. B Curve Data
(See Mod. Curve Data)
Bank 1/4" per ft
Rev. Mod. P.O.T. 222+01.18
Rev. Mod. P.O.T. 223+60.16
Rev. Mod. P.O.T. 227+65.58
B.M. #33
U.S. ELEV.
663.81
B.M. #33
U.S. ELEV.
613.18
U.S. 4
Bank 1/8" per ft
Used for WB Only

8