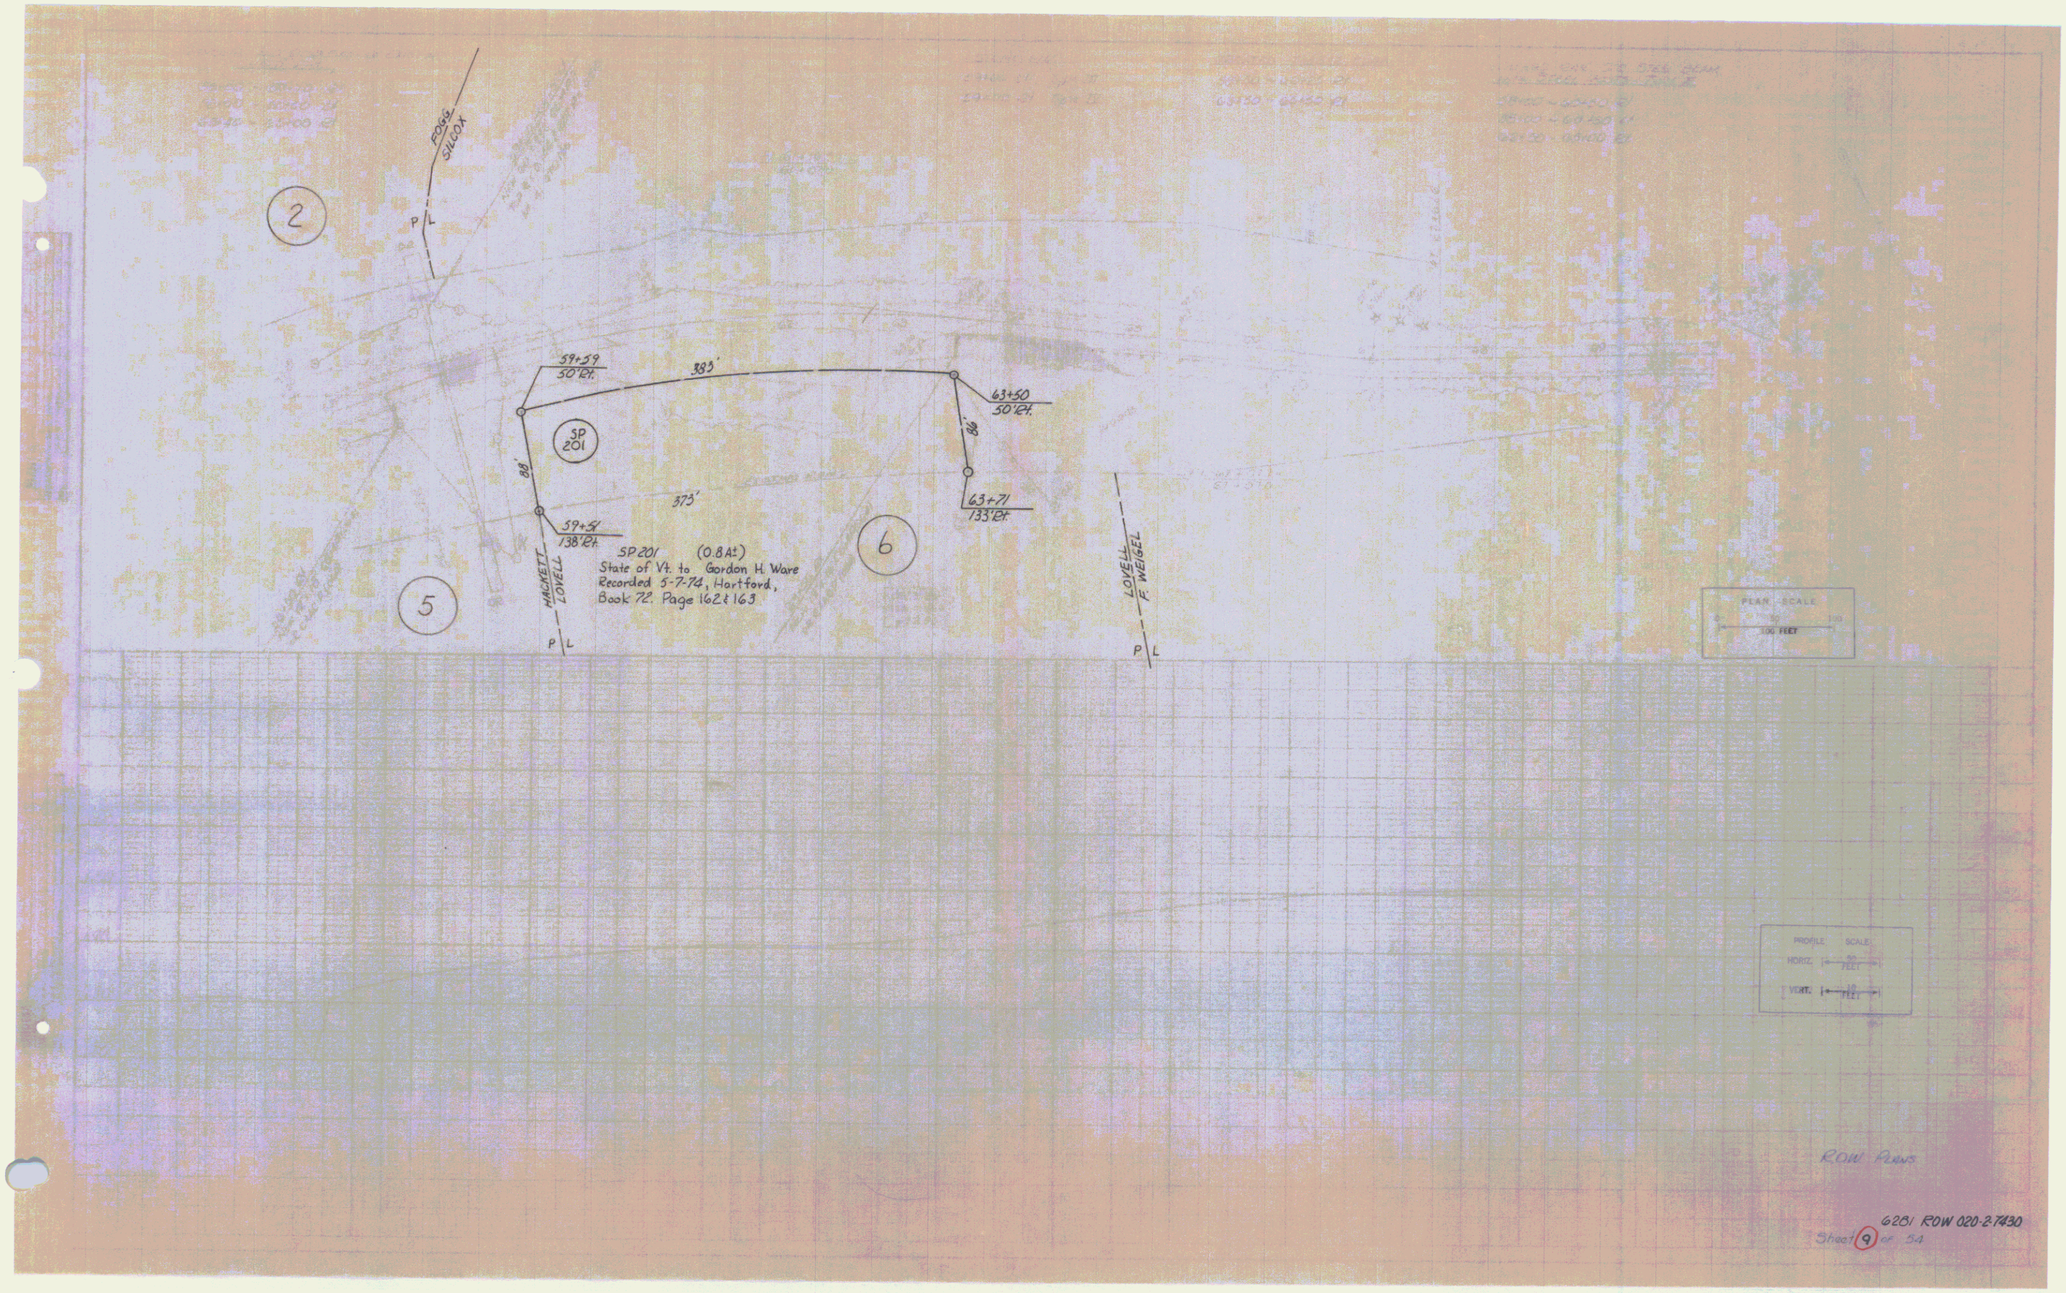
FORG. SILOX
2
P L
59+39
50'Rt.
385'
63+50
50'Rt.
SP 201
88'
88'
375'
63+71
133'Rt.
59+51
138'Rt.
SP 201 (0.8 Ac±)
State of Vt. to Gordon H. Ware
Recorded 5-7-74, Hartford,
Book 72. Page 162 & 163
6
5
HACKETT
LOVELL
LOVELL
F. WEIGEL
P L
P L
PLAN SCALE
0 50 100
100 FEET
PROFILE SCALE
HORIZ. 50 FEET
VERT. 10 FEET
ROW Plans
6281 ROW 020-2-7430
Sheet 9 of 54

6