REMOVAL AND DISPOSAL of EXISTING GUARD RAIL
15+50 ~ 20+60 Rt
27+95 ~ 29+90 Rt
27+65 ~ 29+45 Lt

STONE FILL - Type II
19+00 - 20+00 Rt
Done by Dist mtf

GUARD RAIL, STD. STEEL BEAM WITH STEEL POSTS - TYPE II
14+50 ~ 21+00 Rt
27+00 ~ 30+00 Rt
27+50 ~ 29+50 Lt

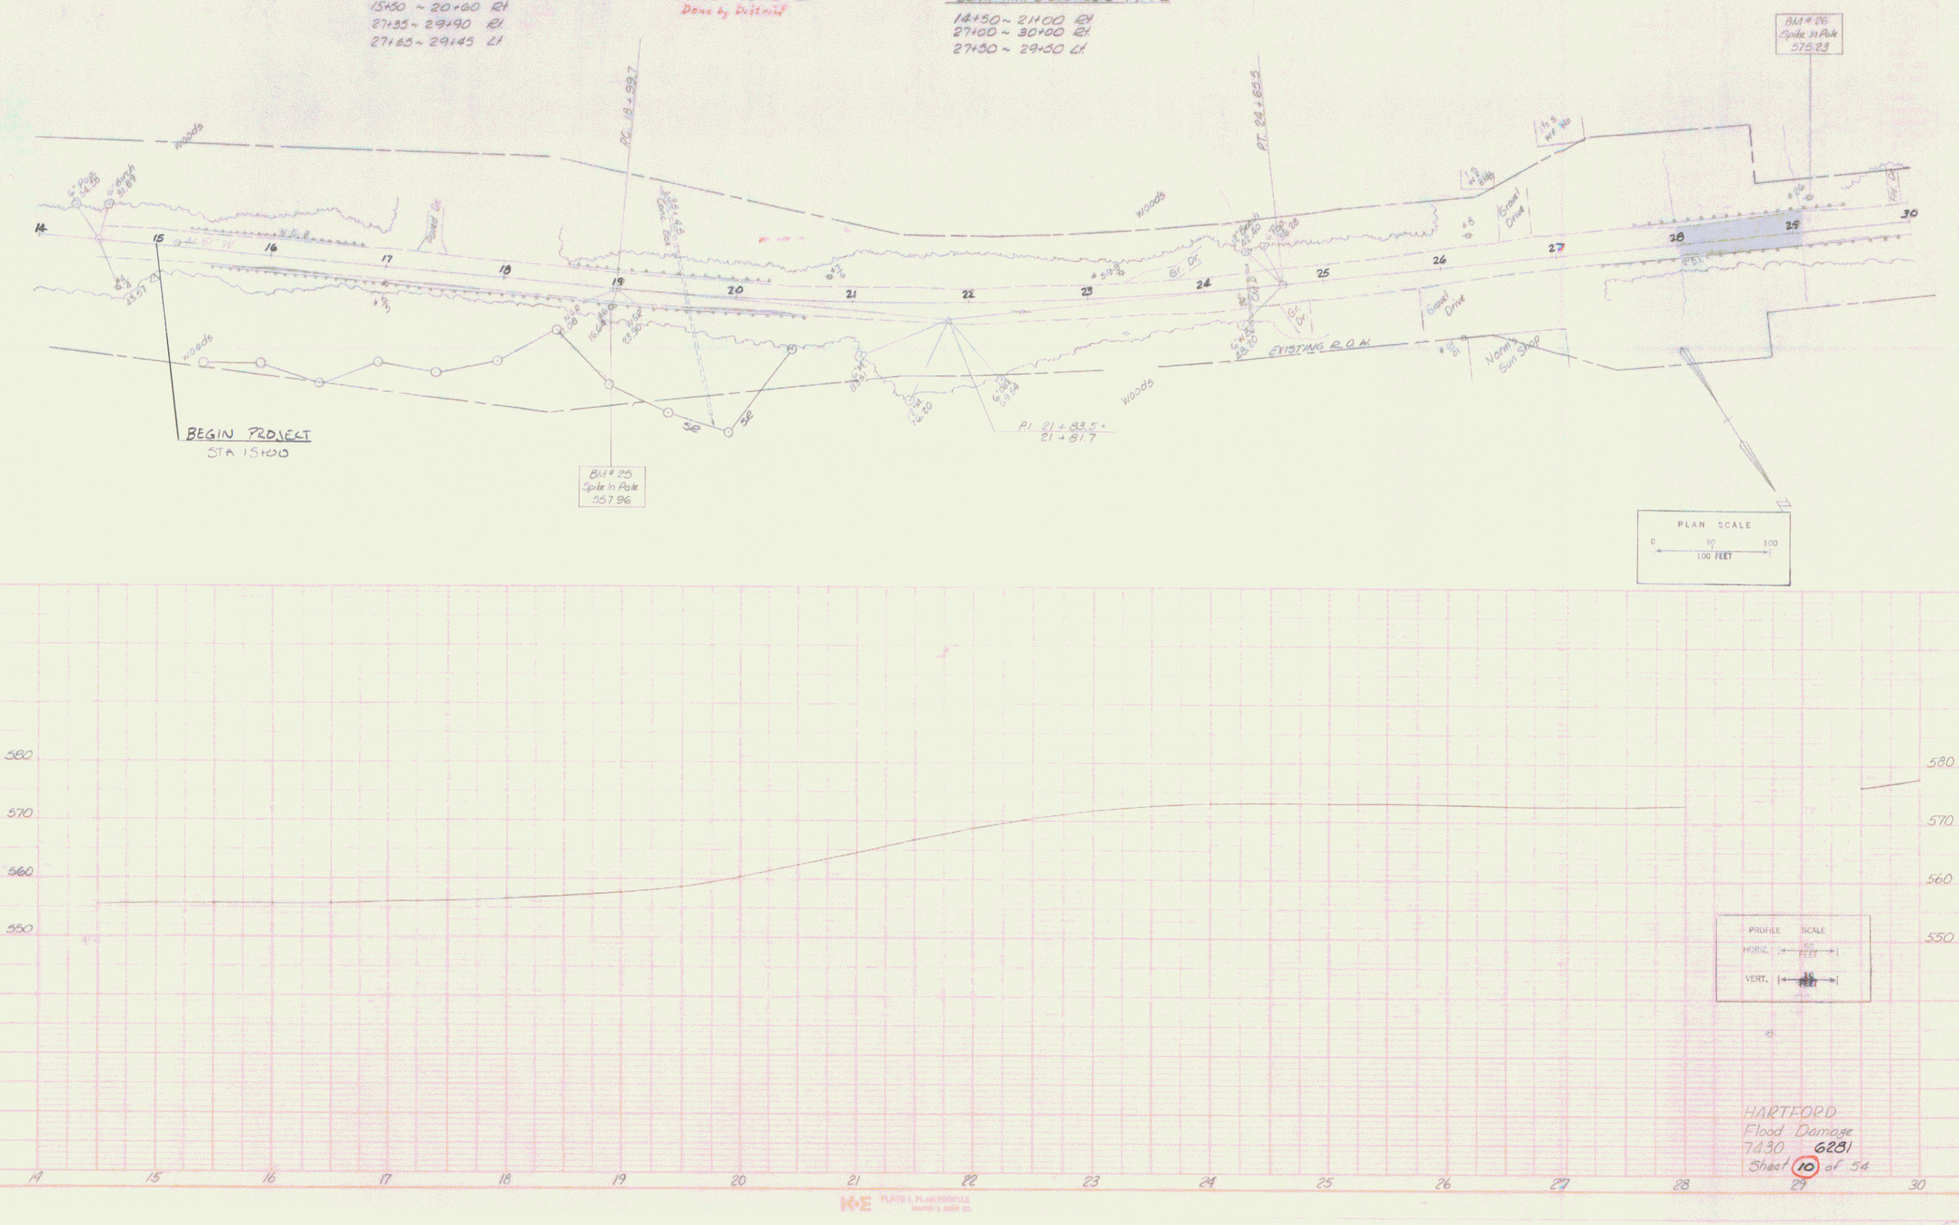

HARTFORD
Flood Damage
7430 6281
Sheet (10) of 54

7