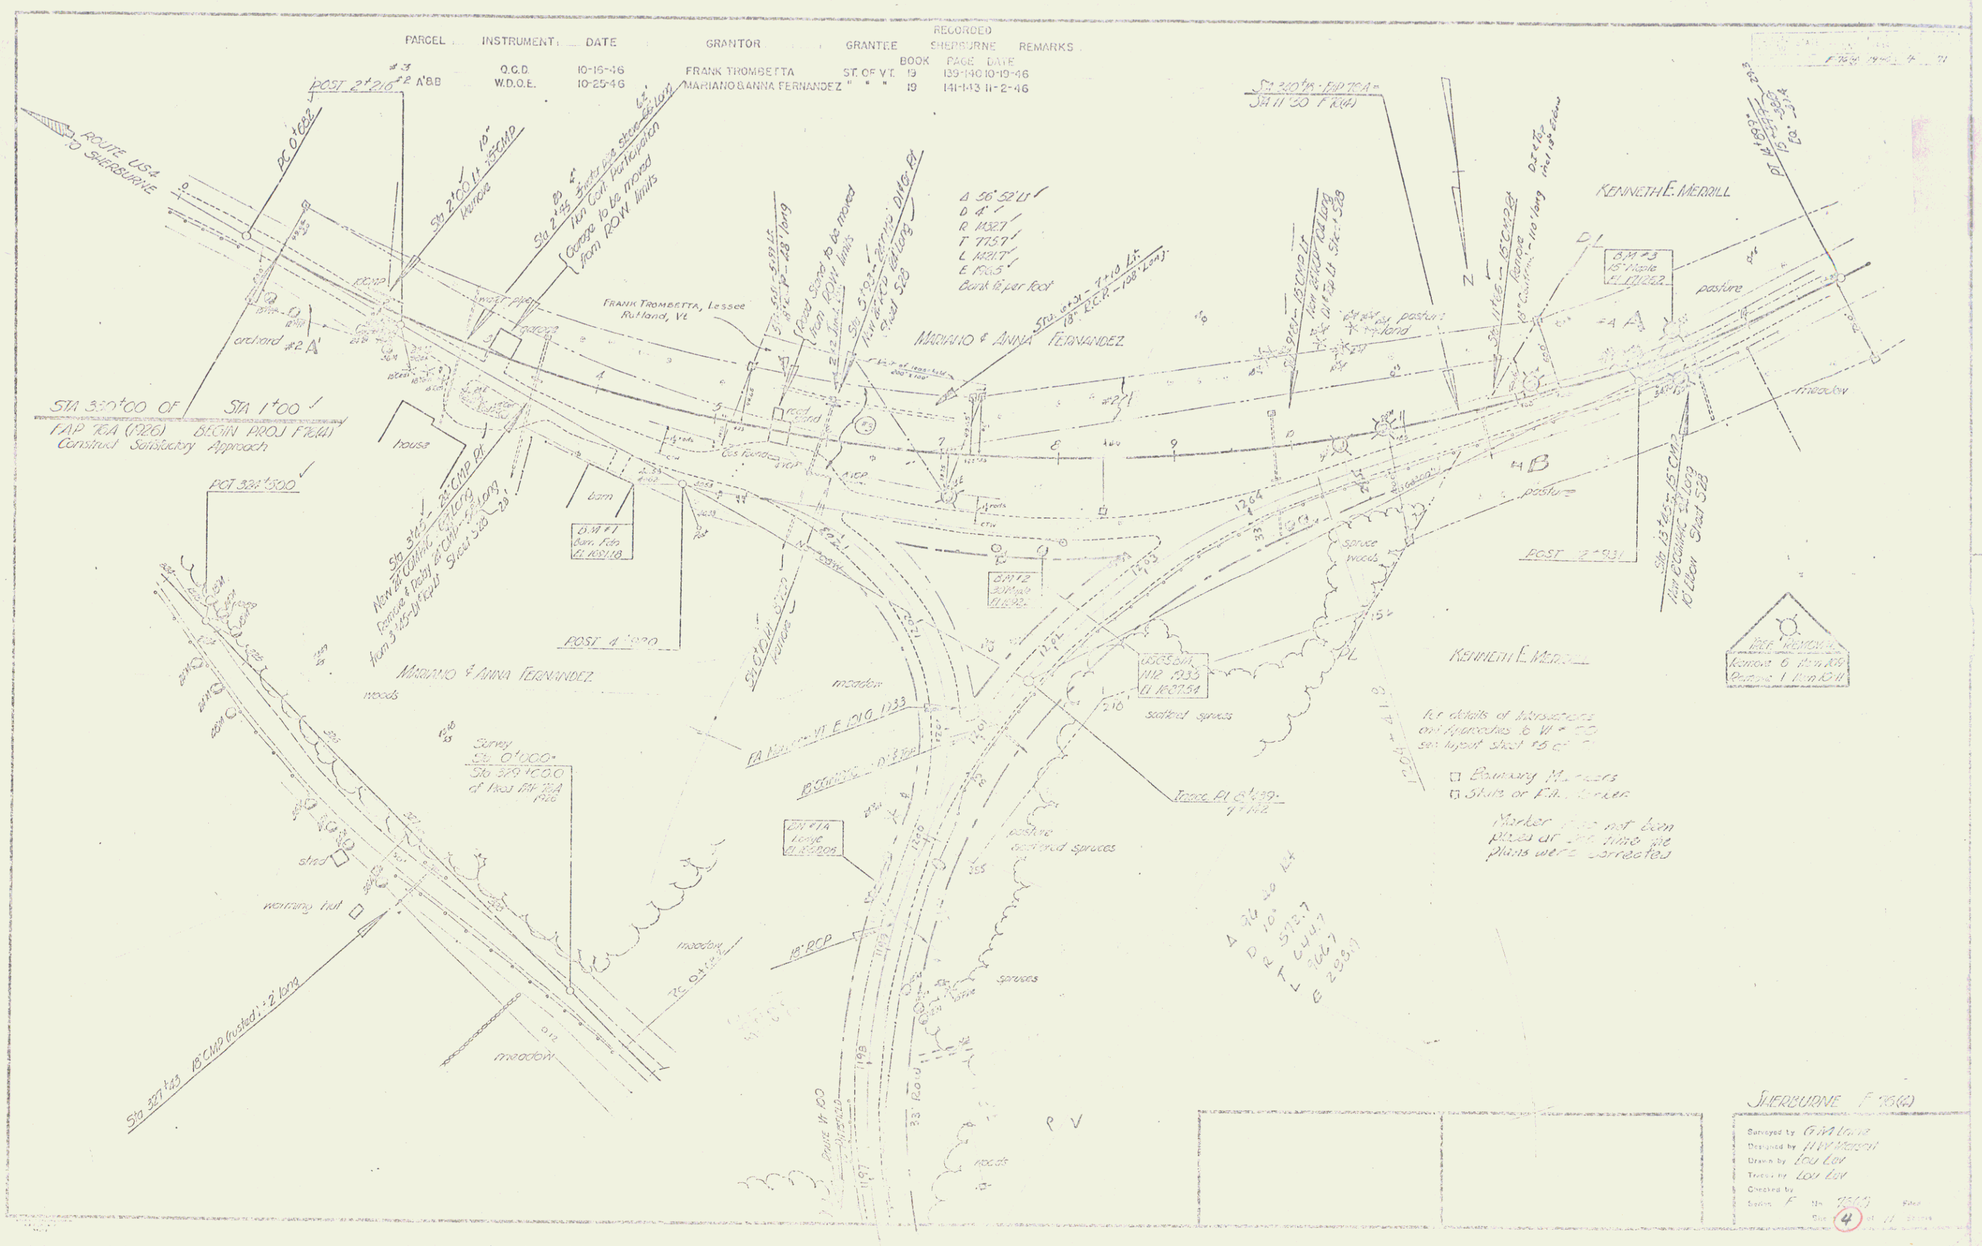PARCEL	INSTRUMENT	DATE	GRANTOR	GRANTEE	RECORDED SHEFFBURNE BOOK	PAGE	DATE	REMARKS
#3	Q.C.D.	10-16-46	FRANK TROMBETTA	ST. OF VT.	19	139-140	10-19-46	
2+216 #2 A'&B	W.D.O.E.	10-25-46	MARIANO & ANNA FERNANDEZ	" " "	19	141-143	11-2-46