| PARCEL | INSTRUMENT | DATE | GRANTOR | GRANTEE | RECORDED SHERBURNE BOOK | PAGE | DATE | REMARKS |
|---|---|---|---|---|---|---|---|---|
| #10 A&B | W.D.O.E. | 9-18-46 | JAMES S. ABATIELL | ST. OF VT. | 19 | 135-136 | 10-19-46 | |

RELINQUISHED

Δ 53°44' Lt
D 3°
R 1910.1
T 967.6
L 1791.1
E 28.1
Bank 1½' per ft. except truck.
Lane 1.0' bank ½' per ft.

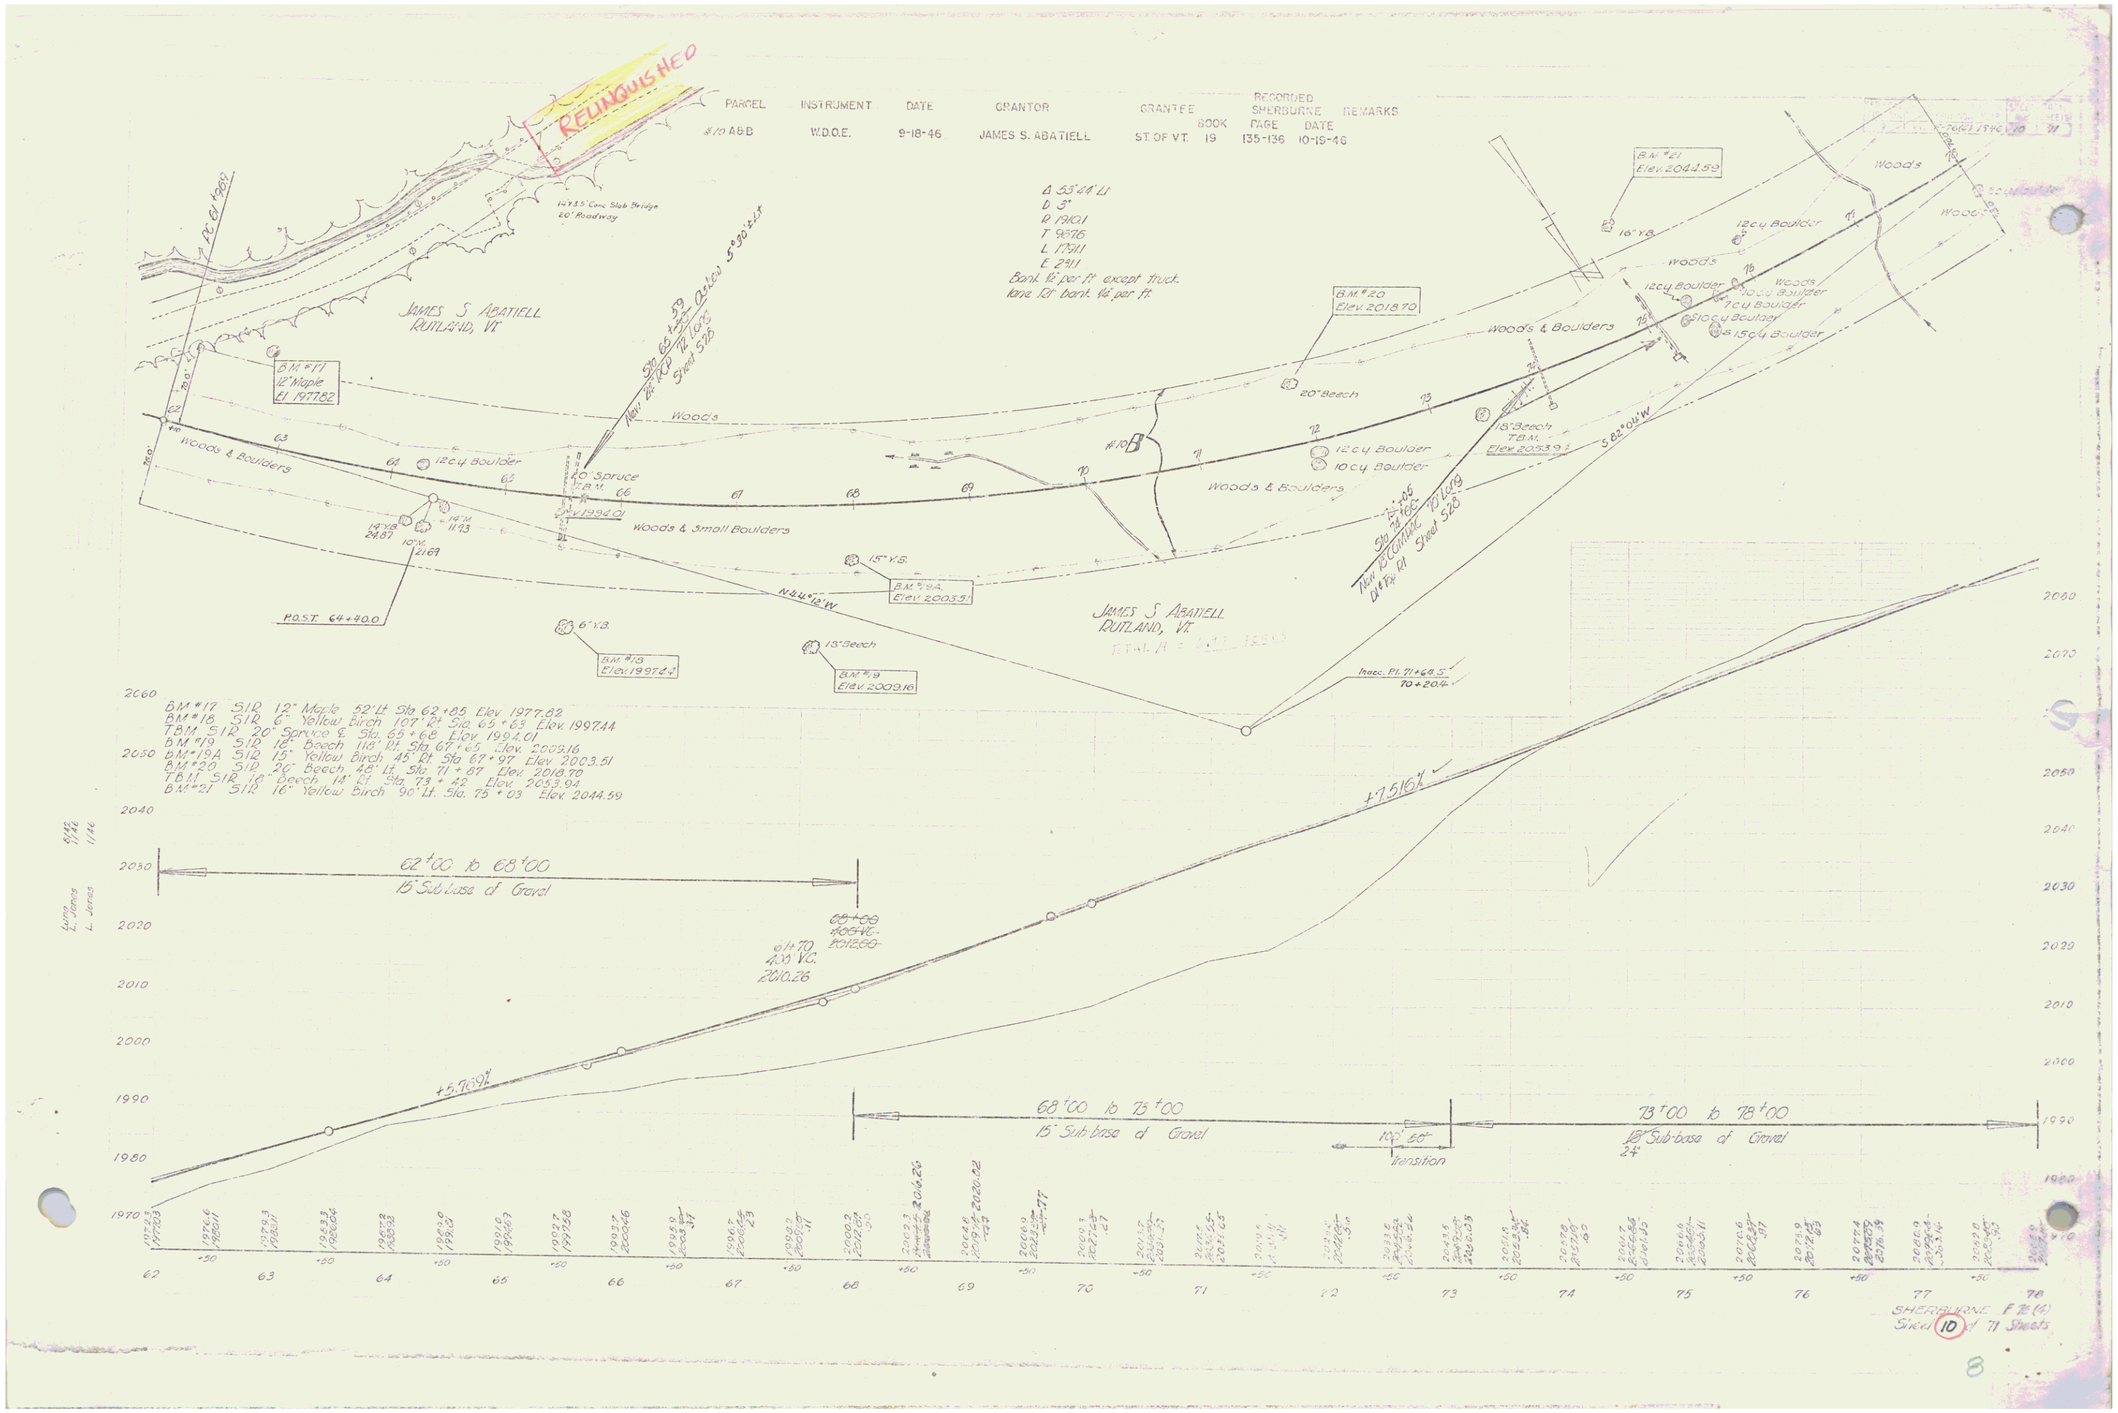


SHERBURNE F 72 (4)
Sheet 10 of 71 Sheets

8