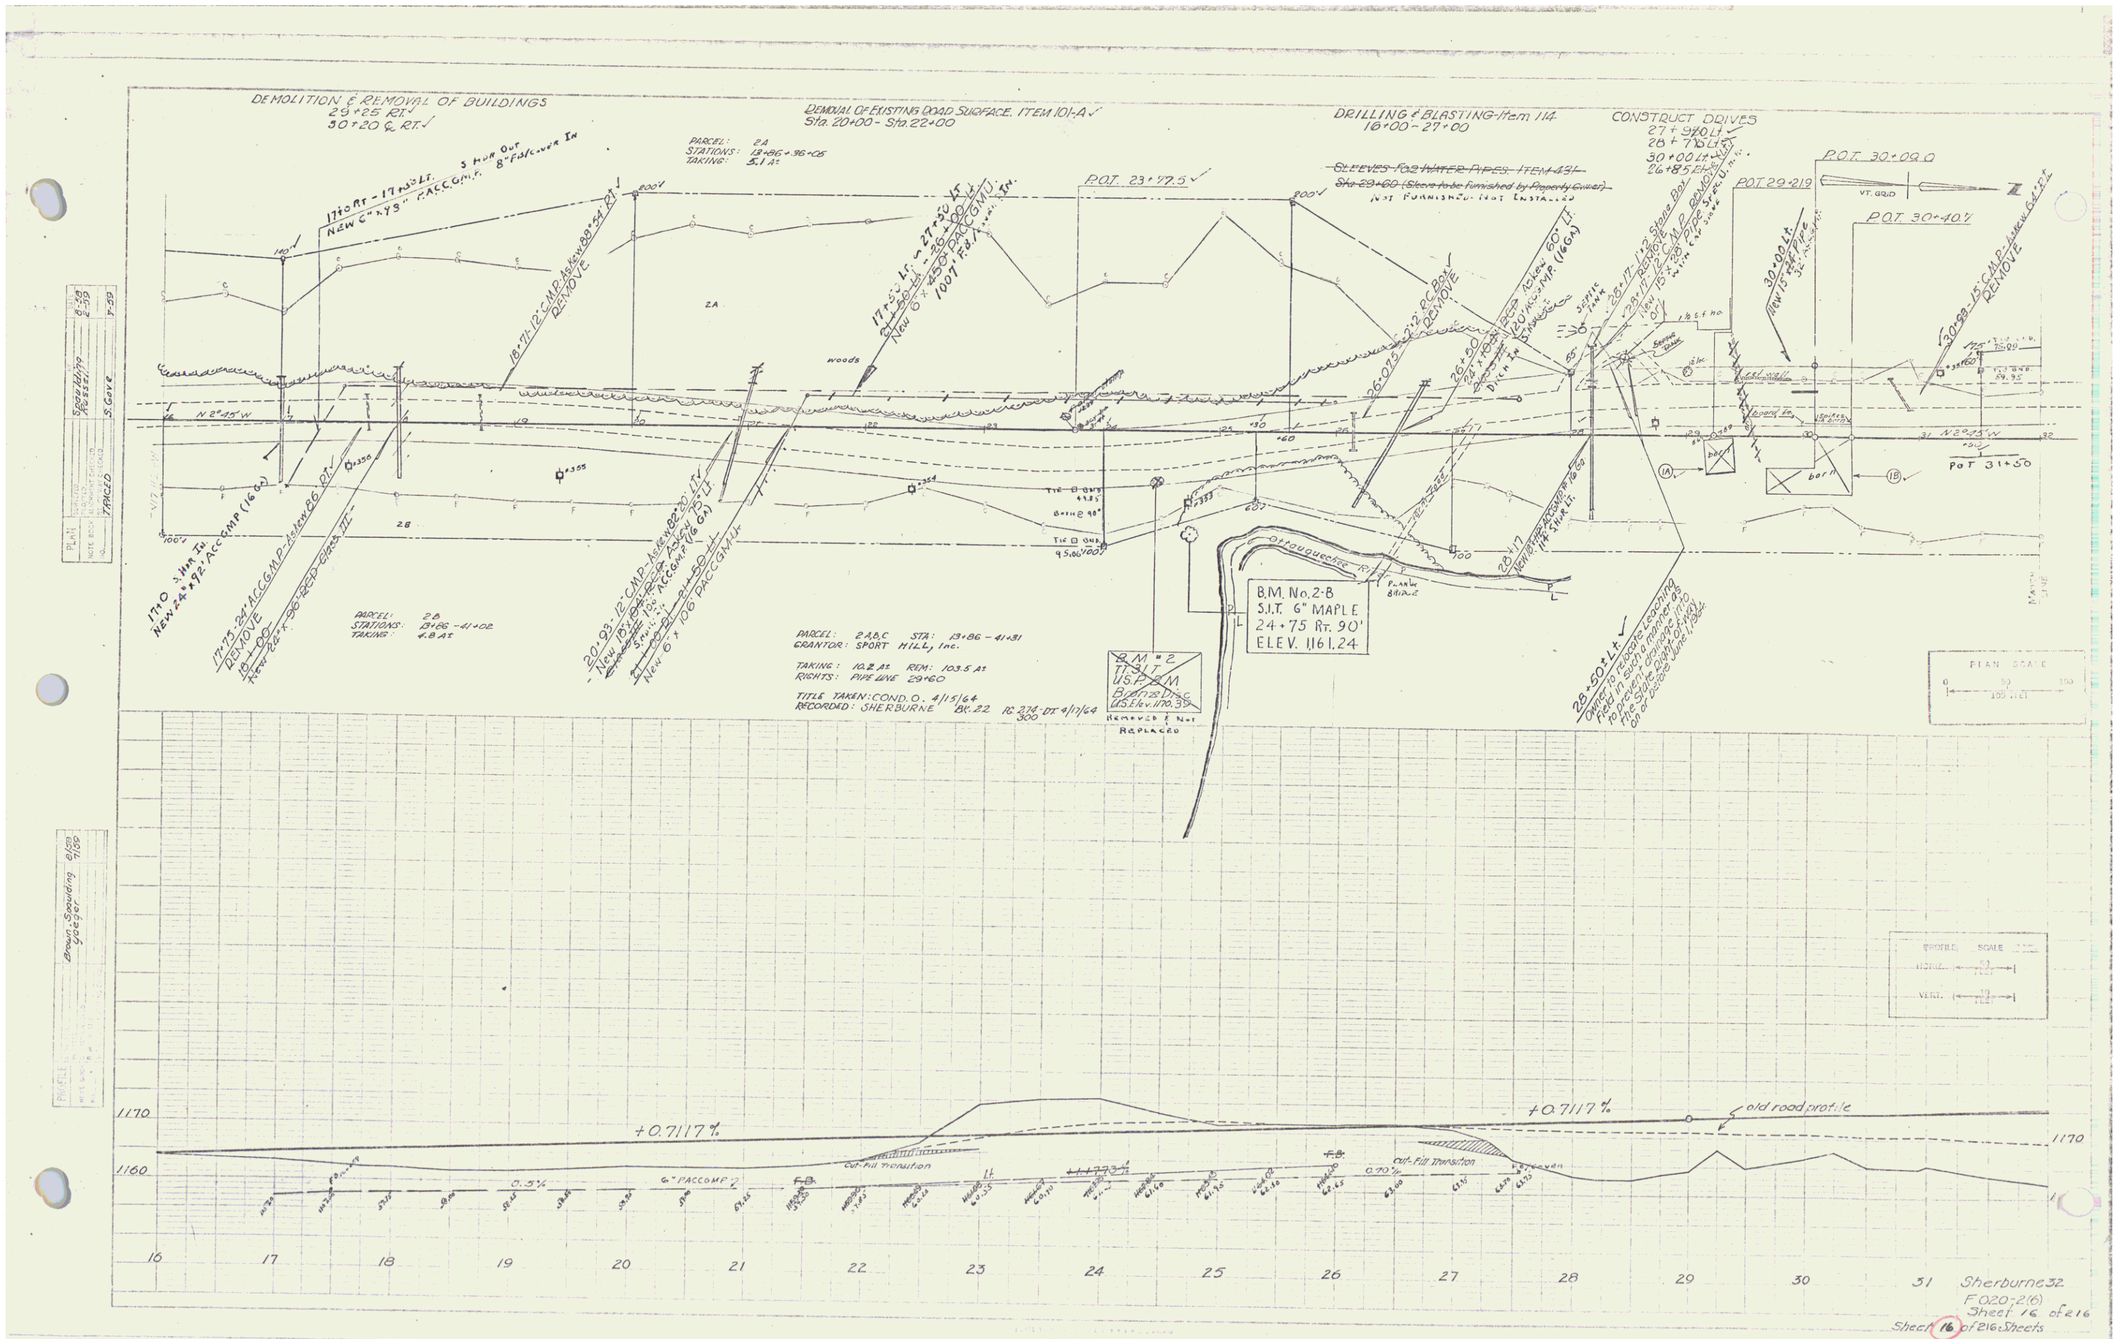

Sherburne32
F020;2(6)
Sheet 16 of 216
Sheet 16 of 216 Sheets

3