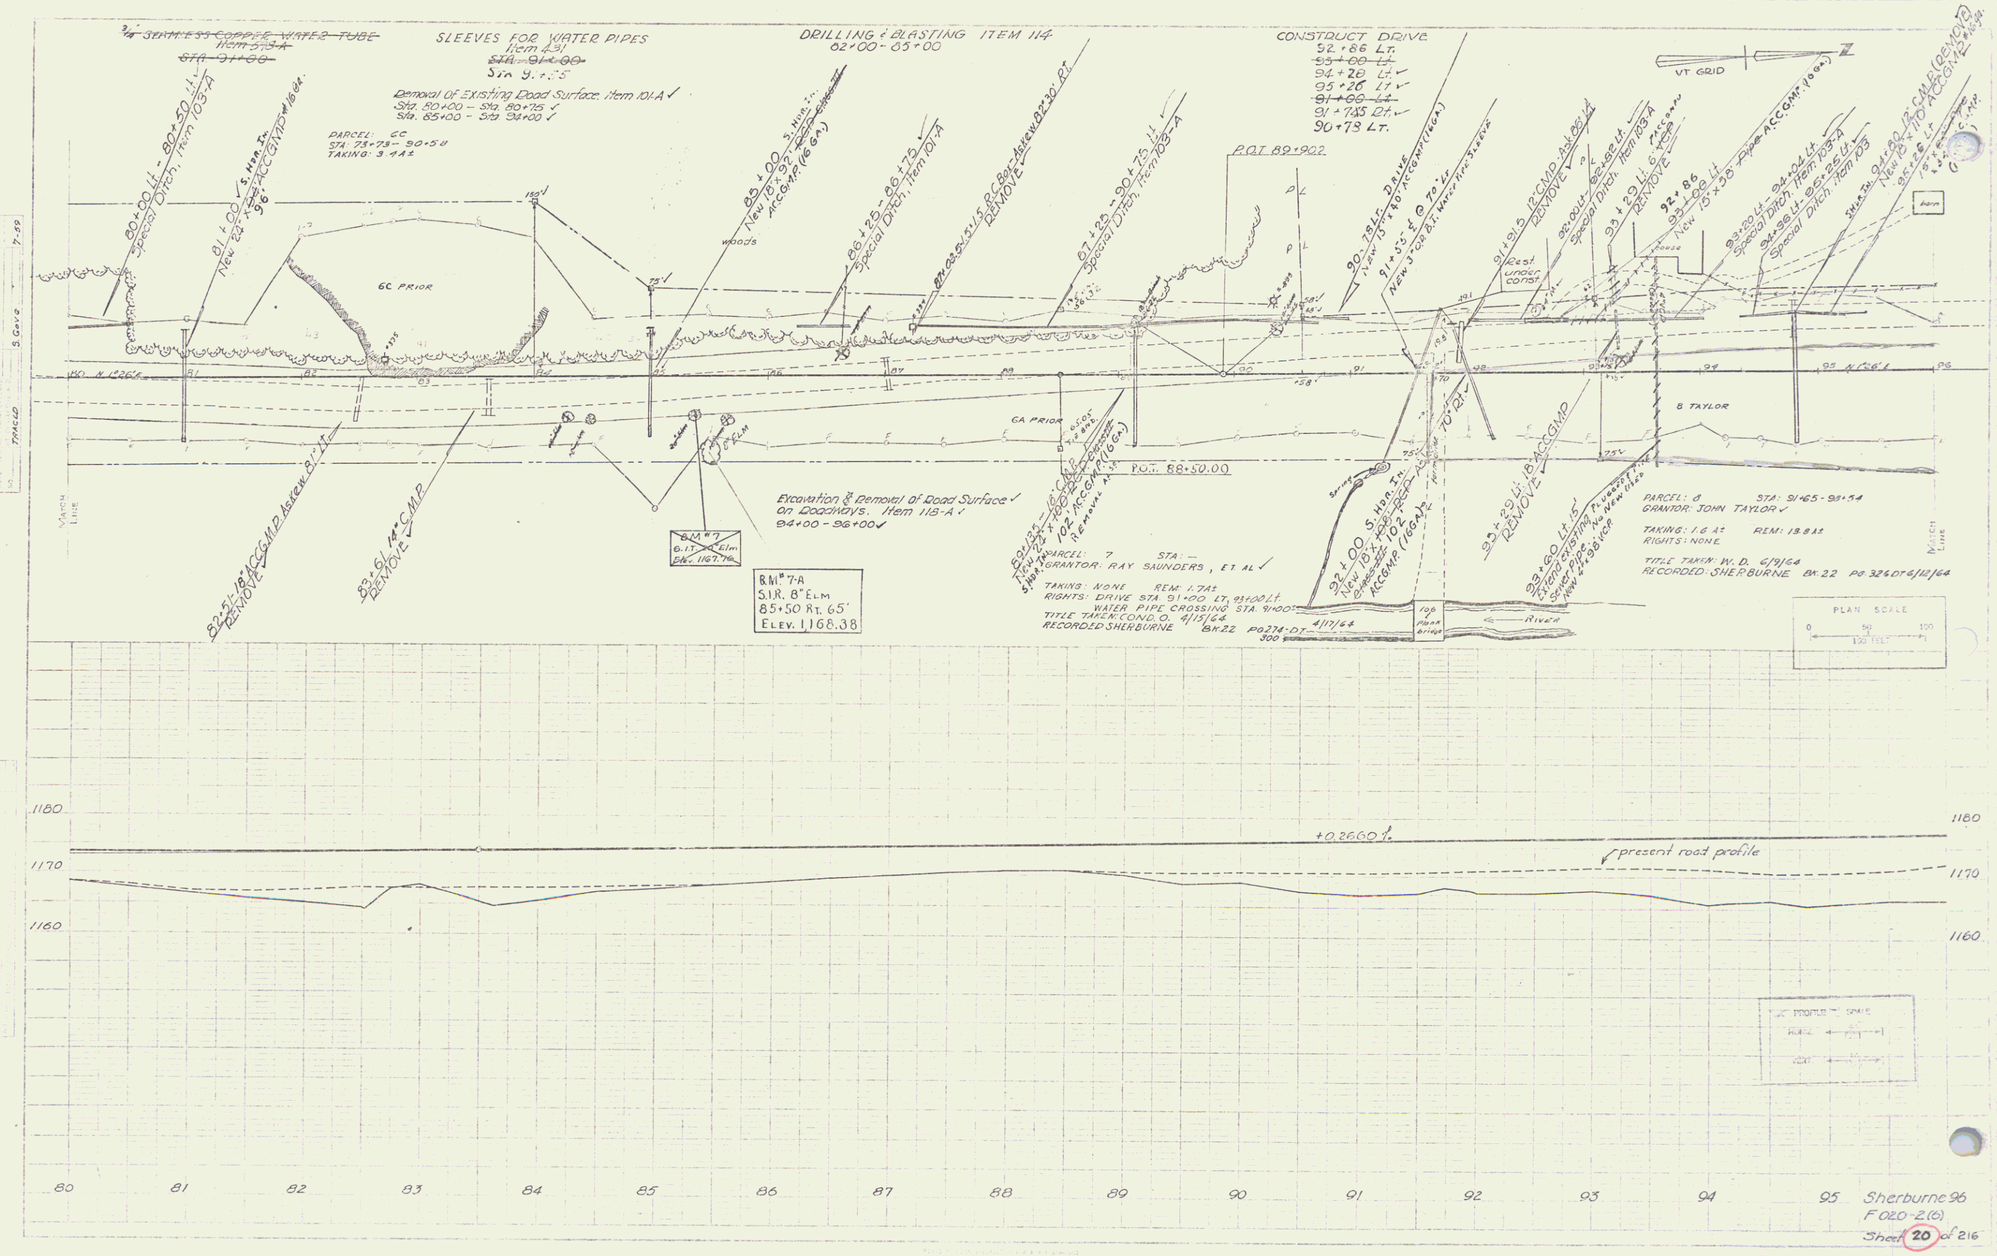

Sherburne 96
F 020-2(6)
Sheet 20 of 216

7