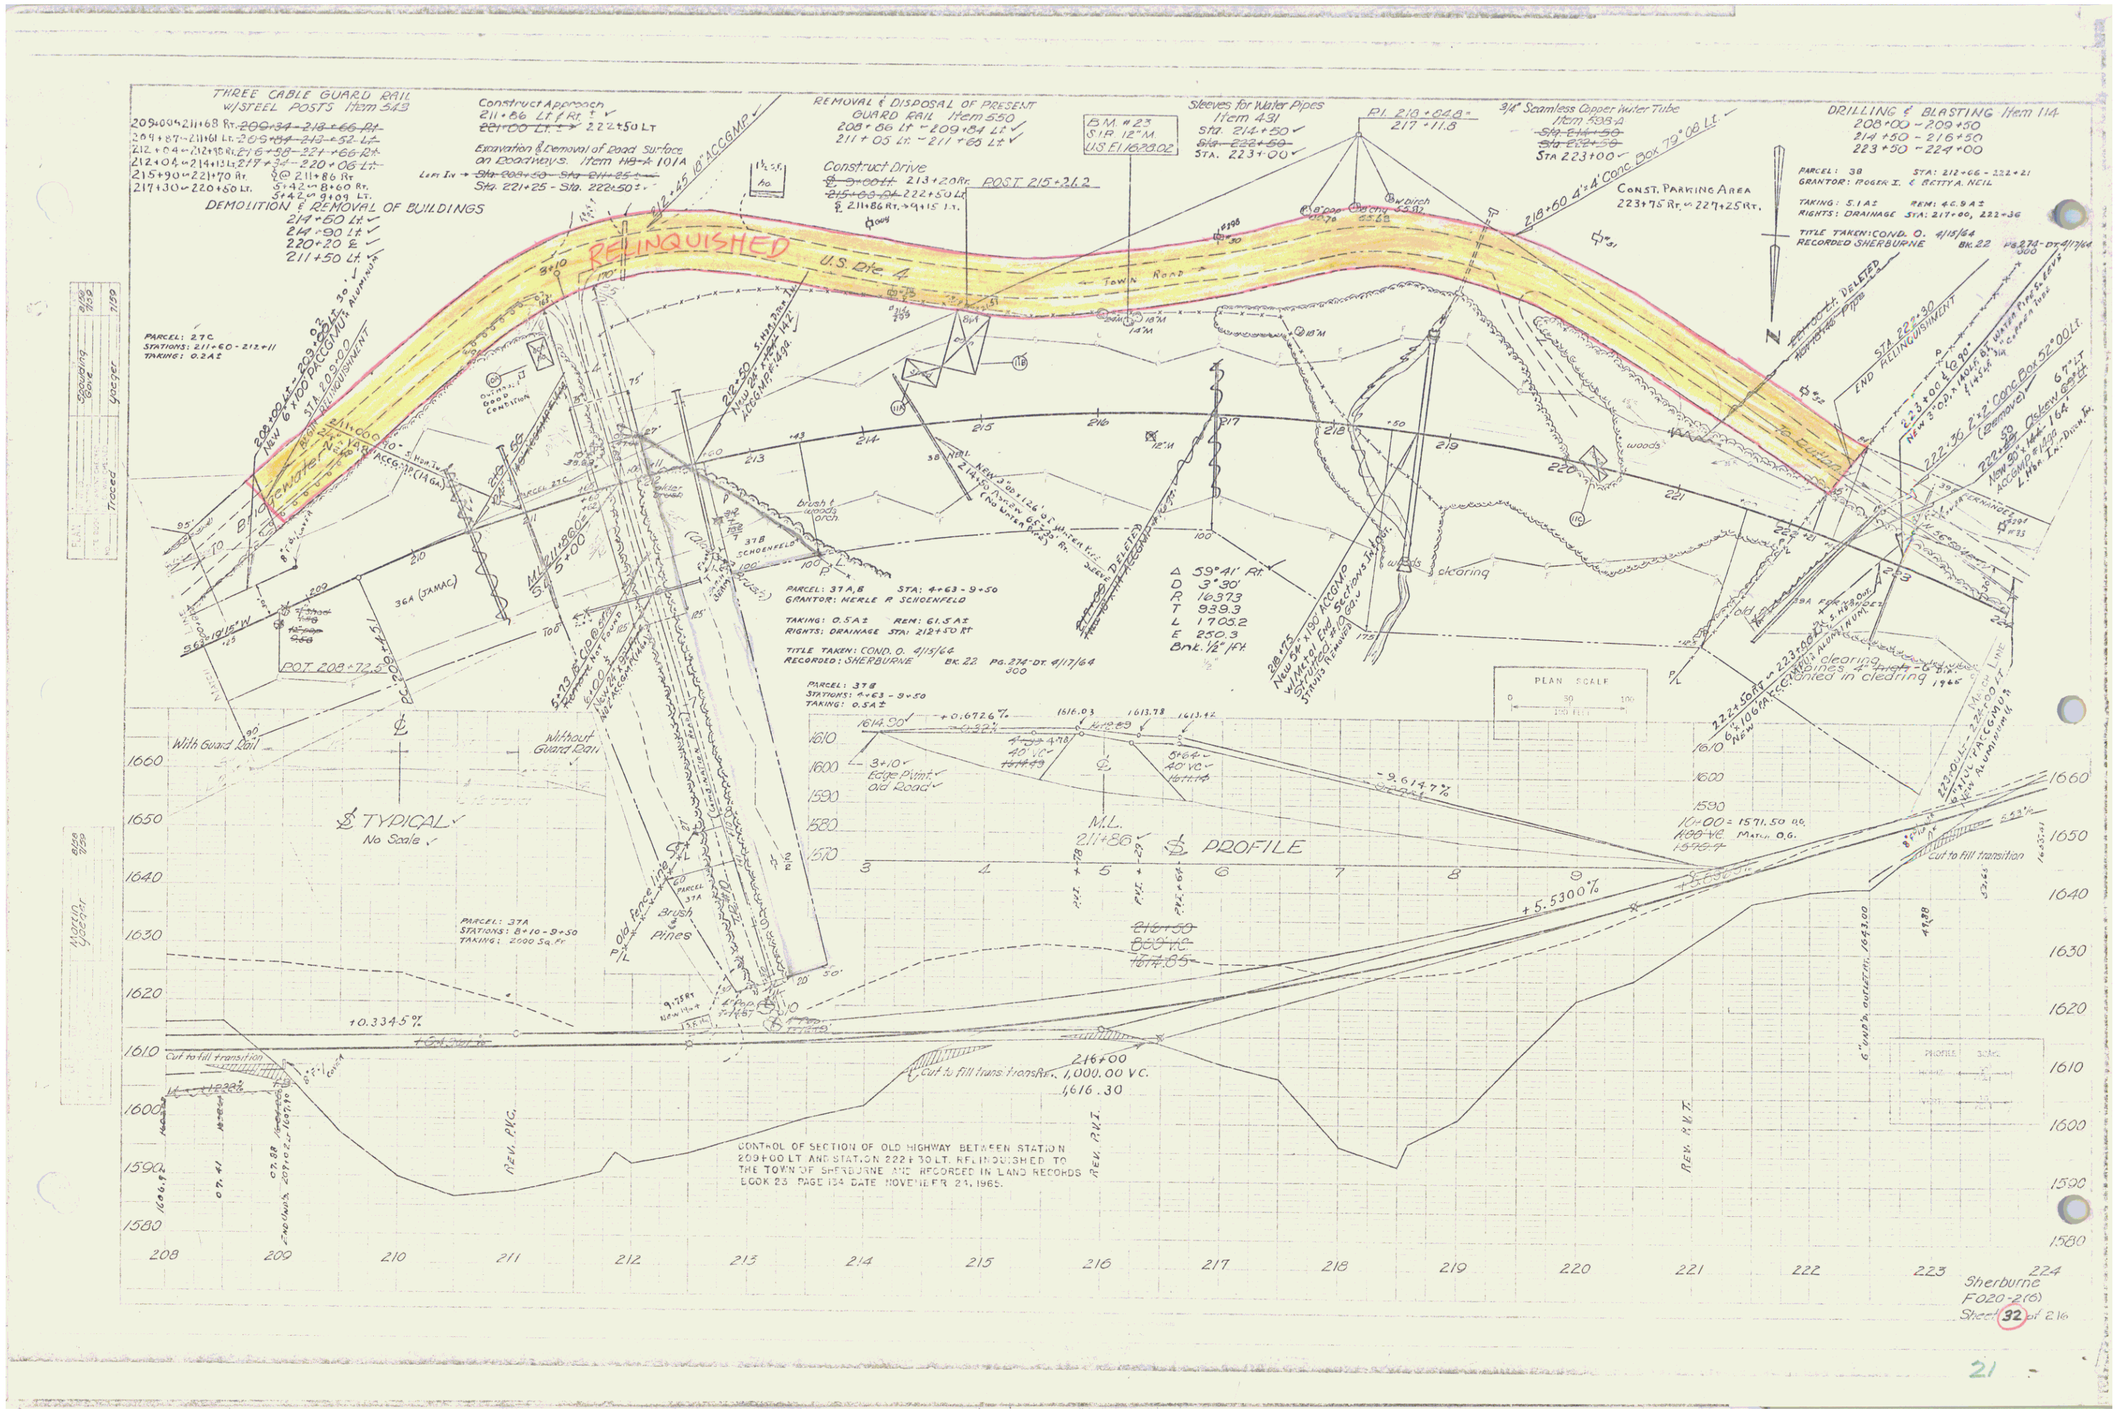
THREE CABLE GUARD RAIL W/STEEL POSTS Item 543
Construct Approach
Excavation & Removal of Road Surface on Approaches. Item 119-A 101A
DEMOLITION & REMOVAL OF BUILDINGS
REMOVAL & DISPOSAL OF PRESENT GUARD RAIL Item 550
Construct Drive
BM #23
Sleeves for Water Pipes Item 431
3/4" Seamless Copper Water Tube Item 503.A
DRILLING & BLASTING Item 114
CONST. PARKING AREA
RELINQUISHED
U.S. Rte. 4
TOWN ROAD
PARCEL: 2TC
STATIONS: 211+60 - 212+11
TAKING: 0.3 AC
PARCEL: 3B
GRANTOR: ROGER I. & BETTY A. NEIL
TAKING: 5.1 AC
RIGHTS: DRAINAGE
TITLE TAKEN: COND. O. 4/15/64
RECORDED SHERBURNE
PARCEL: 3TA, B
GRANTOR: NERLE R SCHOENFELD
TAKING: 0.5 AC
RIGHTS: DRAINAGE
TITLE TAKEN: COND. O. 4/15/64
RECORDED: SHERBURNE
Δ 59°41' Rt.
D 3°30'
R 1637.3
T 939.3
L 1700.2
E 250.3
Brk. 1/2" Ft.
PARCEL: 3TA
STATIONS: 8+10 - 9+50
TAKING: 2000 Sq. Ft.
With Guard Rail
Without Guard Rail
TYPICAL
No Scale
PROFILE
M.L. 211+86
POT 208+72.5
POT 215+26.2
+0.3345%
+5.5300%
-9.6147%
Cut to fill transition
CONTROL OF SECTION OF OLD HIGHWAY BETWEEN STATION 209+00 LT. AND STATION 222+30 LT. RELINQUISHED TO THE TOWN OF SHERBURNE AND RECORDED IN LAND RECORDS BOOK 23 PAGE 134 DATE NOVEMBER 24, 1965.
Sherburne
F020-2(6)
Sheet 32 of 216

21