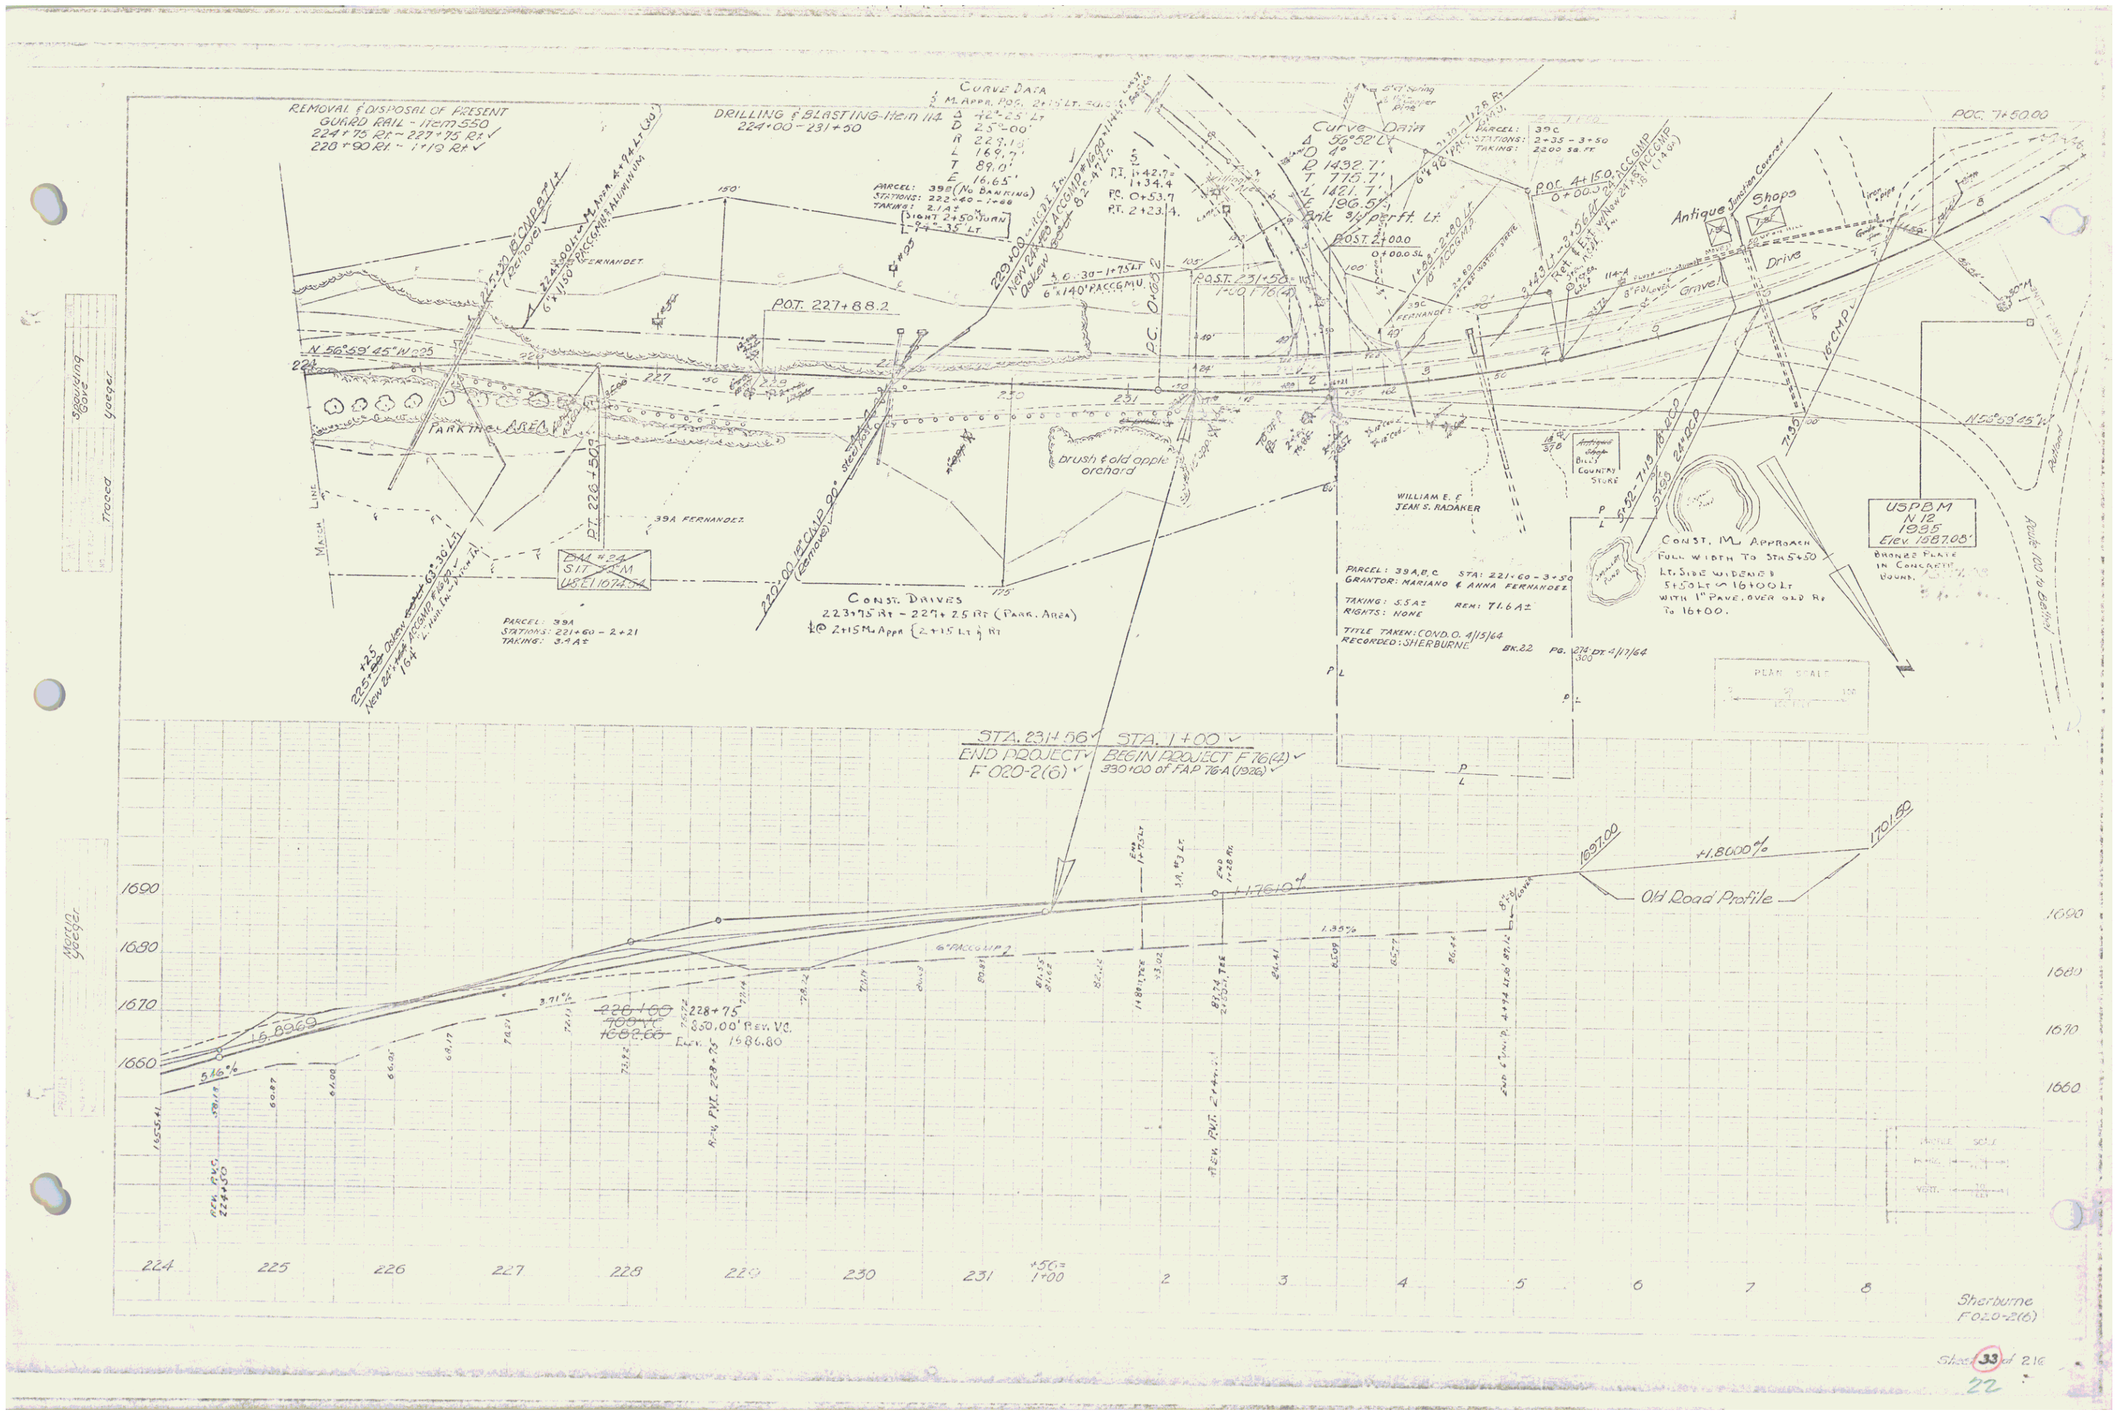
REMOVAL & DISPOSAL OF PRESENT GUARD RAIL - Item 550
224+75 Rt - 227+75 Rt
228+90 Rt - 1+19 Rt
DRILLING & BLASTING - Item 114
224+00 - 231+50
Curve Data
Curve Data
POT. 227+88.2
PARK THE AREA
brush & old apple orchard
WILLIAM E. & JEAN S. RADAKER
Antique Shops
Drive
Gravel
Country Store
CONST. DRIVES
223+75 Rt - 227+25 Rt (Park. Area)
CONST. M. APPROACH
STA. 231+56 END PROJECT F 020-2(6)
STA. 1+00 BEGIN PROJECT F 76(4)
Old Road Profile
+1.8000%
Sherburne F020-2(6)
Sheet 33 of 216
22