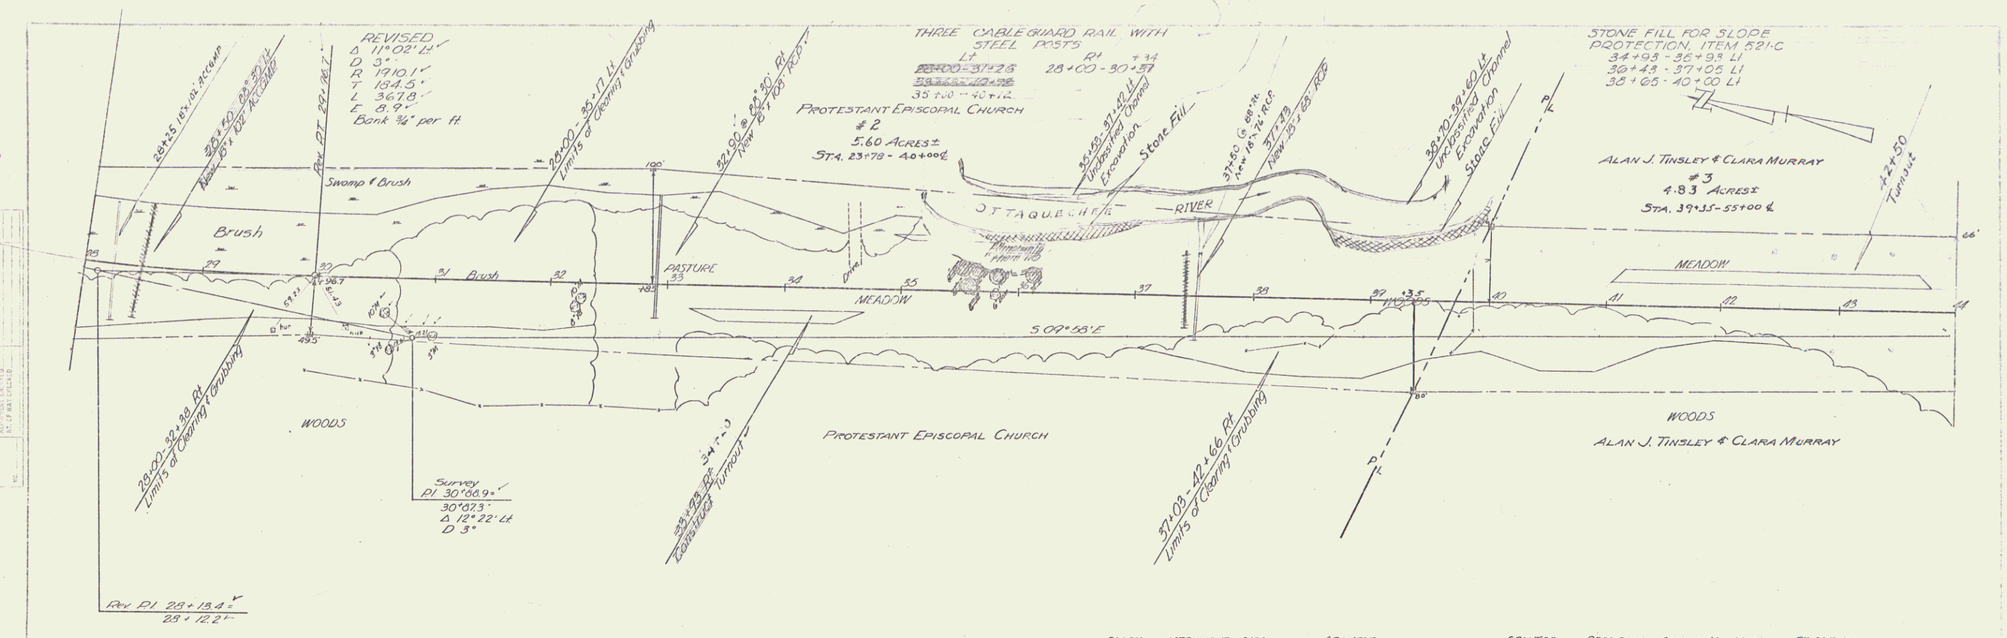

PARCEL	INSTRUMENT	DATE	GRANTOR	GRANTEE	RECORDED	BOOK	PAGE	DATE	REMARKS
2	Cond.	1-27-55	Trustees of the Diocese of Vermont Protestant Episcopal Church	St. of Vt.	Sherburne	18	324-328	1-29-55	See also sheet 10
3	Cond.	1-27-55	Alan J. Tinsley & Clara Murray	St. of Vt.	Sherburne	18	324-328	1-29-55	See also sheet 12 & 13

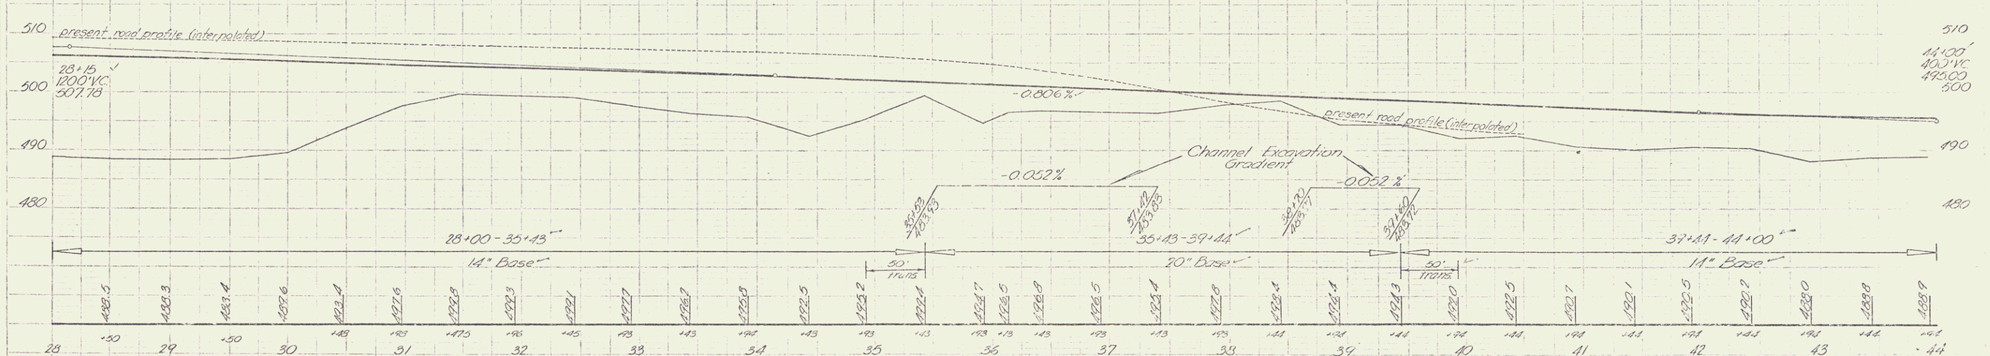

SHERBURNE
F 10(3)
Sheet 11 of 62

4