1 TITLE SHEET
2-10 TYPICAL SECTIONS
11-16 DETAIL SHEETS
17-39 PLAN SHEETS
40-69 PROFILE SHEETS
A-G CRONAFLEX SHEETS

STATE OF VERMONT
DEPARTMENT OF HIGHWAYS

PROPOSED IMPROVEMENT

ARTERIAL PROJECT

TOWN OF FAIR HAVEN
COUNTY OF RUTLAND
U.S. ROUTE 4

RIGHT OF WAY PLANS

Beginning at a point on the New York - Vermont State Line, and proceeding easterly 3.535 miles.

LENGTH OF PROJECT: 18,845.00 FEET, 3.535 MILES

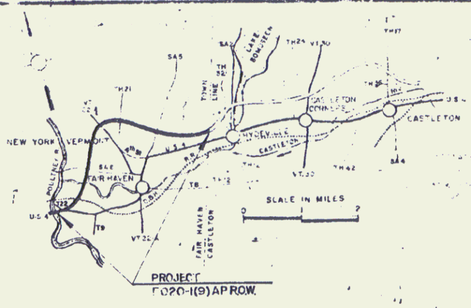

PROJECT F020-1(9) AP ROW

TRAFFIC DATA				
1965	ADT	3600	3800	2600
1985	ADT	6200	6500	4500
1985	DHV	870	910	620
	D	52%	55%	52%
	T	8%	7%	9%
	V	60 MPH	60 MPH	60 MPH

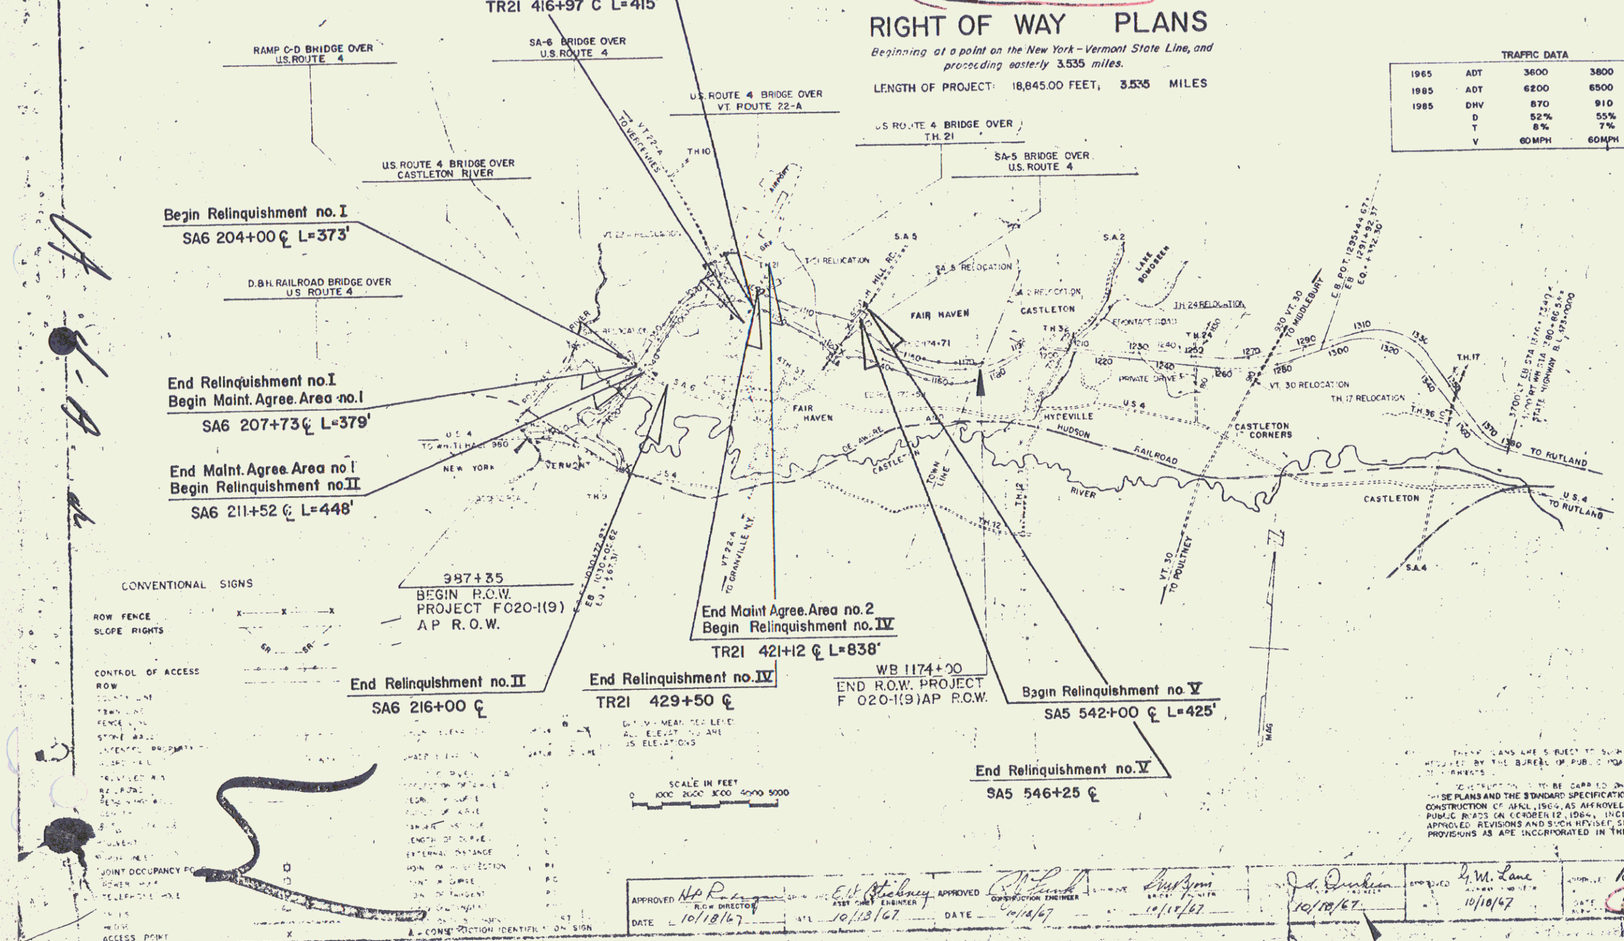

CONVENTIONAL SIGNS

ROW FENCE
SLOPE RIGHTS
CONTROL OF ACCESS ROW
JOINT OCCUPANCY
ACCESS POINT
A - CONSTRUCTION IDENTIFICATION SIGN

MP 0.00-3.81

FEB 25 1980

REQUIRED NUMBER OF FEDERAL AID CONSTRUCTION IDENTIFICATION SIGNS 7 EACH.

Pin #99R208

THESE PLANS ARE SUBJECT TO SUCH REVISIONS AS MAY BE MADE BY THE BUREAU OF PUBLIC ROADS OR THE COMMISSIONER OF HIGHWAYS.

CONSTRUCTION TO BE CARRIED ON IN ACCORDANCE WITH THESE PLANS AND THE STANDARD SPECIFICATIONS FOR HIGHWAY AND BRIDGE CONSTRUCTION OF APRIL, 1960, AS APPROVED BY THE BUREAU OF PUBLIC ROADS ON OCTOBER 12, 1964, INCLUDING ALL SUBSEQUENT APPROVED REVISIONS AND SUCH REVISED SPECIFICATIONS AND SPECIAL PROVISIONS AS ARE INCORPORATED IN THESE PLANS.

DEPARTMENT OF COMMERCE
BUREAU OF PUBLIC ROADS

APPROVED N.A. Rainey R.O.W. DIRECTOR	E.H. Blakney ASST. CHIEF ENGINEER	APPROVED R.W. Lunk CONSTRUCTION ENGINEER	Gus Gross ASST. ENGINEER	J. Durkin ENGINEER	G.W. Lane ASSIST. ENGINEER	R.H. Arnold CHIEF ENGINEER	PROJECT F NO. 020-1(9) AP ROW
DATE 10/18/67	DATE 10/18/67	DATE 10/18/67	10/18/67	10/18/67	10/18/67	DATE 10/31/67	SHEET 1 OF 69 SHEETS