CONSTRUCT SPEED CHANGE LANE (Incl. Taper)		
STATION	STATION	POS
EB 1059+29	1062+79	RT
WB 1055+28.75	1058+28.75	LT

DEMOLITION AND DISPOSAL OF BUILDING ITEM 586	
STATION	POS
RAMP H 29+25	RT

PROPERTY LINE FENCE WITH STEEL POSTS ITEM 583-II MOD			
STATION	POS	STATION	POS
WB 1059+00	LT	WB 1059+00	RT
EB 1059+00	RT	WB L 7+00	LT

CONSTRUCT RAMPS		
STATION	STATION	RAMP
2+00	7+00	E
25+18	31+00	H

* GRANITE SLOPE EDGING ITEM 556-A		
STATION	STATION	POS
EB 1055+30.0	1055+06.0	RT
RAMP E 4+49.5	RAMP E 5+30.0	LT

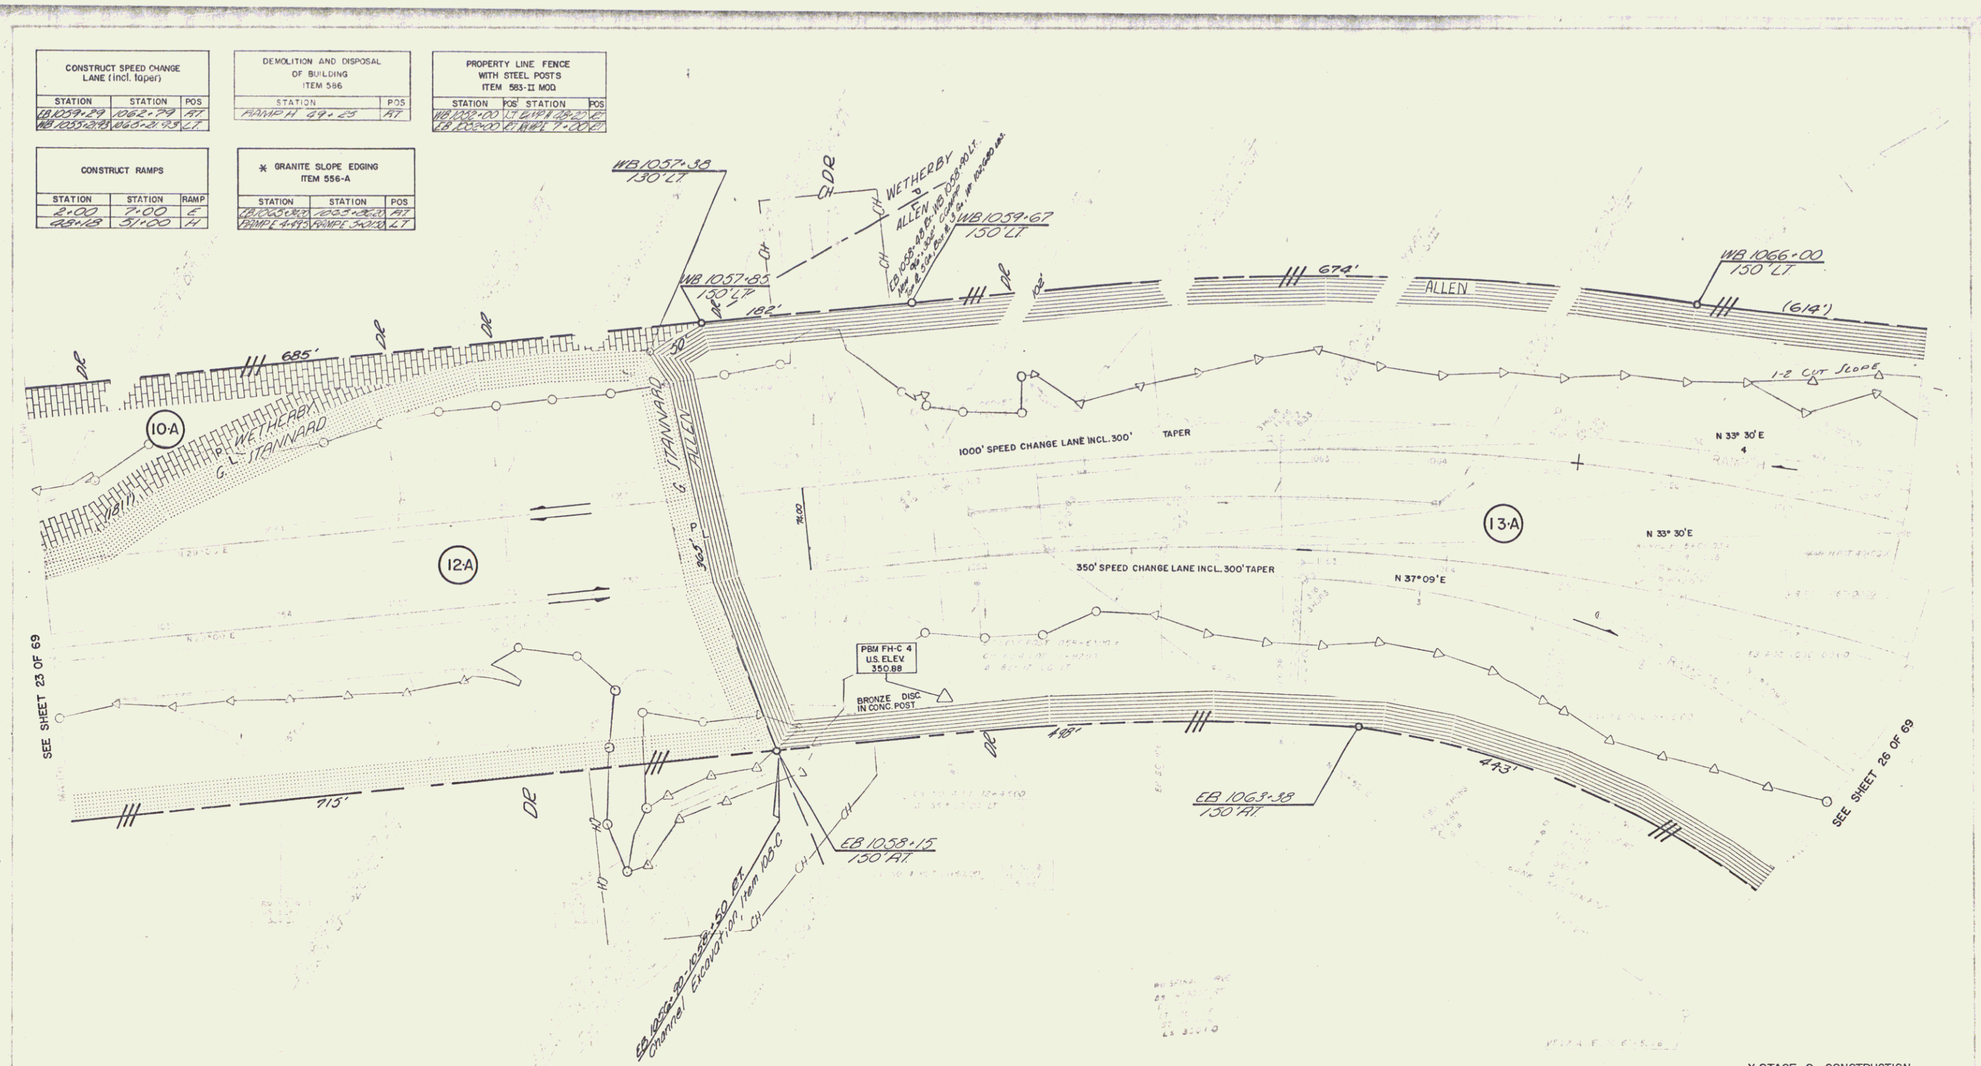

* STAGE 2 CONSTRUCTION

CONTROL OF ACCESS COMPLETE ON THIS SHEET.

JO F 020-1(9)AP ROW

AMM RAS

25

APRIL 1967

69