PROPERTY LINE FENCE WITH STEEL POSTS ITEM 583-□ MOD.			
STATION	POS	STATION	POS
EB 6 68+00	LT	WB 1091+28.38	LT
WB 1091+32	LT	1100+00	LT
EB 1089+80	LT	61+07	LT
EB 1089.52	LT	61+07	LT

CHAIN LINK FENCE 6' HIGH		
STATION	STATION	POS
EB 1089+22	EB 1089+72	LT
EB 1087+92	1088+03	LT

CONSTRUCT RAMP		
STATION	STATION	RAMP
60+85	21+00	F
60+00	69+30	G

CONSTRUCT SPEED CHANGE LANE (INCL. TAPER)		
STATION	STATION	POS
EB 1089+29.9	1089+77	RT
WB 1089+25	1100+00	LT

* GRANITE SLOPE EDGING ITEM 556-A		
STATION	STATION	POS
WB 1089+1	1089+33	LT
G 60+15	65+70	LT

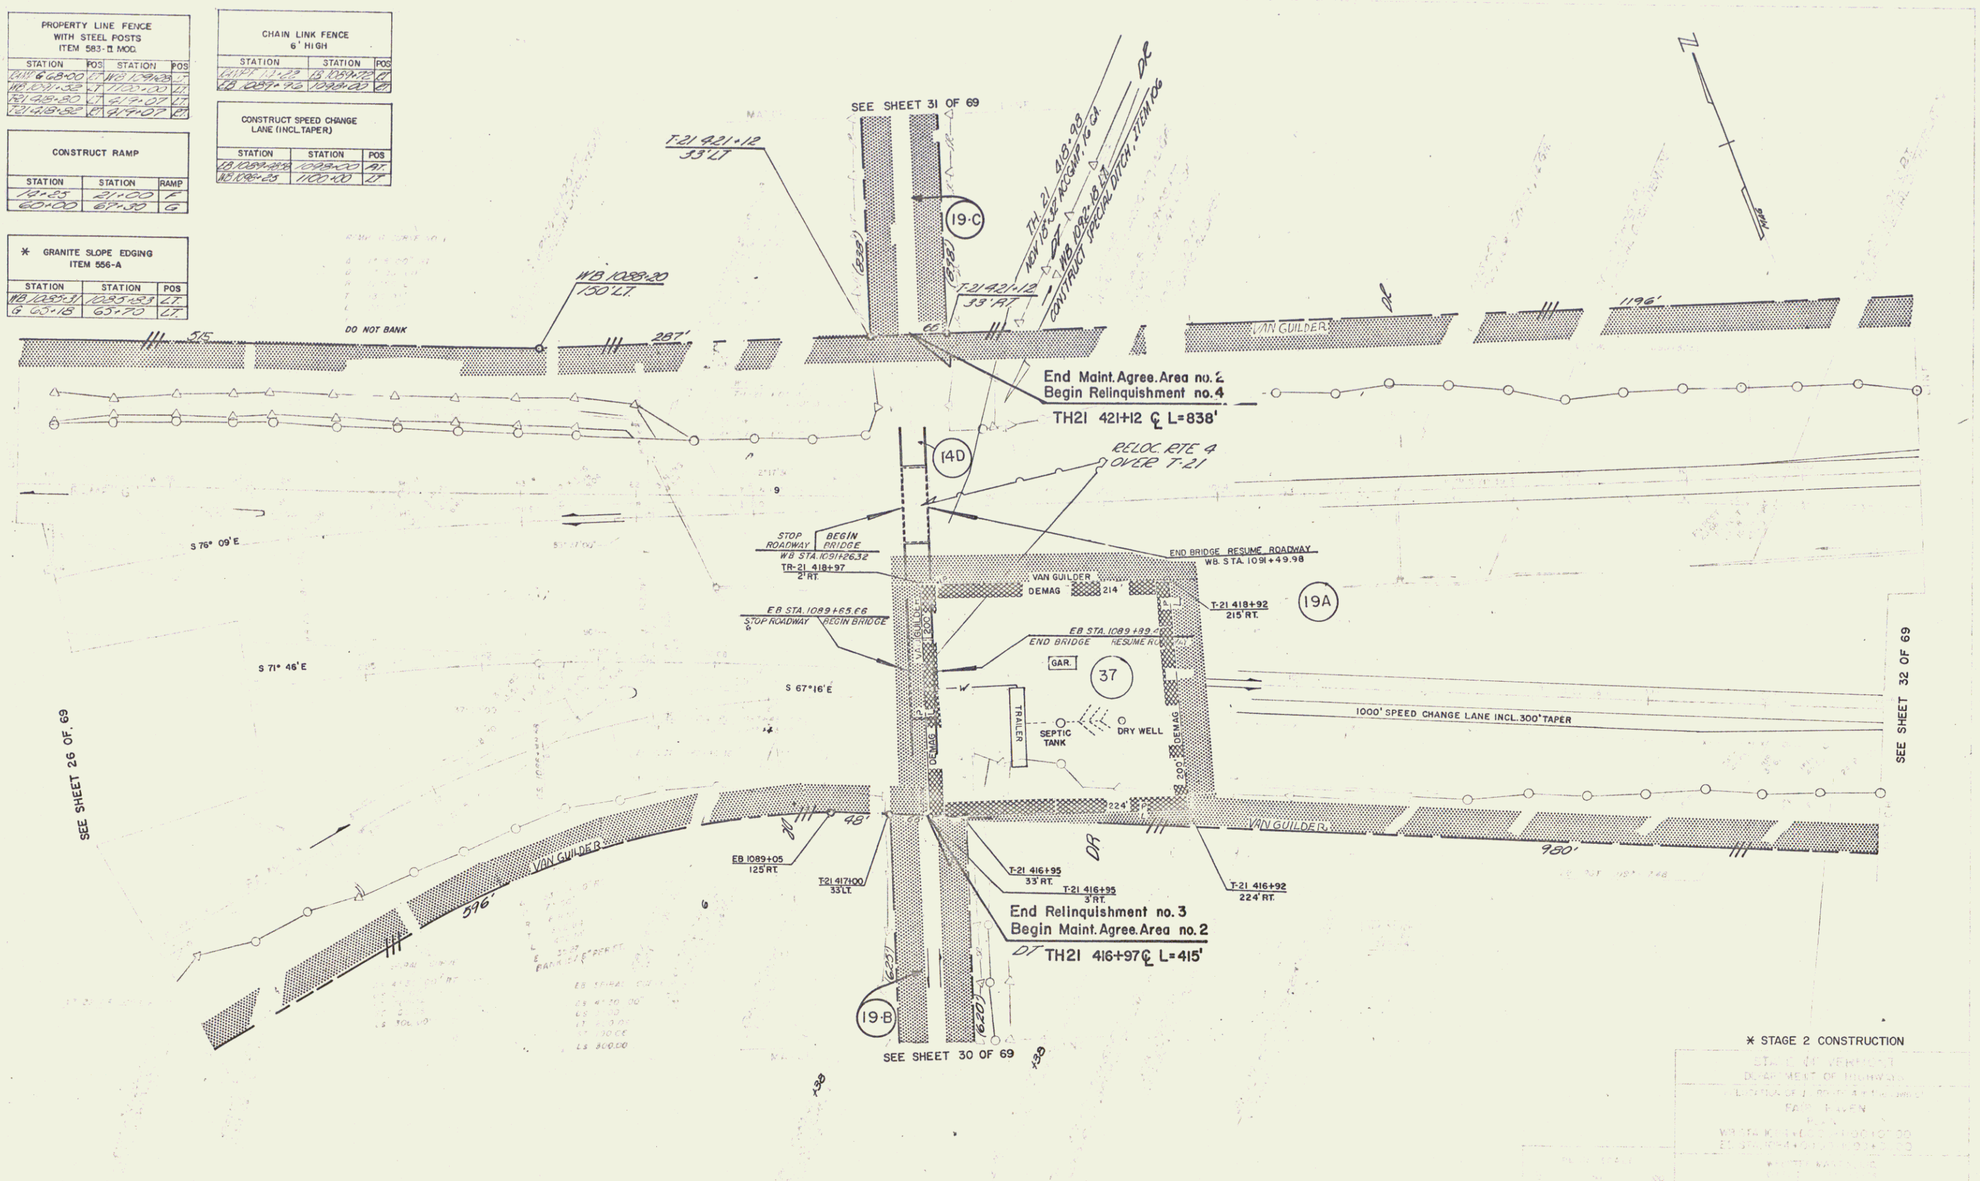

* STAGE 2 CONSTRUCTION

CONTROL OF ACCESS COMPLETE ON THIS SHEET

JO F020-1(9)AP ROW | AMM RAS | 29 | APRIL 1967 | 69

15