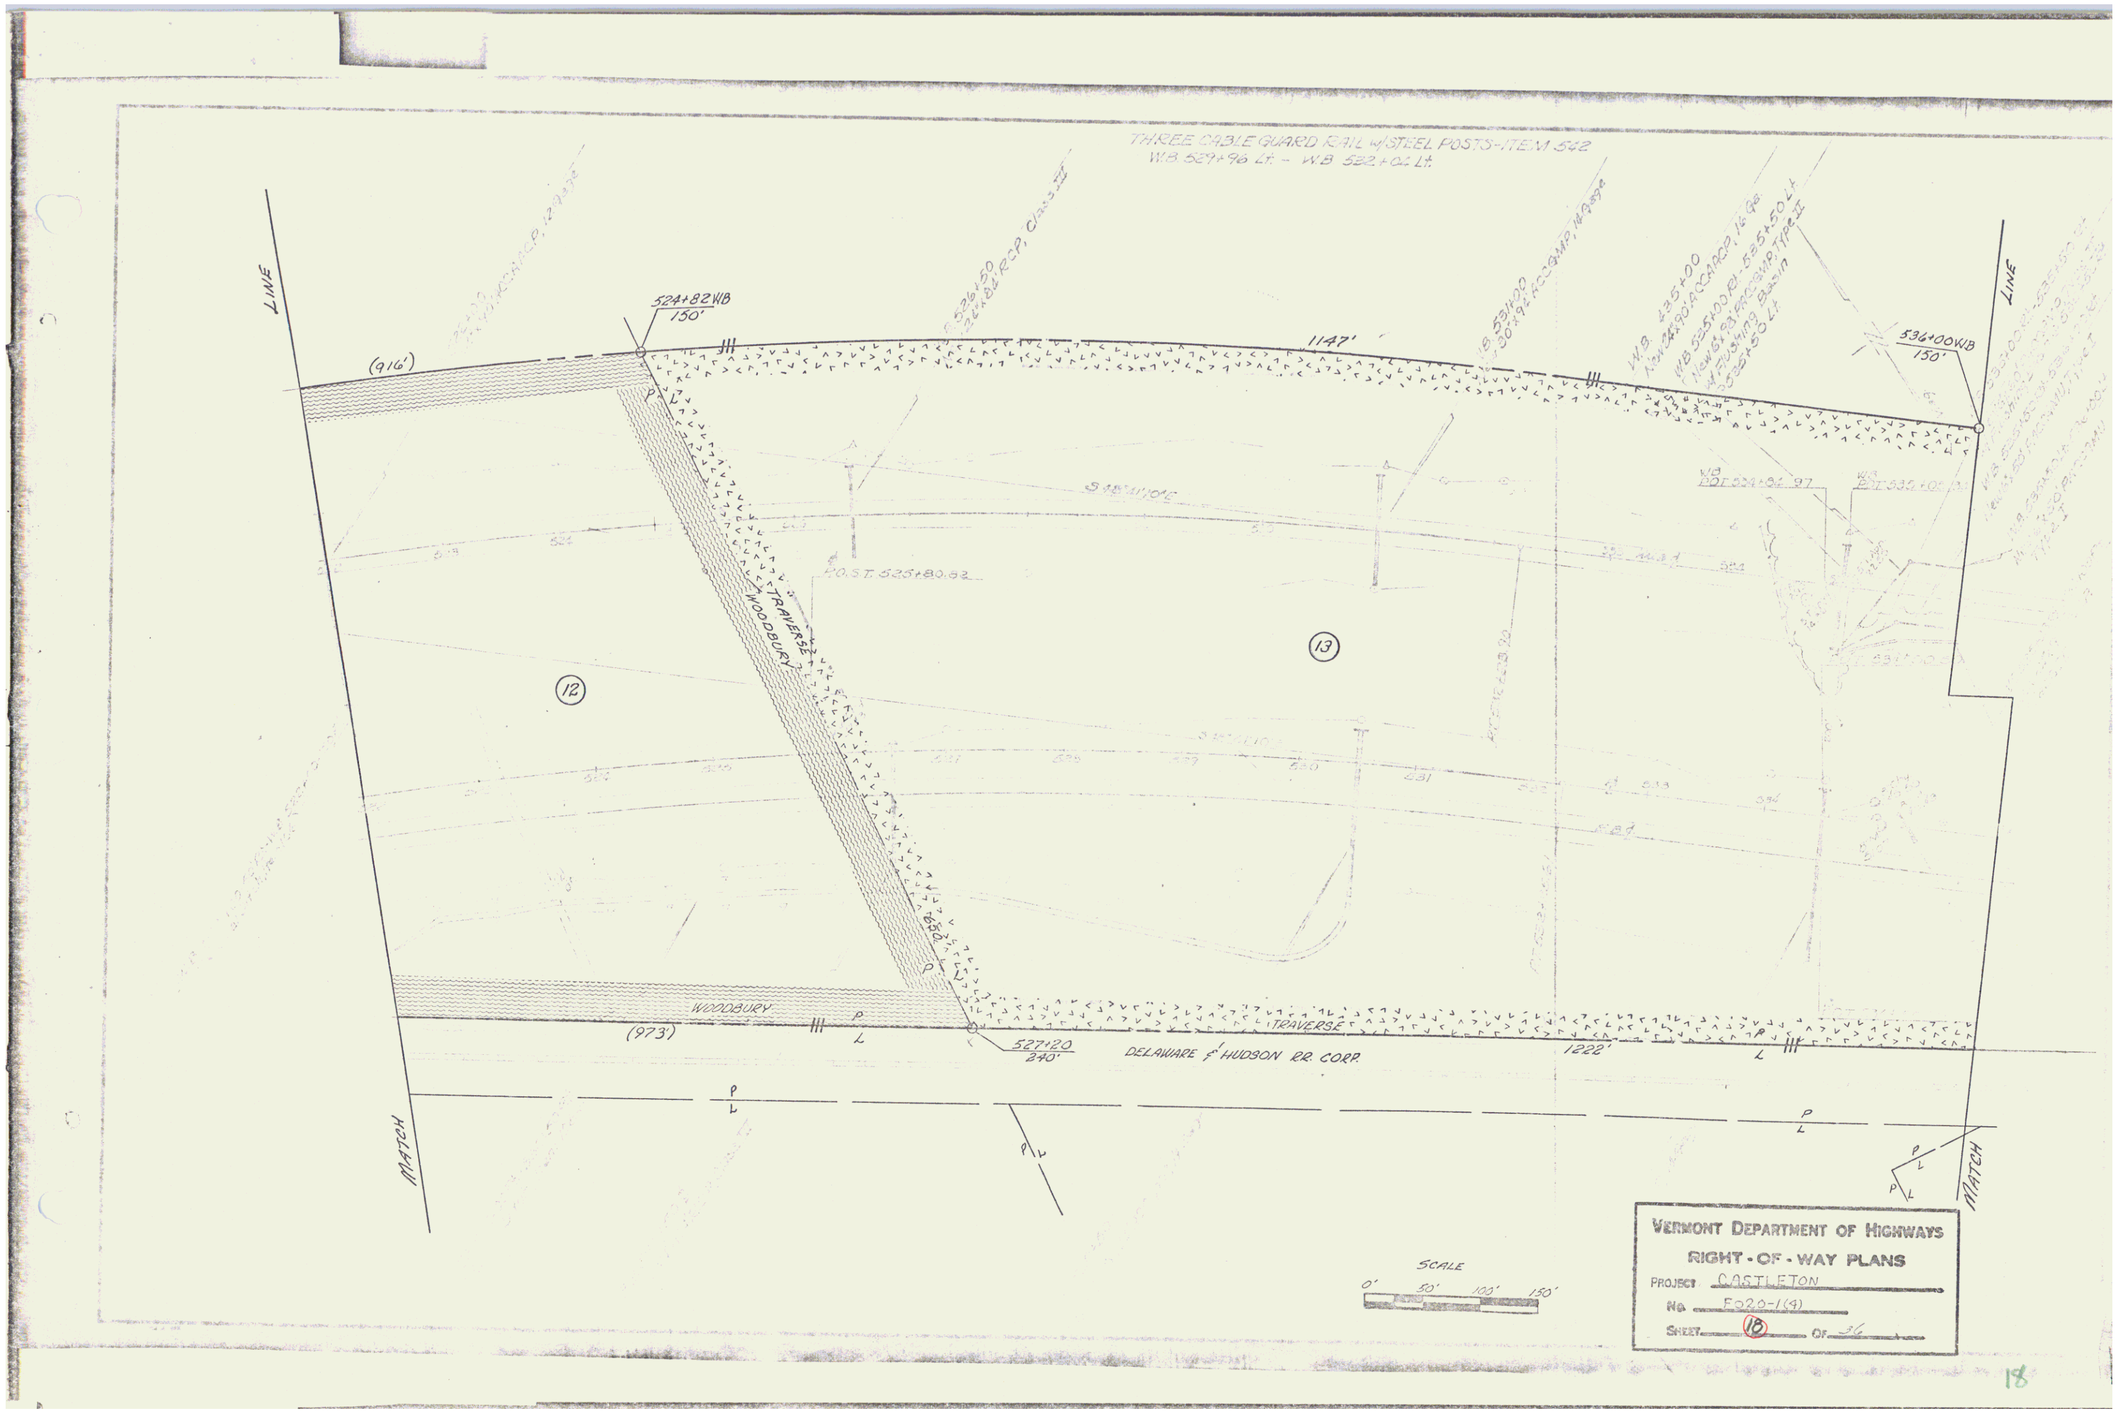
THREE CABLE GUARD RAIL w/STEEL POSTS-ITEM 542
W.B. 529+96 Lt. - W.B. 522+02 Lt.
LINE
524+82 WB
150'
(916')
1147'
536+00 WB
150'
LINE
WOODBURY
TRAVERSE
(12)
(13)
WOODBURY
(973')
527+20
240'
DELAWARE & HUDSON R.R. CORP.
TRAVERSE
1222'
MATCH
MATCH
SCALE
0' 50' 100' 150'
VERMONT DEPARTMENT OF HIGHWAYS
RIGHT-OF-WAY PLANS
PROJECT CASTLETON
No. F020-1(4)
SHEET 18 OF 36

18