


PLAN	NO.	DATE


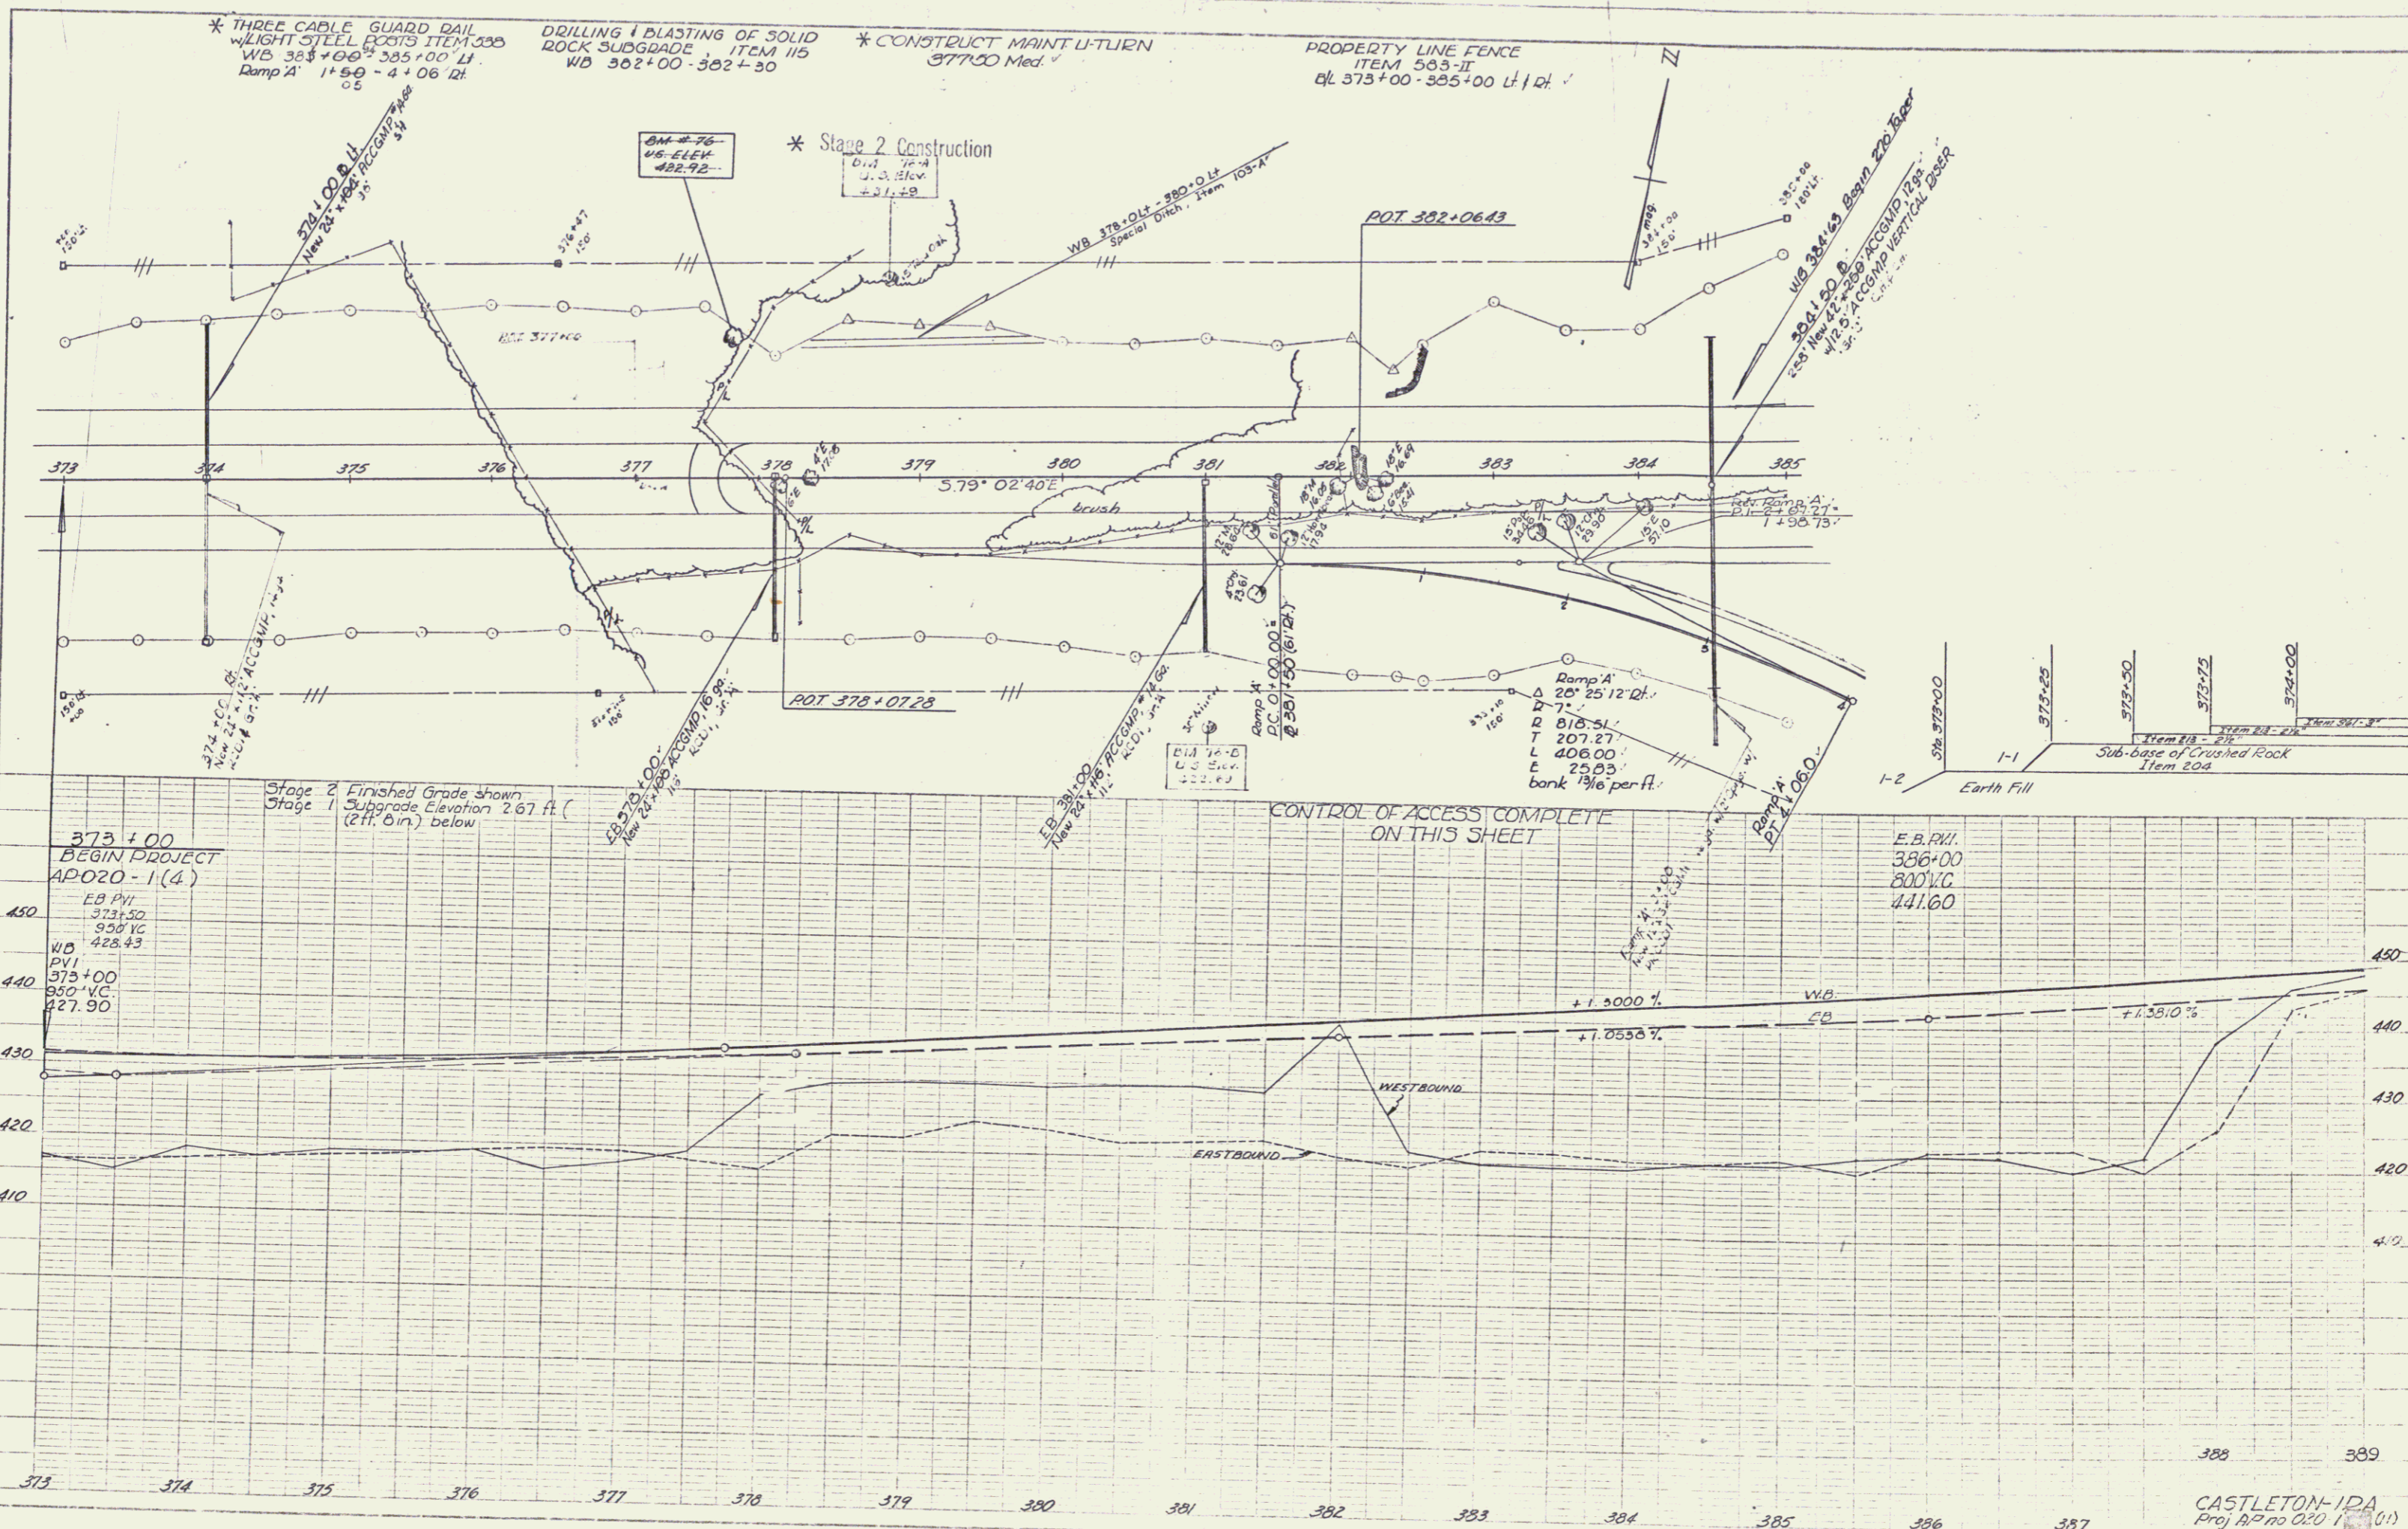

* THREE CABLE GUARD RAIL
W/ LIGHT STEEL FLOOR ITEM 338
WB 383+00 - 385+00 Lt.
Ramp A' 1' 5.0" - 4' 0.6" Lt.

DRILLING & BLASTING OF SOLID
ROCK SUBGRADE ITEM 115
WD 382+00 - 382+30

* CONSTRUCT MAINT U-TURN
37700 Med.


PROPERTY LINE FENCE
ITEM 583-II
CL 373+00 - 385+00 Lt. | Rt.

* Stage 2 Construction

373+00
BEGIN PROJECT
APOZO - 1(4)

EB PVI
373+50
950'VC
428.45
WD
373+00
850'VC
427.90

E.B.PVI
386+00
800'VC
441.60

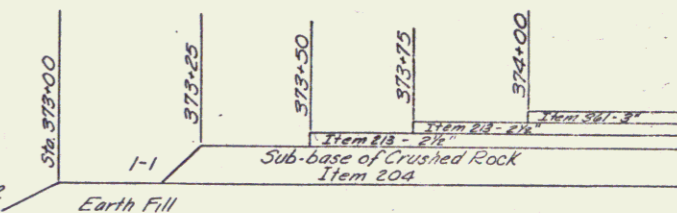

CONTROL OF ACCESS COMPLETE
ON THIS SHEET

CASTLETON-IDA
Proj AP no 020 (01)
Sheet 25 of 301
Sheet 49 of 170 Sheets

Stage 2 Construction