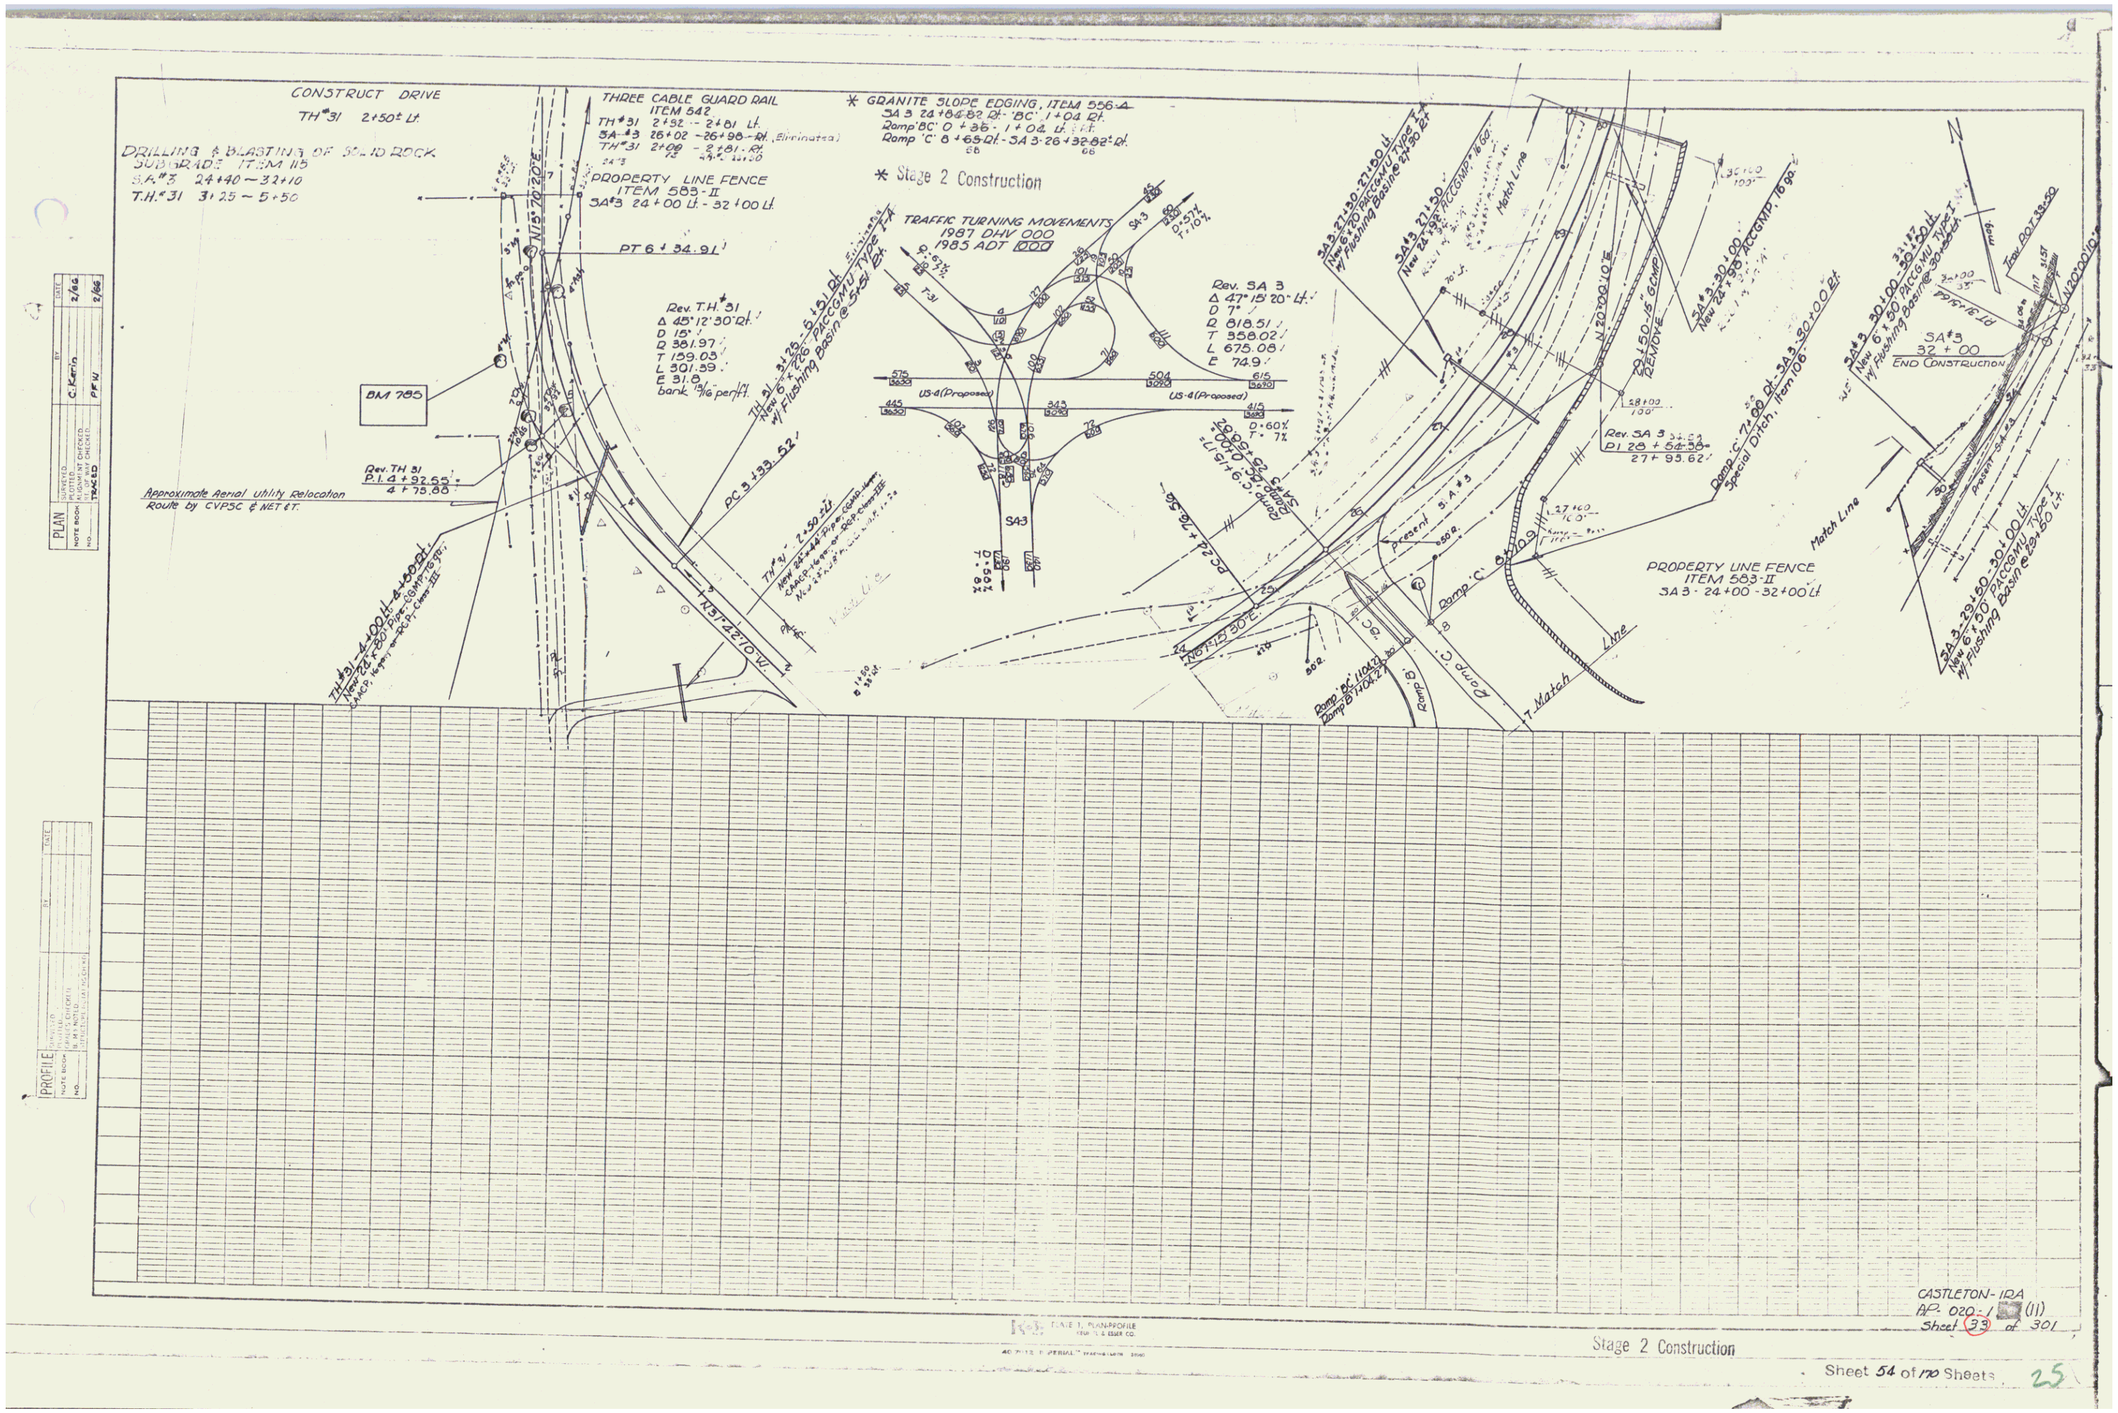

PLAN — SURVEYED / PLOTTED / ALIGNMENT CHECKED / QUANTITIES CHECKED — DATE 2/86 — C. Kerin — PFW — TRACED

PROFILE — PROFILED / PLOTTED / GRADES CHECKED / QUANTITIES CALCULATED — DATE

CASTLETON-IRA
AP. 020-1 (11)
Sheet 33 of 301

Stage 2 Construction

Sheet 54 of 170 Sheets

25