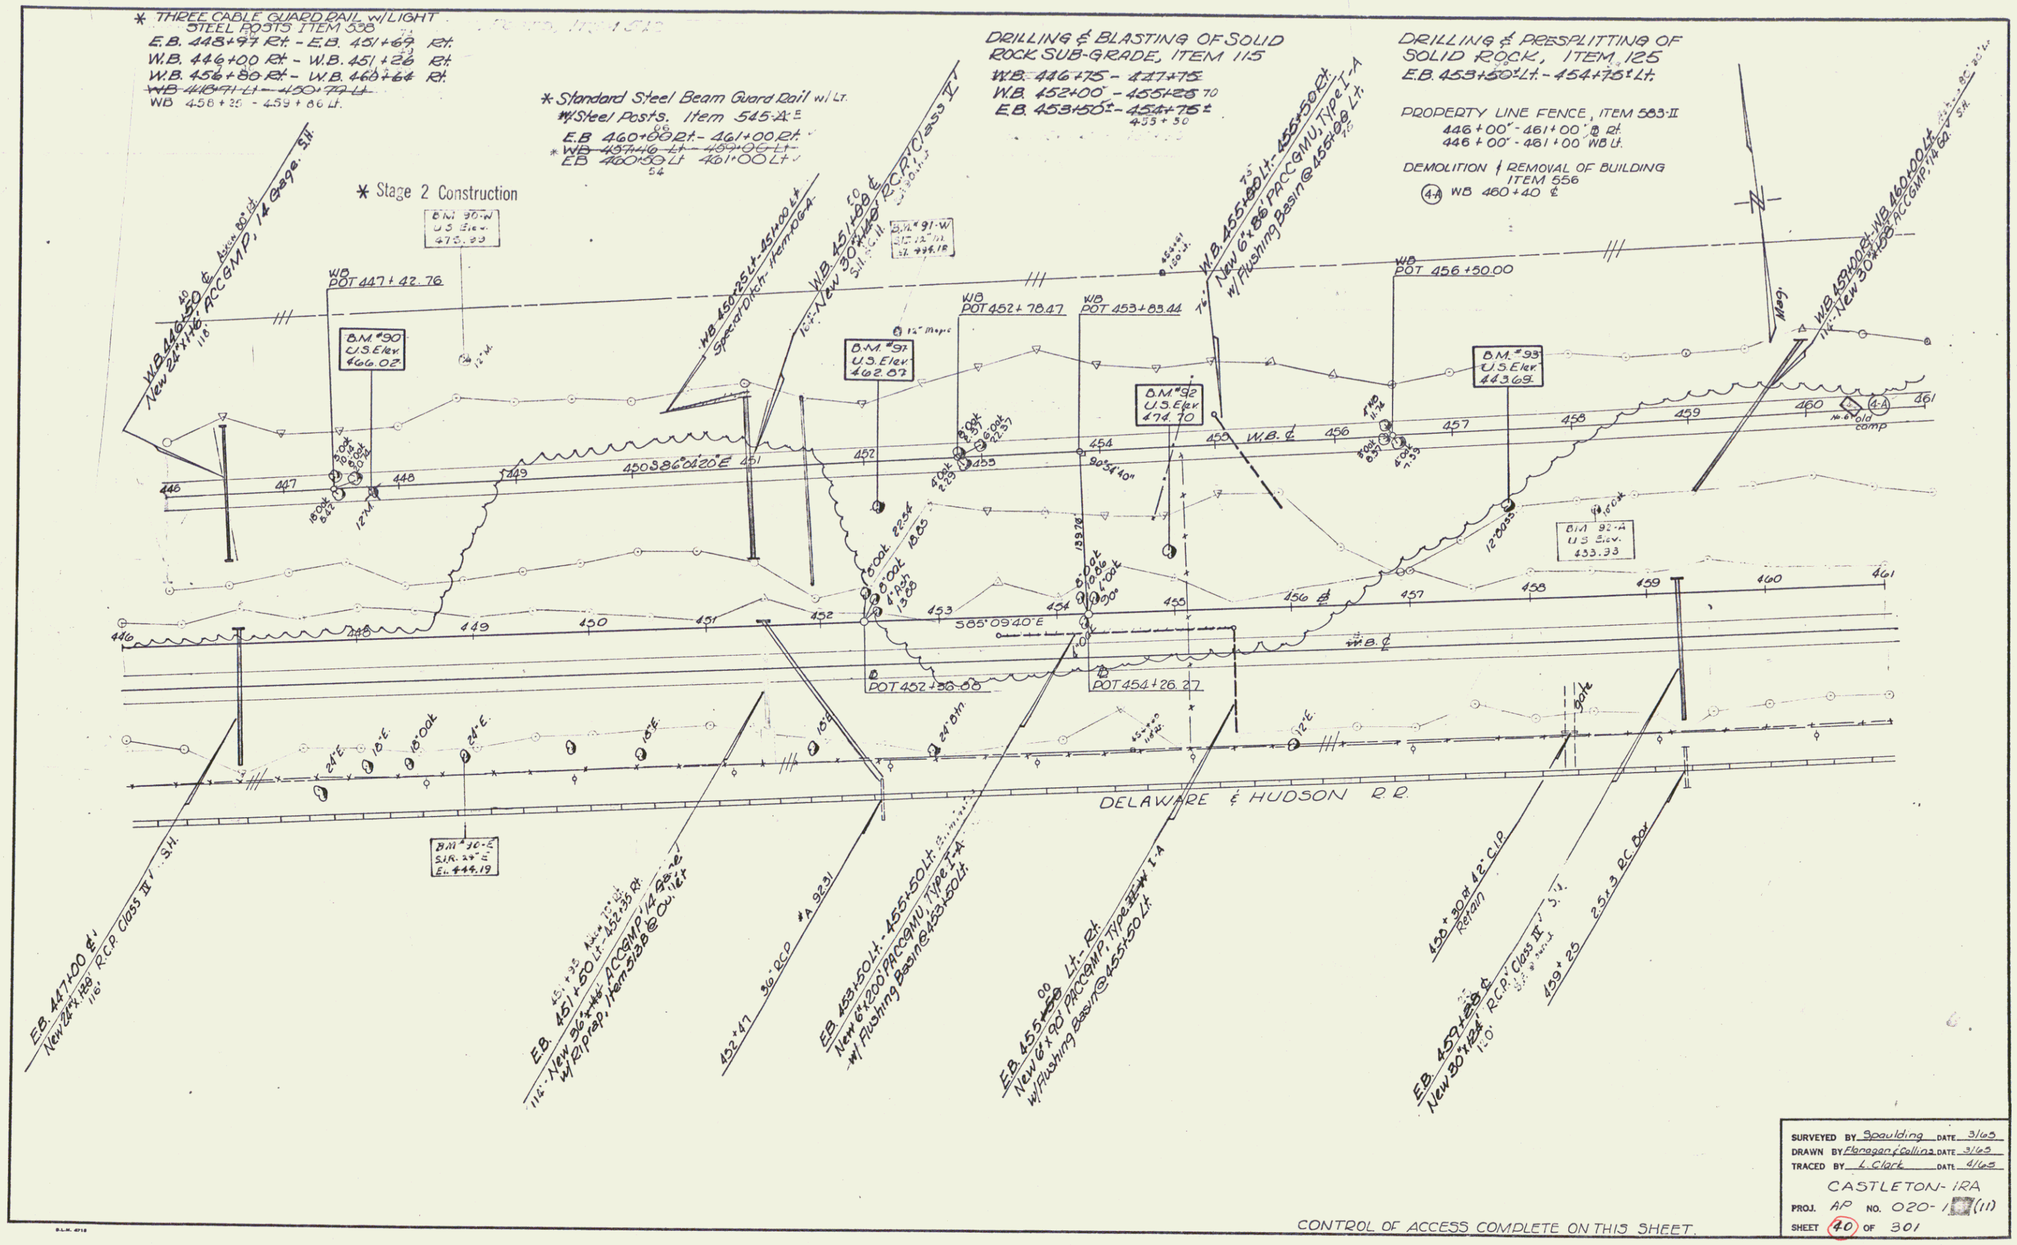

Stage 2 Construction


29