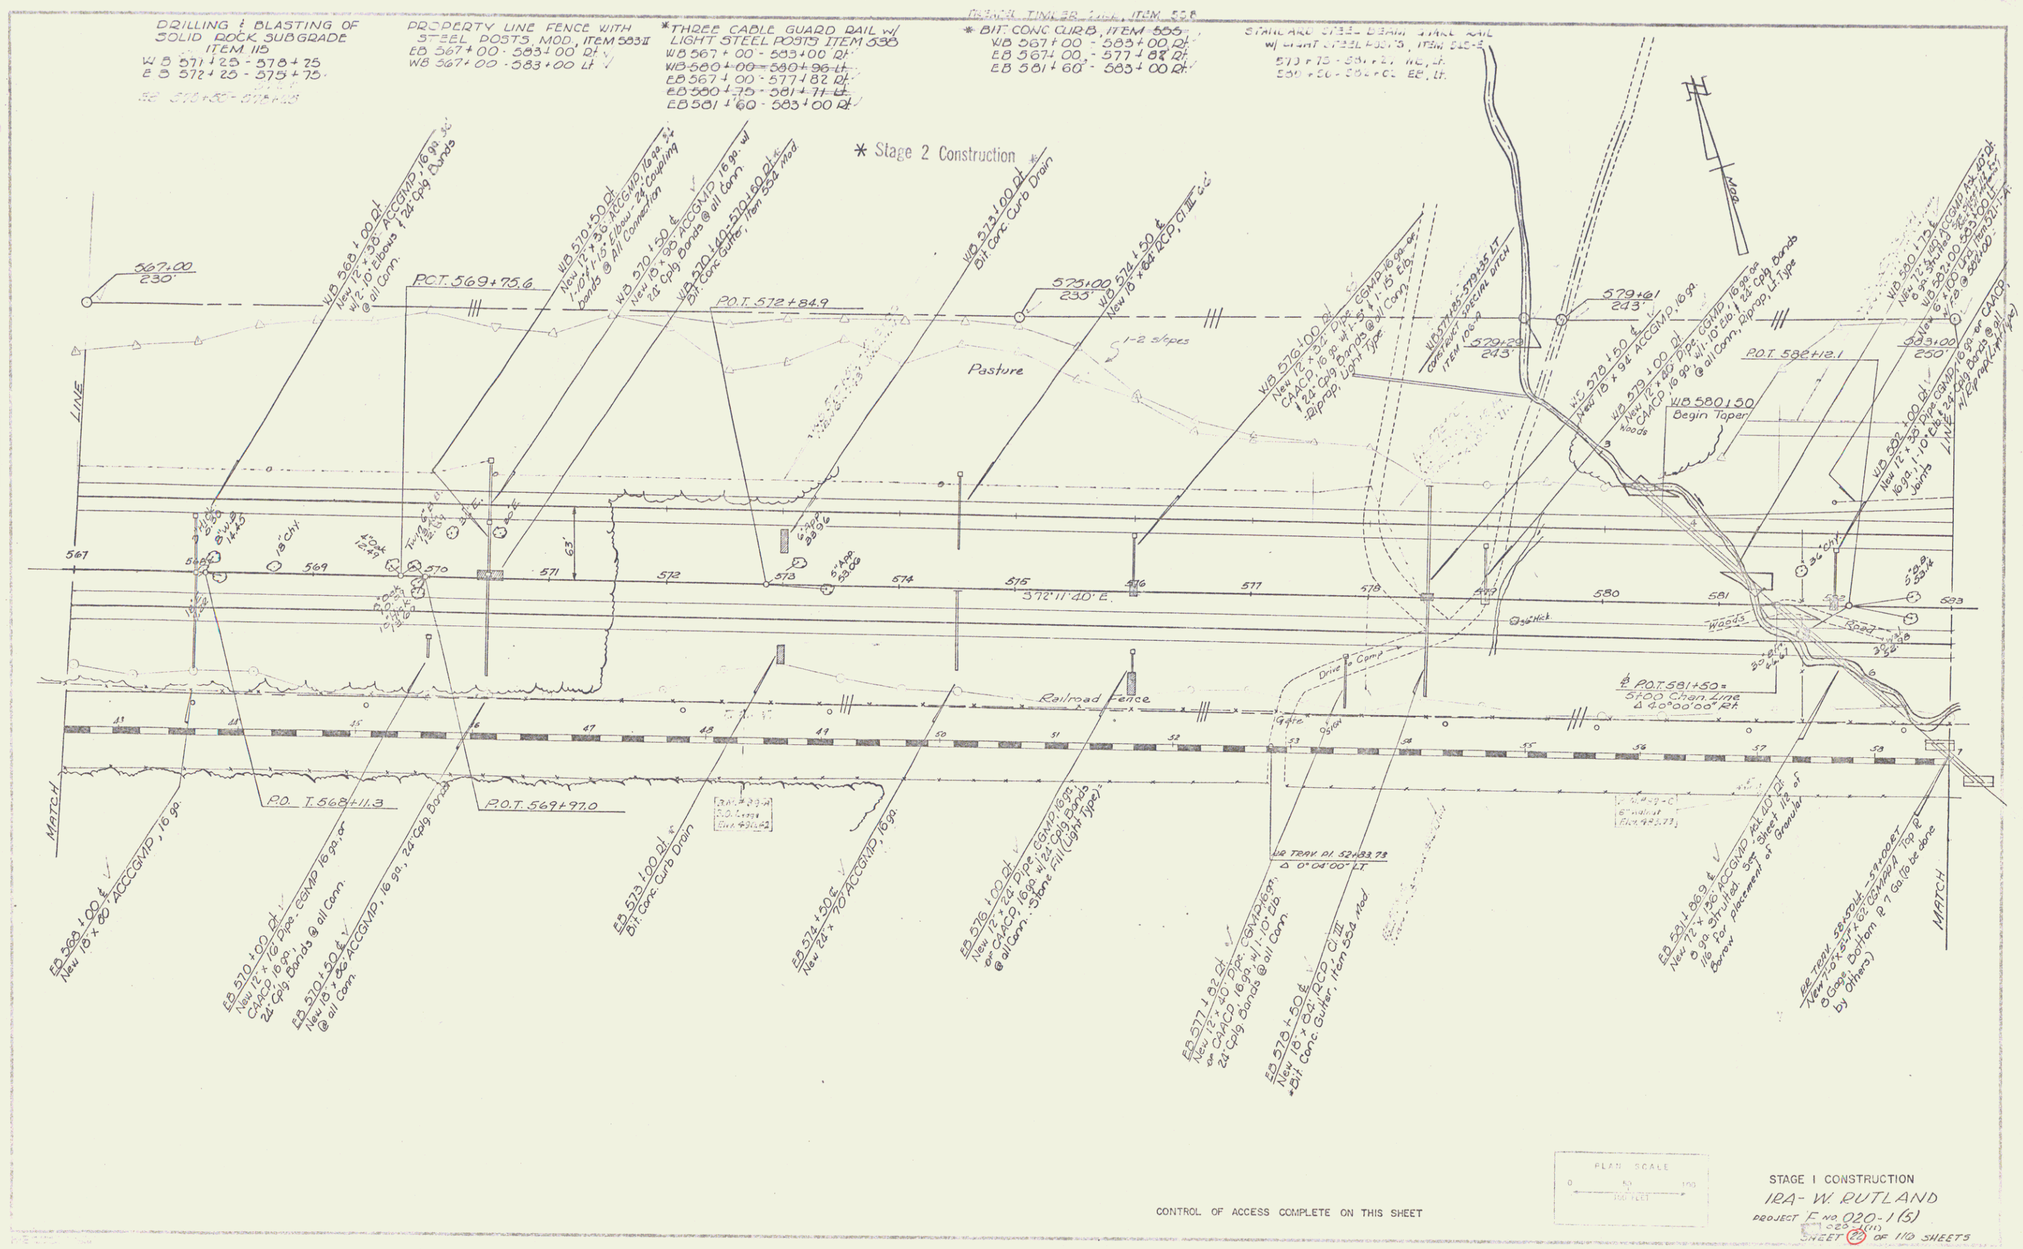
DRILLING & BLASTING OF SOLID ROCK SUBGRADE ITEM 115
WB 571+25 - 578+75
EB 572+25 - 575+75
PROPERTY LINE FENCE WITH STEEL POSTS, MOD., ITEM 583II
EB 567+00 - 583+00 Rt.
WB 567+00 - 583+00 Lt.
*THREE CABLE GUARD RAIL w/ LIGHT STEEL POSTS ITEM 538
WB 567+00 - 583+00 Rt.
WB 580+00 - 580+96 Lt.
EB 567+00 - 577+82 Rt.
EB 580+75 - 581+71 Lt.
EB 581+60 - 583+00 Rt.
* BIT. CONC. CURB, ITEM 555
WB 567+00 - 583+00 Rt.
EB 567+00 - 577+82 Rt.
EB 581+60 - 583+00 Rt.
* Stage 2 Construction
567+00
230'
P.O.T. 569+75.6
P.O.T. 572+84.9
575+00
235'
579+61
243'
579+29
243
P.O.T. 582+12.1
583+00
250'
WB 580+50
Begin Taper
Pasture
1-2 s/pes
Railroad Fence
Drive & Comp
Woods
Gate
P.O.T. 581+50 =
5700 Chain Line
Δ 40°00'00" Rt.
S72°11'40"E.
MATCH
P.O.T. 568+11.3
P.O.T. 569+97.0
LINE
CONTROL OF ACCESS COMPLETE ON THIS SHEET
PLAN SCALE
STAGE I CONSTRUCTION
IRA- W. RUTLAND
PROJECT F NO 020-1(5)
SHEET 77 OF 110 SHEETS