PROPERTY LINE FENCE WITH STEEL POSTS, MOD., ITEM 5E 3-II
WB 599+00 - 615+00 Lt.
EB 599+00 - 615+00 Rt.

* THREE CABLE GUARD RAIL w/LIGHT STEEL POSTS ITEM 538
EB 599+00 - 615+00 Rt.

MUCK EXCAVATION
ITEM 117
WB 599+50 - 609+50
EB 599+50 - 610+50

CONSTRUCT U-TURN
603+50 Med.

TREATED TIMBER CURB, ITEM 230
603+42 - 615+00 EB Rt.

* Stage 2 Construction

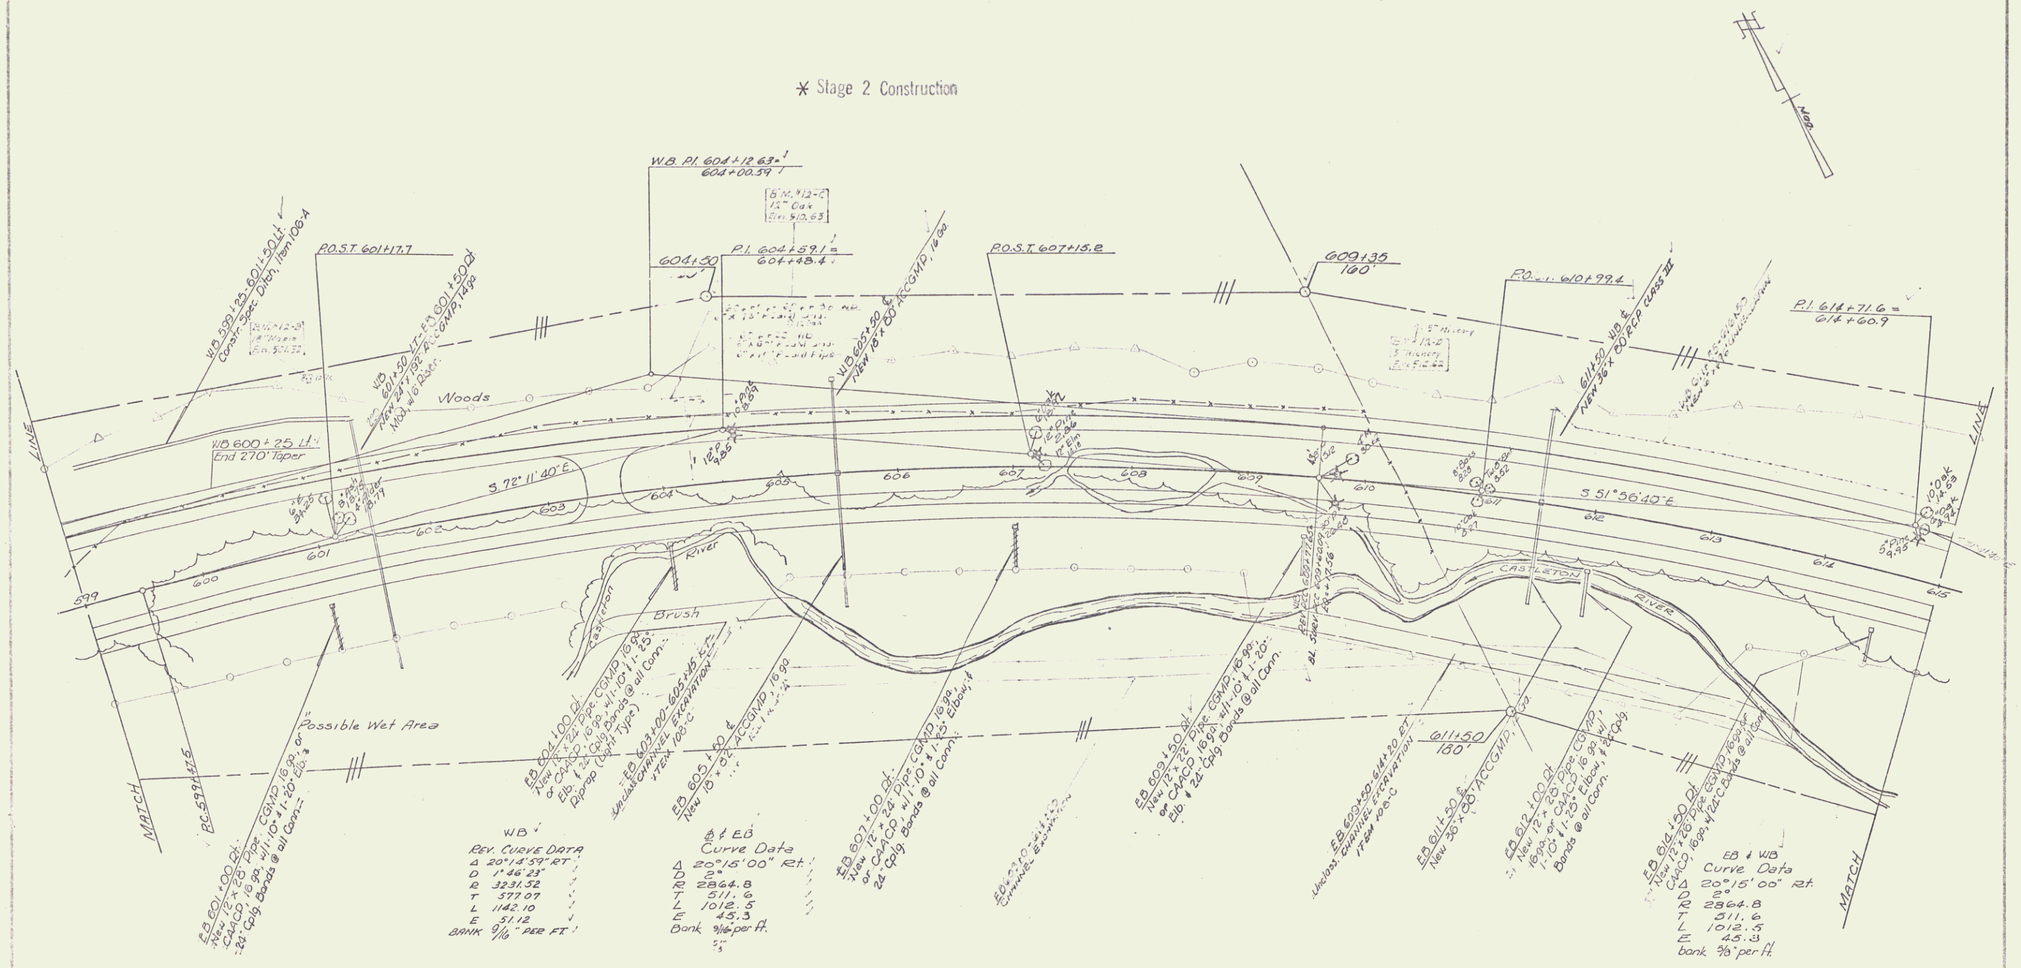

PLAN SCALE
0 50 100
SCALE FEET

CONTROL OF ACCESS COMPLETE ON THIS SHEET

STAGE I CONSTRUCTION
IRA-W. RUTLAND
PROJECT F NO. 020-1(5)(11)
SHEET 27 OF 116 SHEETS

PLAN
SUBMITTED
PROFILE
PROPOSED
APPROVED
NYE & KIMBALL ALBANY, NEW YORK
NO. DRAWN CHECKED