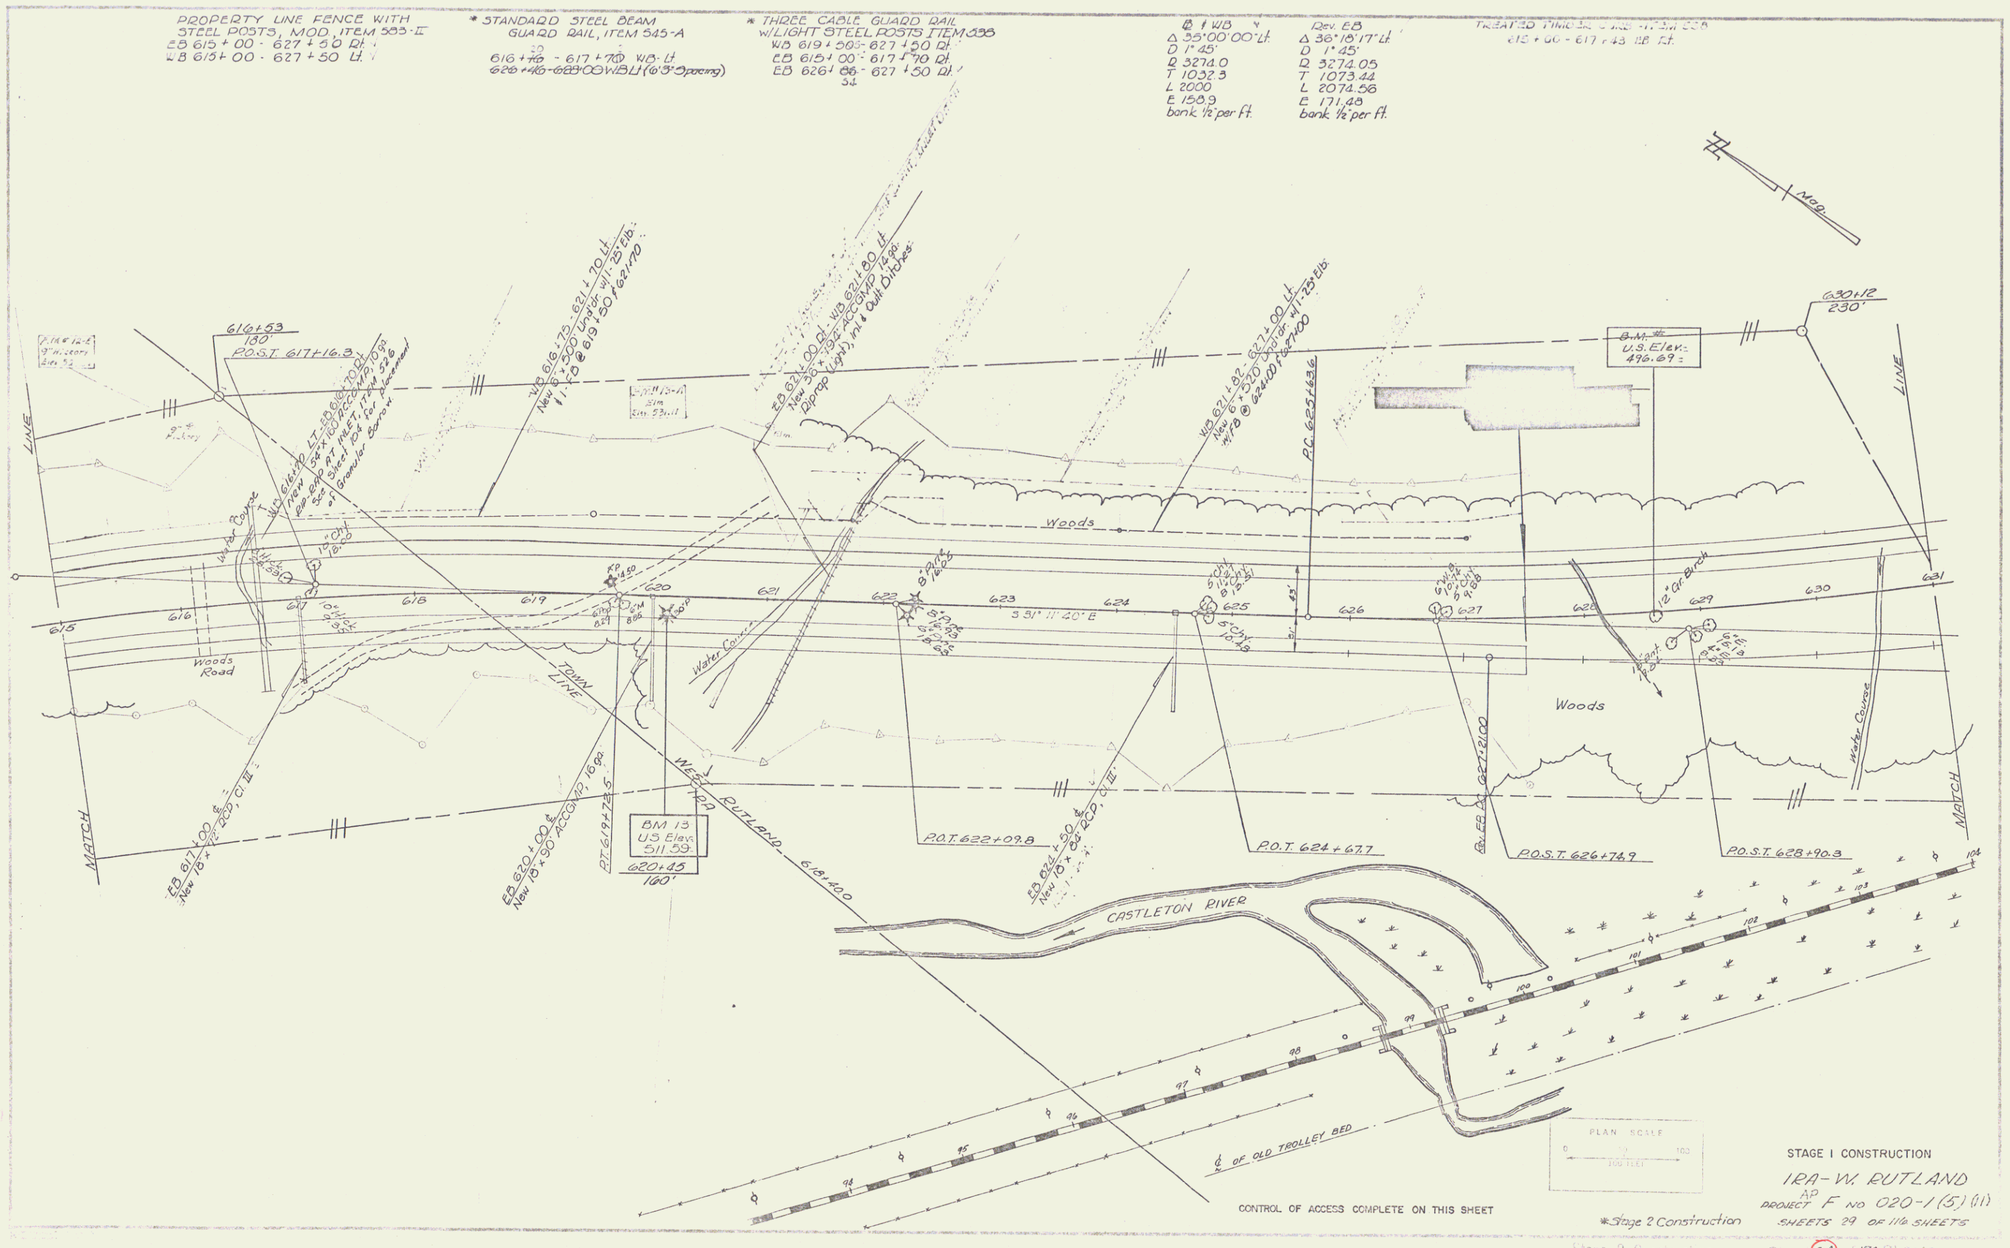

CONTROL OF ACCESS COMPLETE ON THIS SHEET

STAGE I CONSTRUCTION

IRA-W. RUTLAND

PROJECT AP F NO 020-1(5)(11)

SHEETS 29 OF 116 SHEETS

*Stage 2 Construction