POOR ORIGINAL COPY

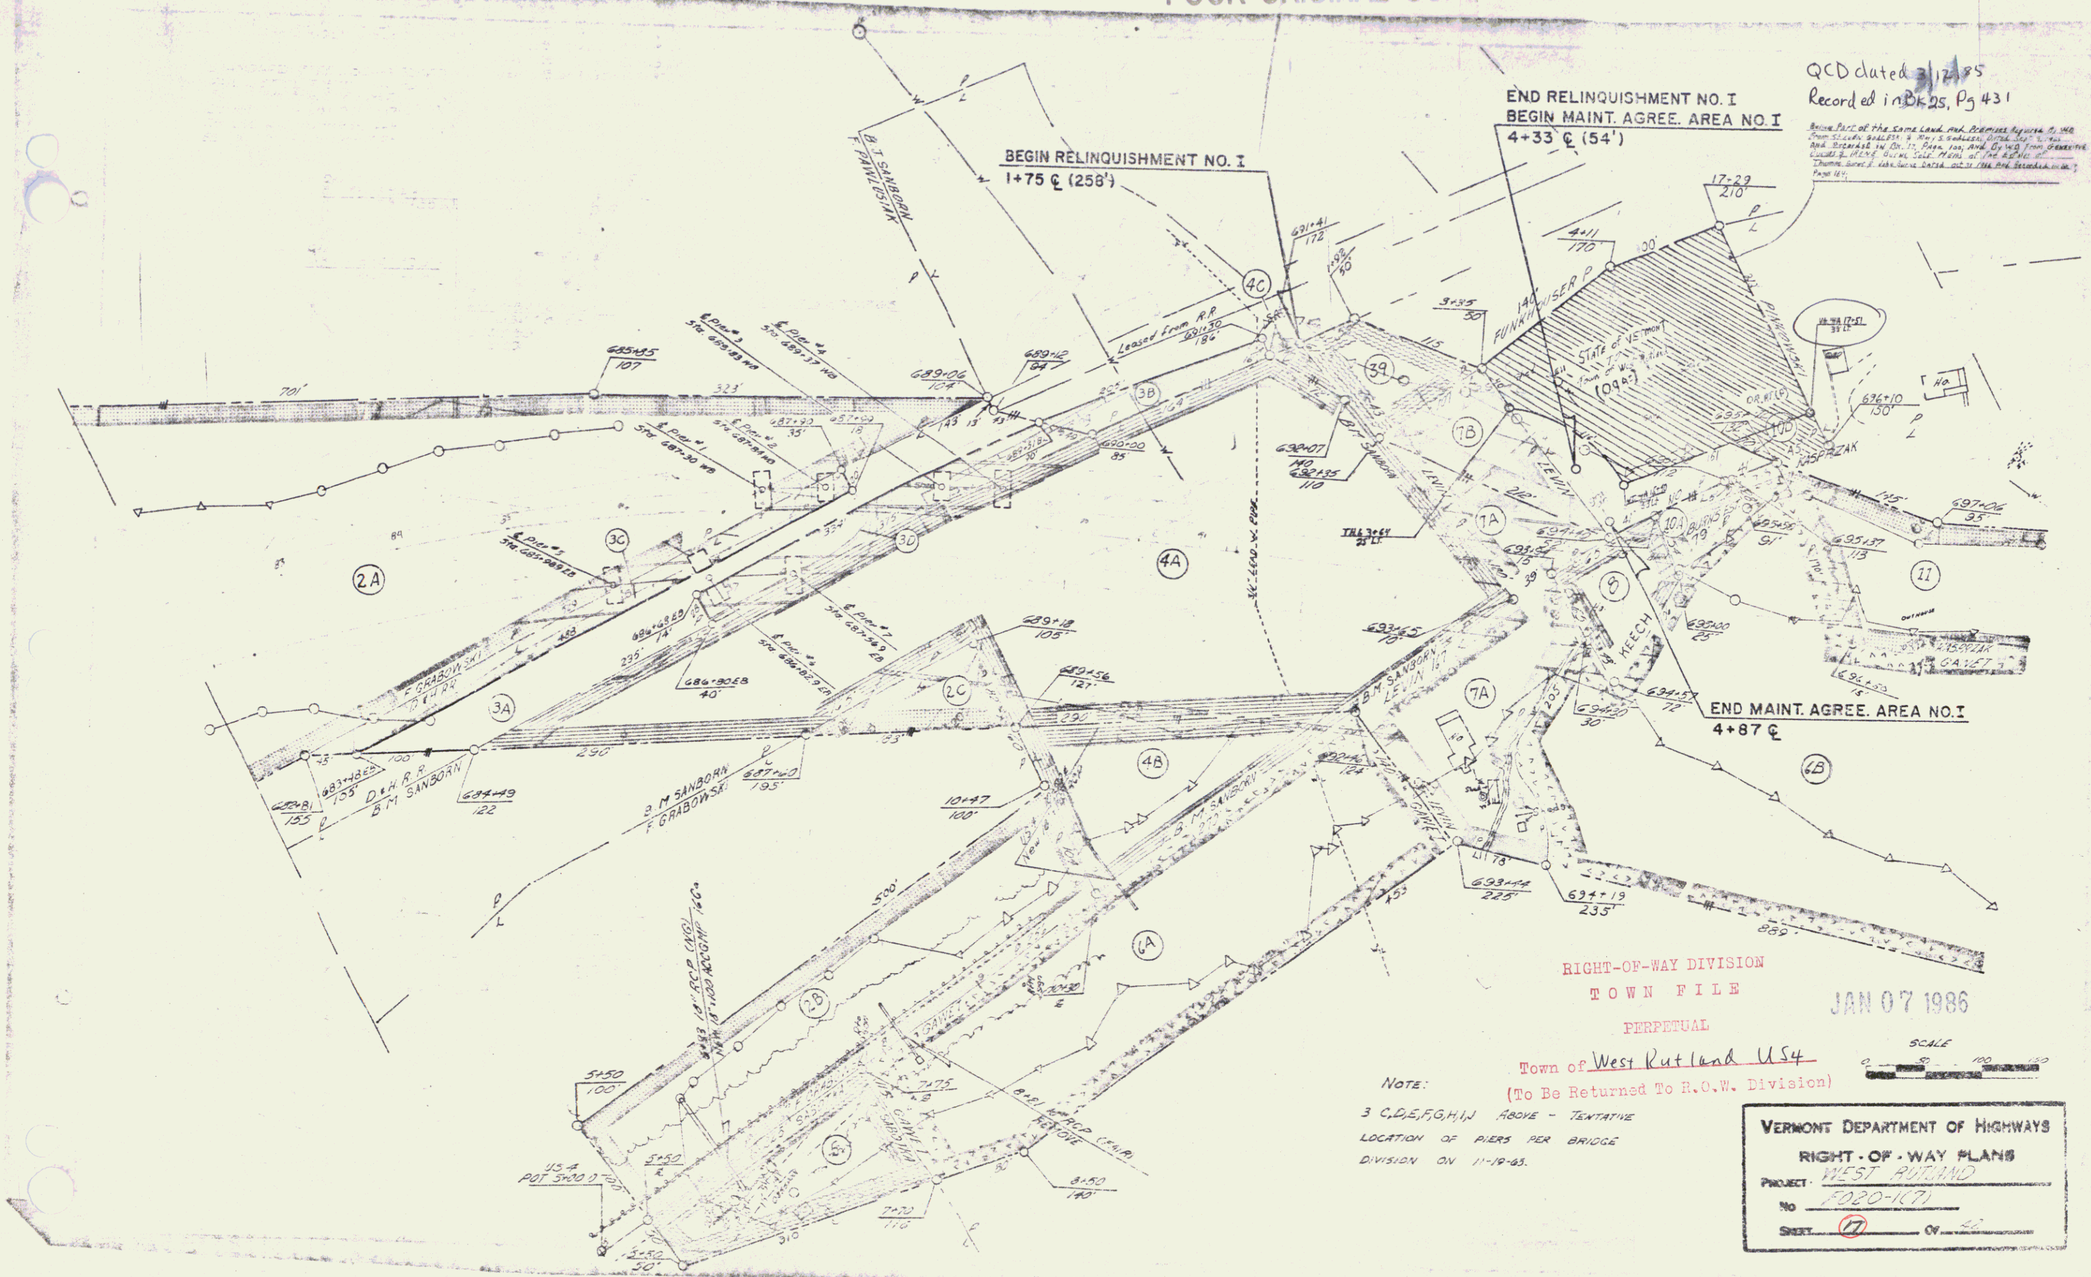

14