

Standard Steel Beam Guard Rail
 15 Posts Item 545 A


6' Galvanized Chain Link Fence Item 581-I
 WB 762000 - 774000 Lt
 EB 762000 - 774000 Lt
 WB 775000 - 778000 Lt
 EB 775000 - 778000 Lt

That fence listed below is to be installed prior to the commencement of other work in this area.

Special Ditch
 Common Excavation Item 103
 E.B. 762000 - 764000 Rt

Construct Drive
 Frontage Rd. 765000 Rt
 Frontage Rd. 772000 Rt
 Frontage Rd. 776000 Rt


Construct Maint. U-Turn
 767000

* Three Cable Guard Rail
 w/ Light Steel Posts Item 550

Note: Frontage Road to be built in its entirety during Stage 1 Construction
 Demolition/Disposal of Building Item 580

* Stage 2 Construction

* Bridge Railing (Bridge Approach) Item 572

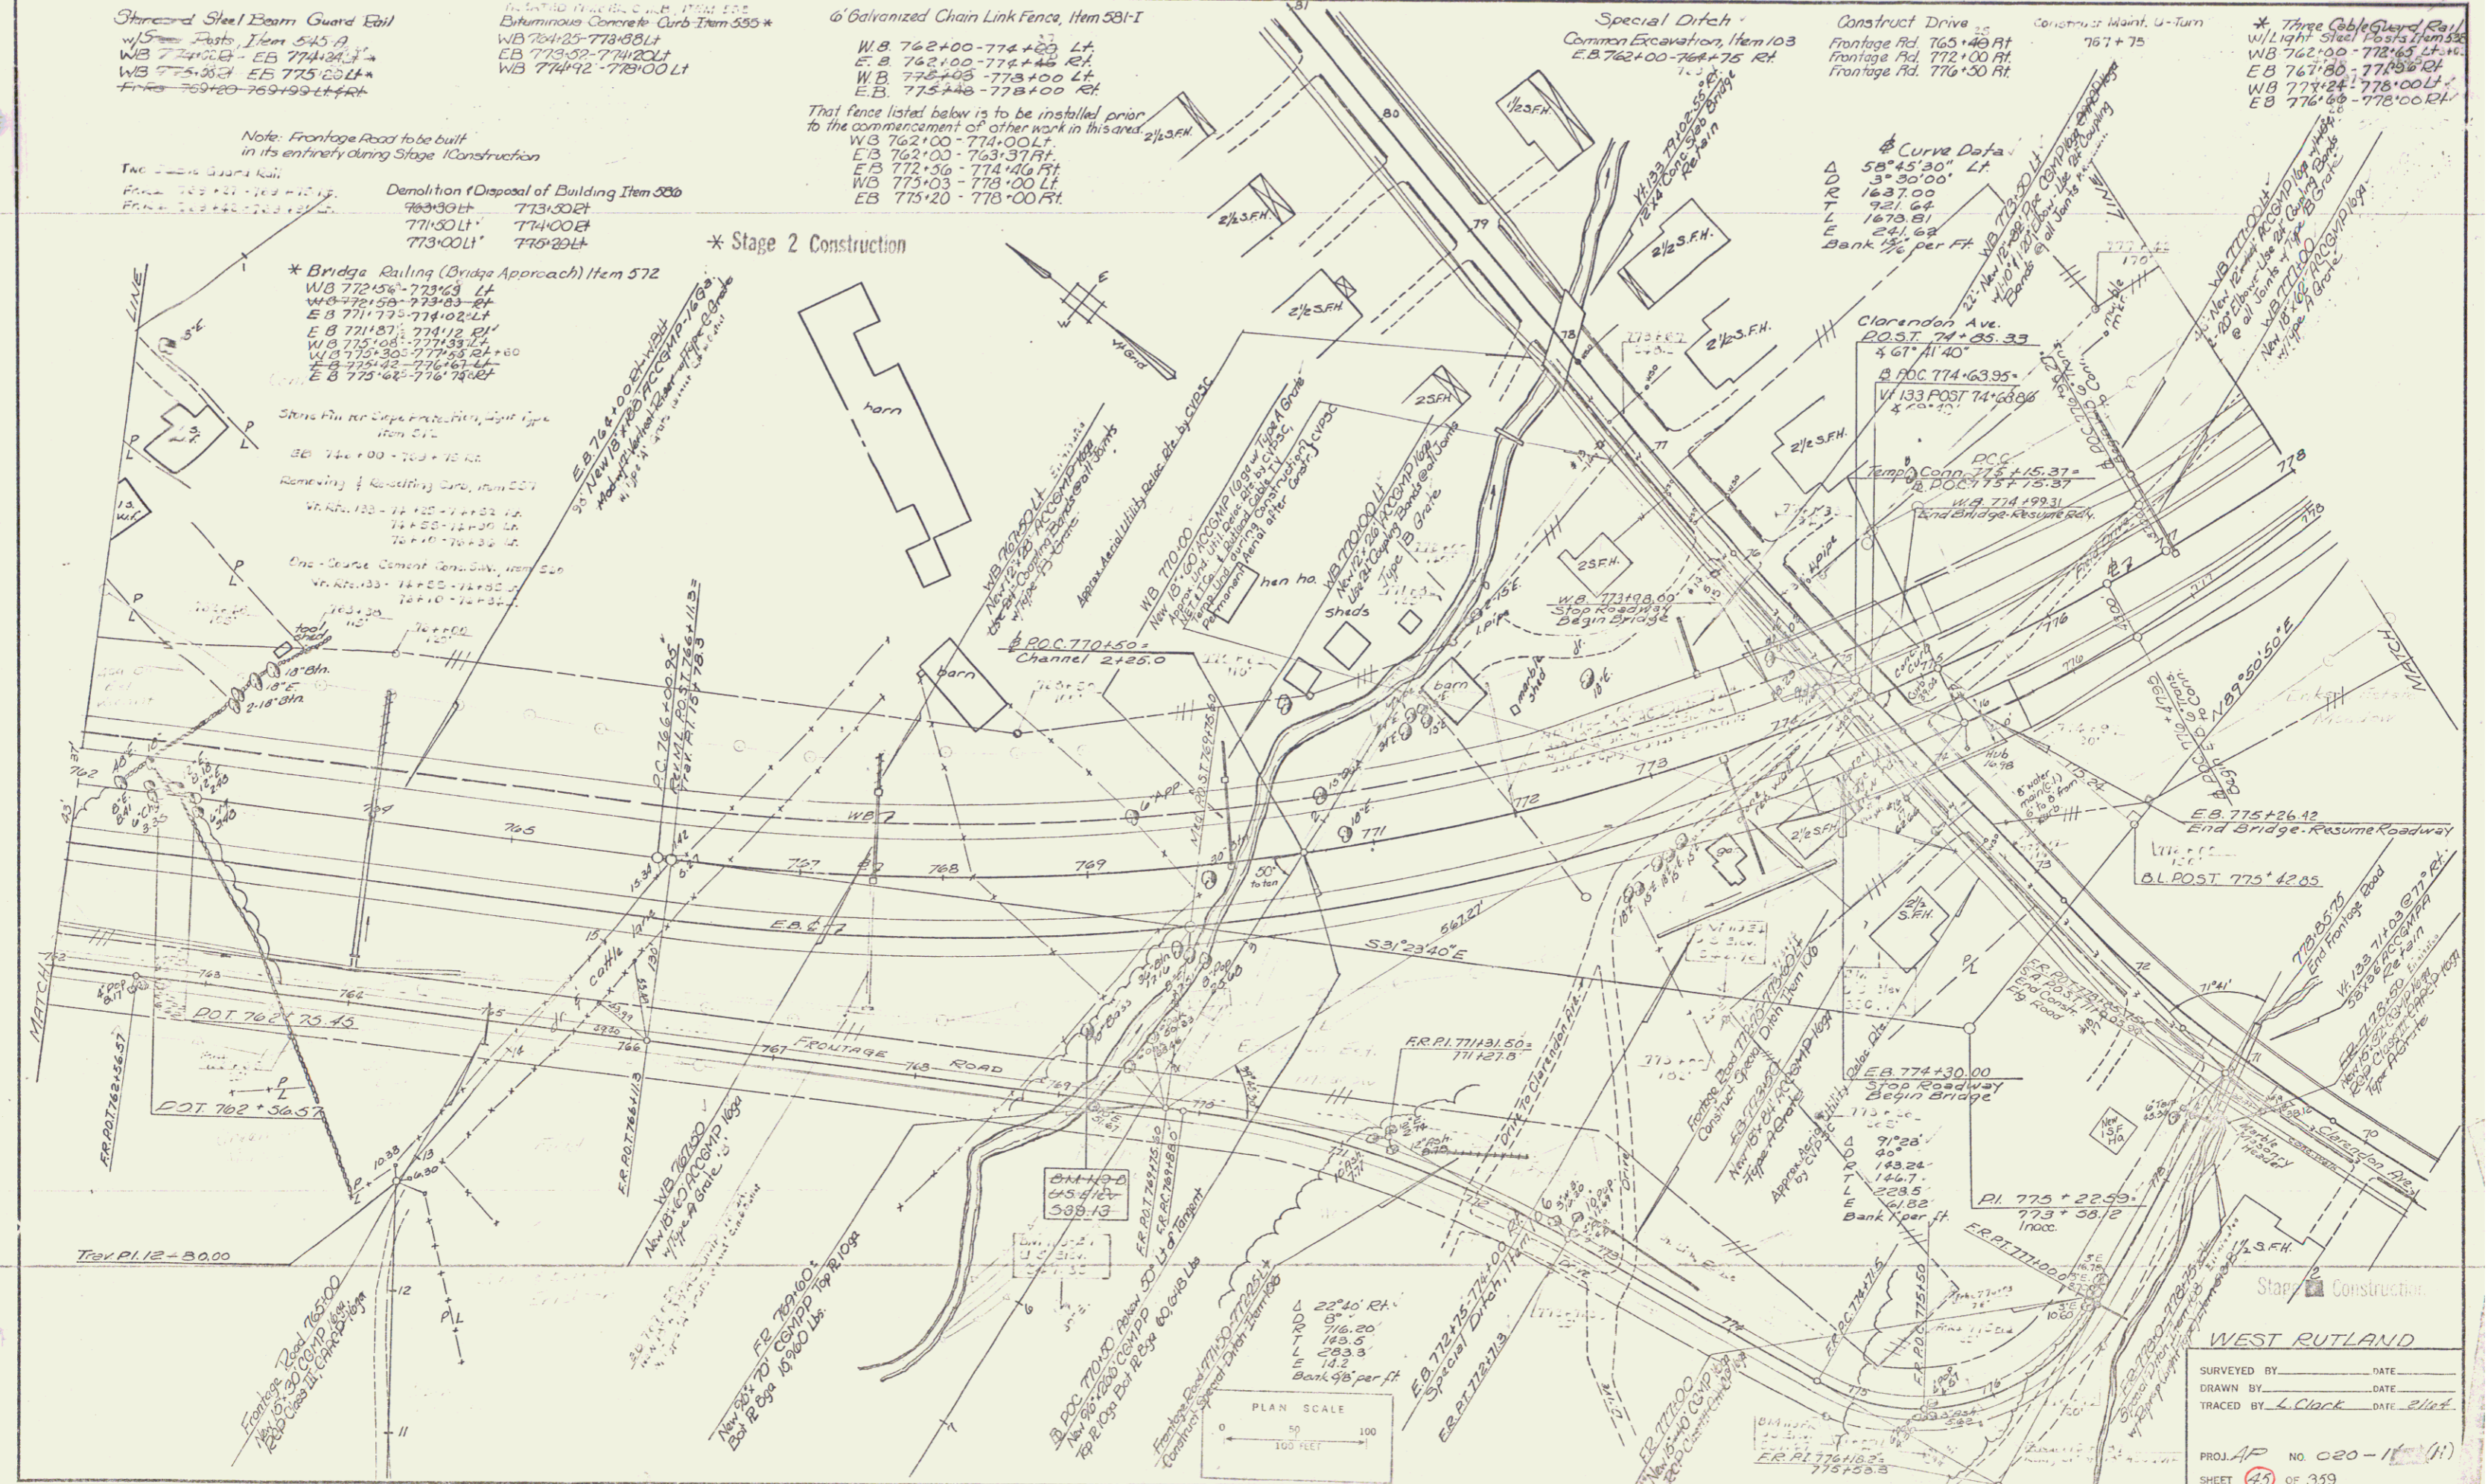

WEST RUTLAND
 SURVEYED BY _____ DATE _____
 DRAWN BY _____ DATE _____
 PROJ. AP NO. 020-11(1)
 SHEET 45 OF 359
