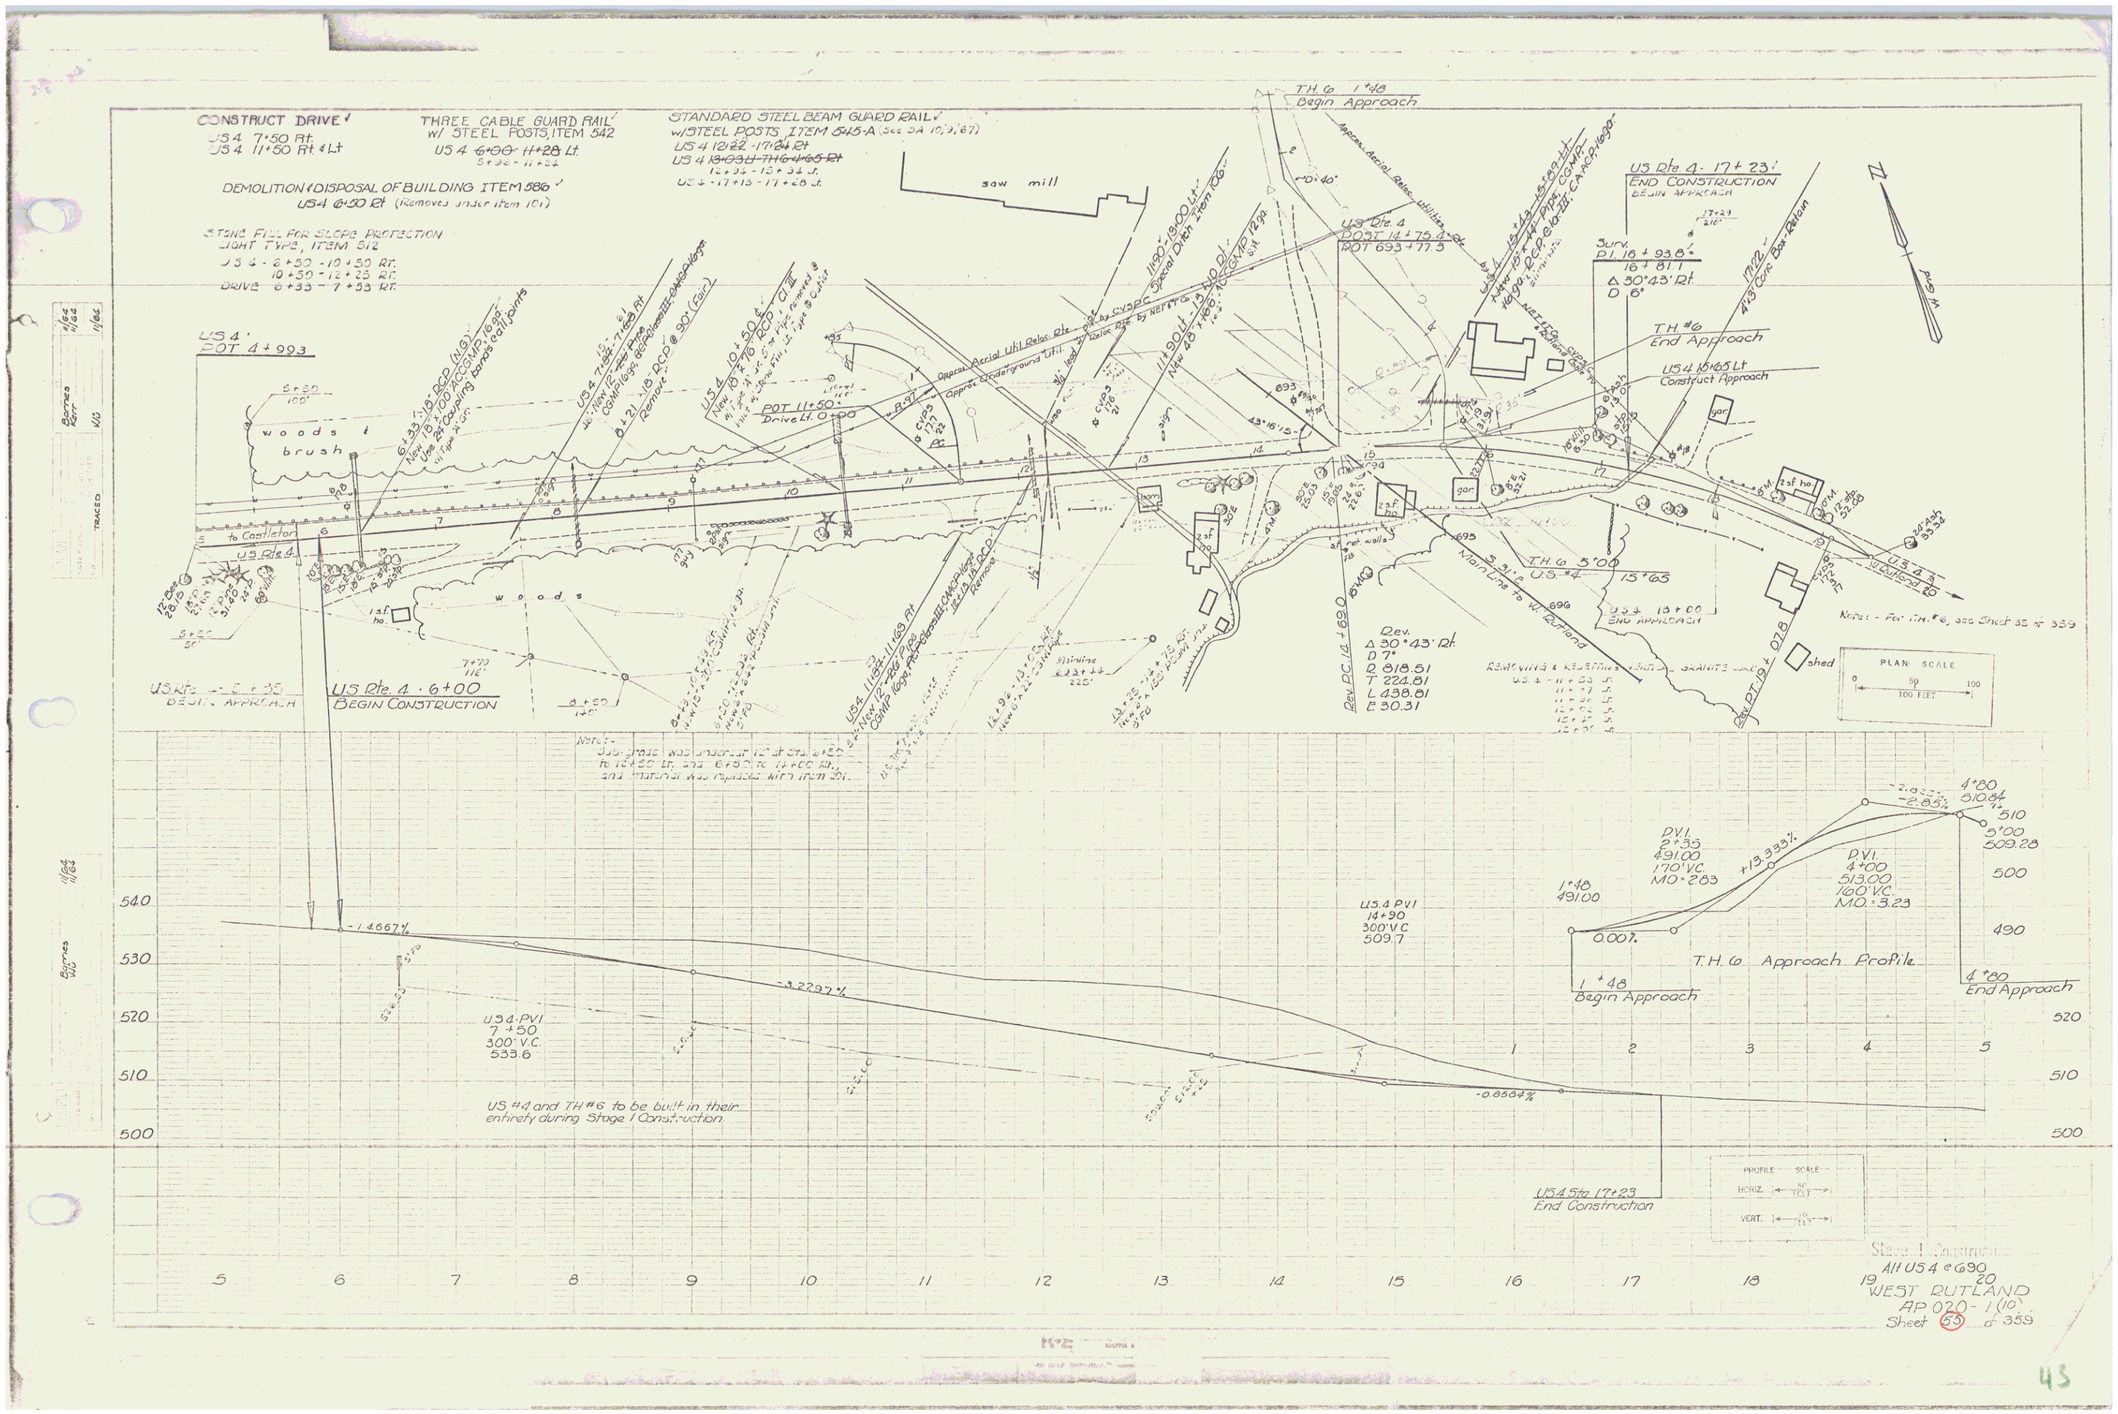
CONSTRUCT DRIVE
US 4 7+50 Rt.
US 4 11+50 Rt & Lt
THREE CABLE GUARD RAIL w/ STEEL POSTS, ITEM 542
US 4 6+00 - 11+28 Lt.
STANDARD STEEL BEAM GUARD RAIL w/ STEEL POSTS, ITEM 545-A (See SA 10/9/67)
US 4 12+22 - 17+24 Rt
US 4 12+32 - 15+34 Lt.
US 4 - 17+13 - 17+26 Lt.
DEMOLITION & DISPOSAL OF BUILDING ITEM 586
US 4 6+50 Rt (Removes under item 101)
STONE FILL FOR SLOPE PROTECTION LIGHT TYPE, ITEM 512
US 4 - 8+50 - 10+50 Rt.
10+50 - 12+25 Rt.
DRIVE 6+33 - 7+33 Rt.
saw mill
US 4 POT 4+99.3
woods & brush
to Castleton
US Rte 4
US Rte 4 - 6+00
BEGIN CONSTRUCTION
US Rte 4 - 17+23
END CONSTRUCTION
BEGIN APPROACH
US 4 POT 11+50 Drive Lt. 0+00
US 4 POT 14+75.4
POT 693+77.3
Surv. P.I. 16+93.8
16+81.1
Δ 30°43' Rt
D 6°
TH #6 End Approach
US 4 15+65 Lt Construct Approach
TH 6 1+48 Begin Approach
TH 6 5+00
US 4 13+00 END APPROACH
Rev.
Δ 30°43' Rt
D 7°
R 818.51
T 224.81
L 438.81
E 30.31
Rev PC 14+69.0
Rev PT 19+07.8
Main Line to W. Rutland
Notes - For TH #6, see Sheet 33 of 359
PLAN SCALE
0 50 100
100 FEET
US 4 PVI 7+50 300' V.C. 533.6
US 4 PVI 14+90 300' V.C. 509.7
P.V.I. 2+55 491.00 170' V.C. M.O. +2.83
P.V.I. 4+00 513.00 160' V.C. M.O. +3.23
1+48 491.00
0.00%
+19.333%
4+80 510.84
5+00 509.28
-1.4667%
-3.2297%
-0.8584%
T.H. 6 Approach Profile
1+48 Begin Approach
4+80 End Approach
US 4 Sta 17+23 End Construction
PROFILE SCALE
HORIZ. 50' TO 1"
VERT. 10' TO 1"
Stage I Construction
All US 4 @ 690
WEST RUTLAND
AP 020-1(10)
43