REMOVAL & DISPOSAL of
PRESENT GUARD RAIL
453+50=454+70 Rt
453+50-454+70 Rt

TWO CABLE GUARD RAIL
453+21=453+37 Rt
455+36=456+00 Rt

453+21 - 455+21 Rt
455+38 - 457+02 Rt

CONSTRUCT DRIVES
455+50 Rt

Note - Curve data of this are for survey center line. Construction center line is offset as indicated by pencil line.

REV CURVE DATA
Bank 1¼" per ft.

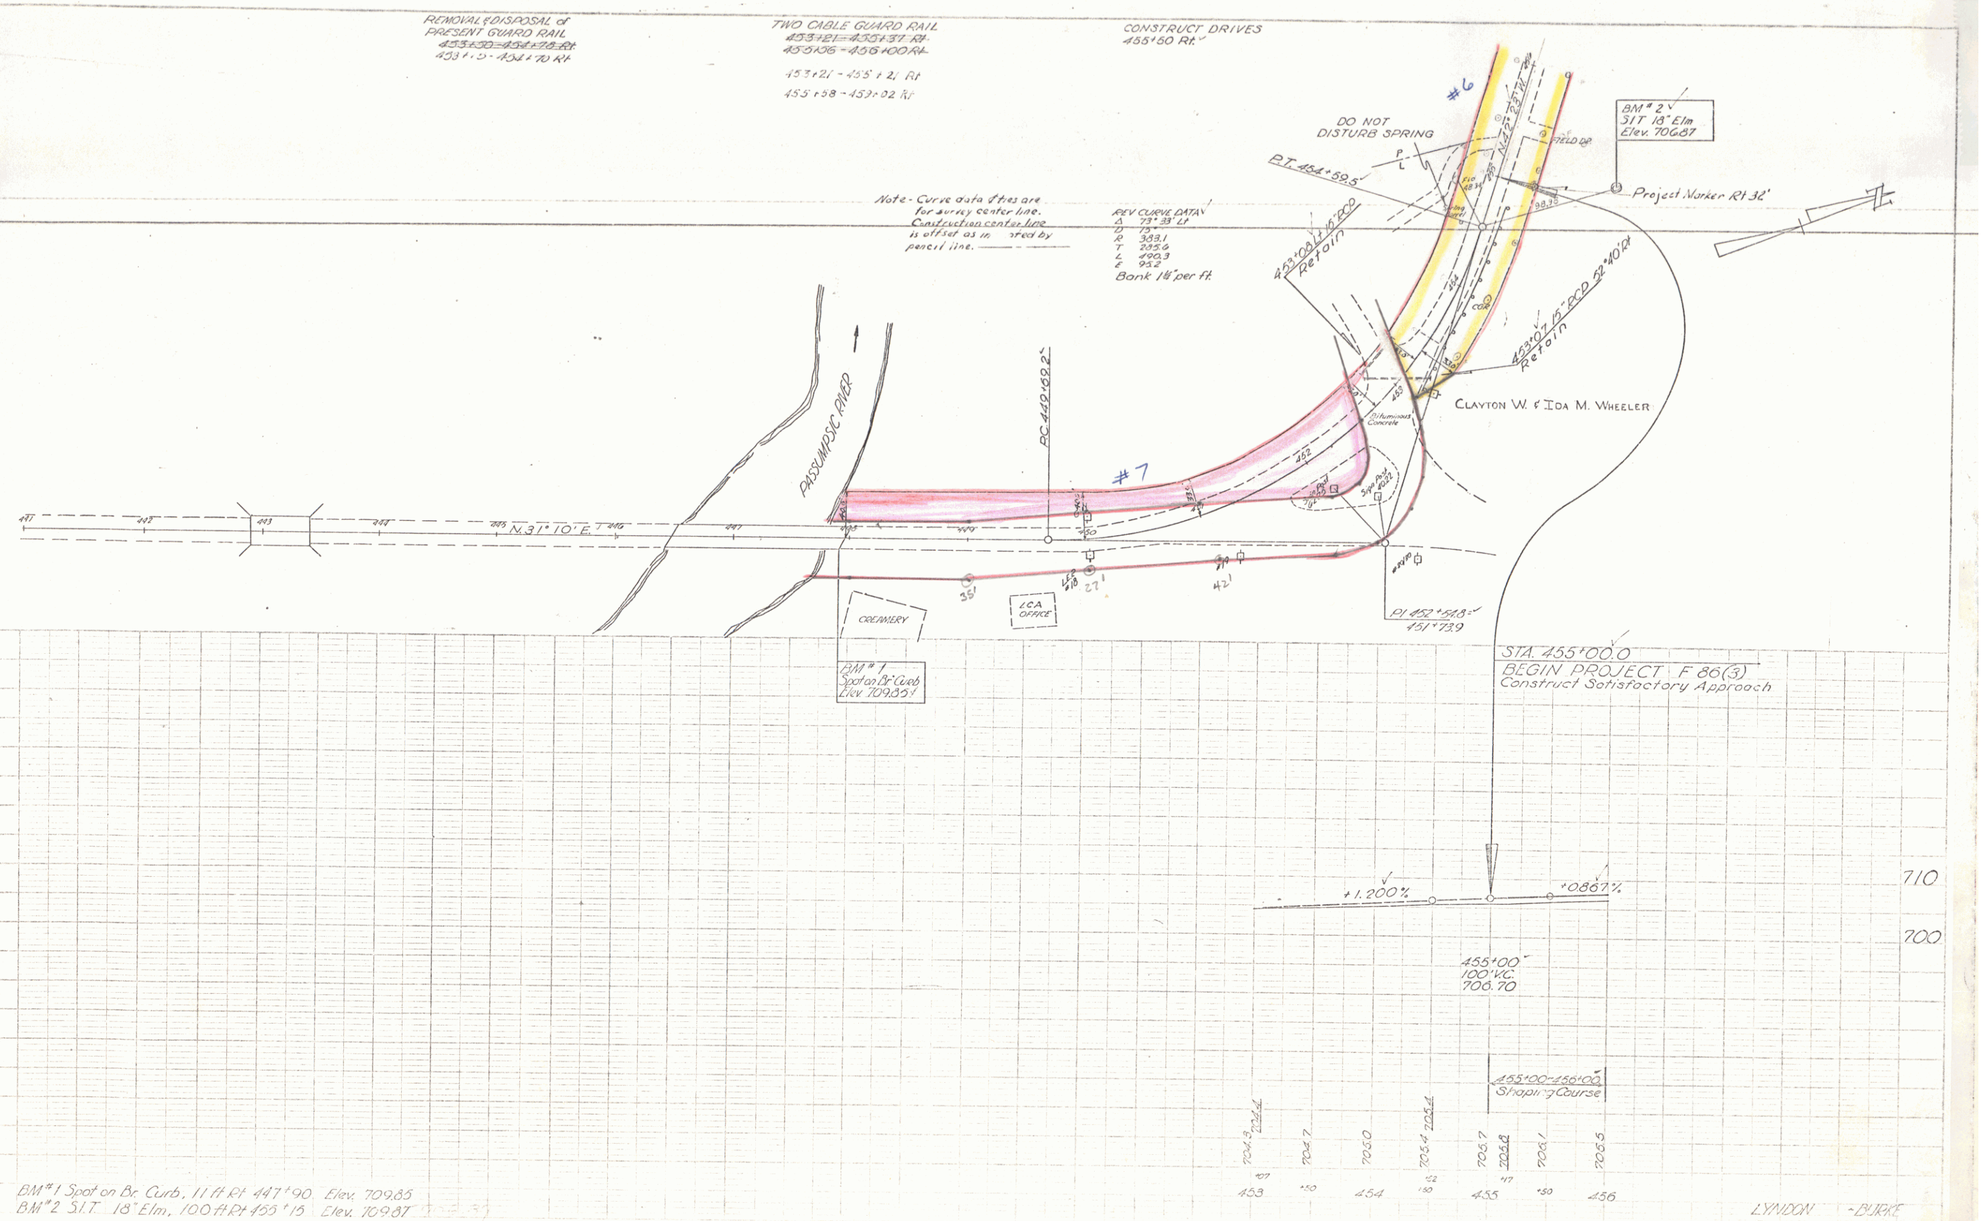


BM #1 Spot on Br. Curb, 11 ft Rt 447+90. Elev. 709.85
BM #2 S.I.T. 18" Elm, 100 ft Rt 455+15 Elev. 709.87

LYNDON - BURKE
Project F No. 86(3)
Sheet 14 of 173 Sheets

2