WOOD GUIDE POSTS
Rt 16'o/c
467+00 ~ 470+19
Lt
476+56 ~ 478+80

TWO CABLE GUARD RAIL
~~471+90 ~ 482+00 Rt~~
~~481+90 ~ 482+00 Lt~~
471 + 90 - 482 + 22 Rt

STONE FILL
467+20 - 468+10 Lt

CLEARING & GRUBBING
467+10 - 467+25 Rt, 467+10 - 469+00 Rt.

CONSTRUCT DRIVES
471+00 Rt
479+50 Lt
481+50 Lt
476+23 Lt
481+50 Lt
481+60 Lt

REMOVAL & DISPOSAL OF PRESENT GUARD RAIL
~~481+25 ~ 482+00 Rt~~
481+25 ~ 482+00 Lt

D.L. L.G & D.N. ROUNDY

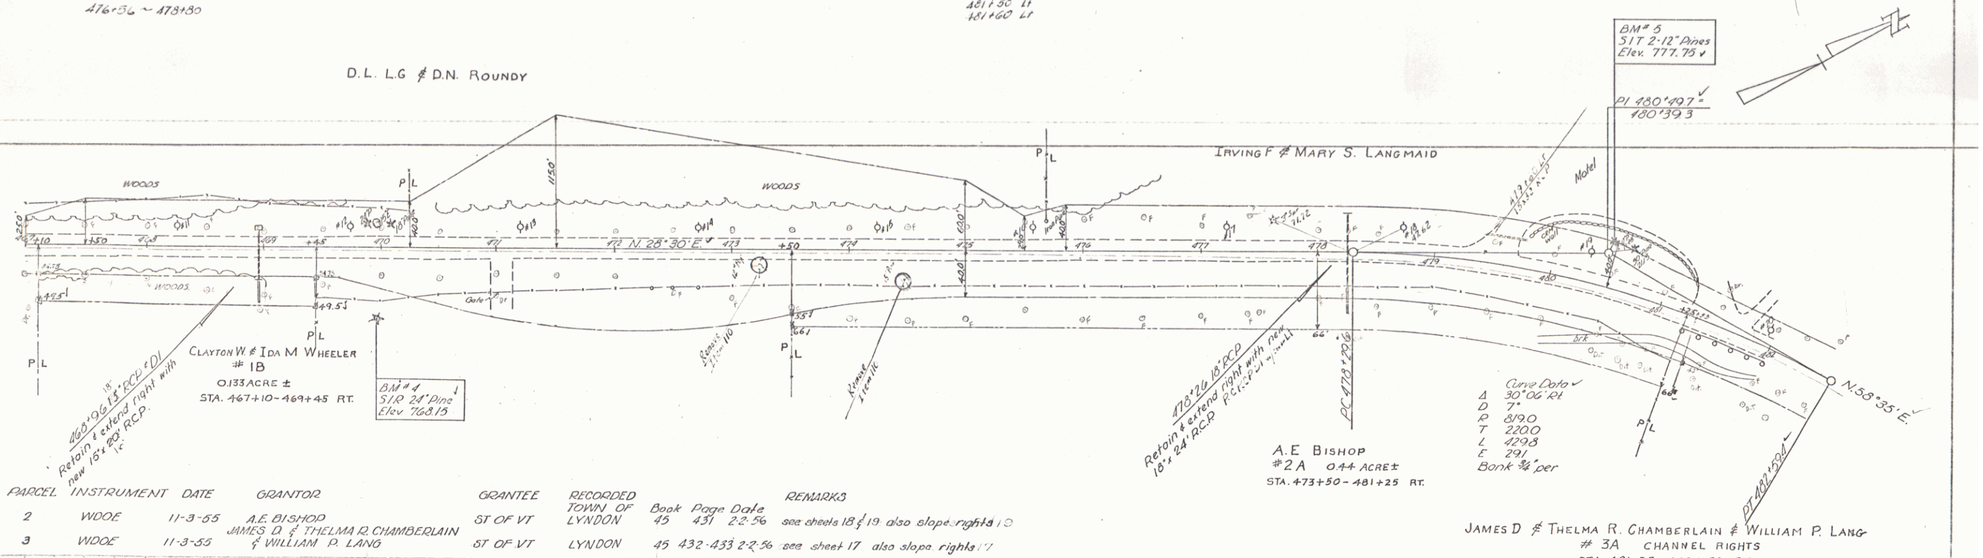

PARCEL	INSTRUMENT	DATE	GRANTOR	GRANTEE	RECORDED TOWN OF	Book	Page	Date	REMARKS
2	WDOE	11-3-55	A.E. BISHOP	ST OF VT	LYNDON	45	431	2-2-56	see sheets 18 & 19 also slope rights
3	WDOE	11-3-55	JAMES D. & THELMA R. CHAMBERLAIN & WILLIAM P. LANG	ST OF VT	LYNDON	45	432-433	2-2-56	see sheet 17 also slope rights

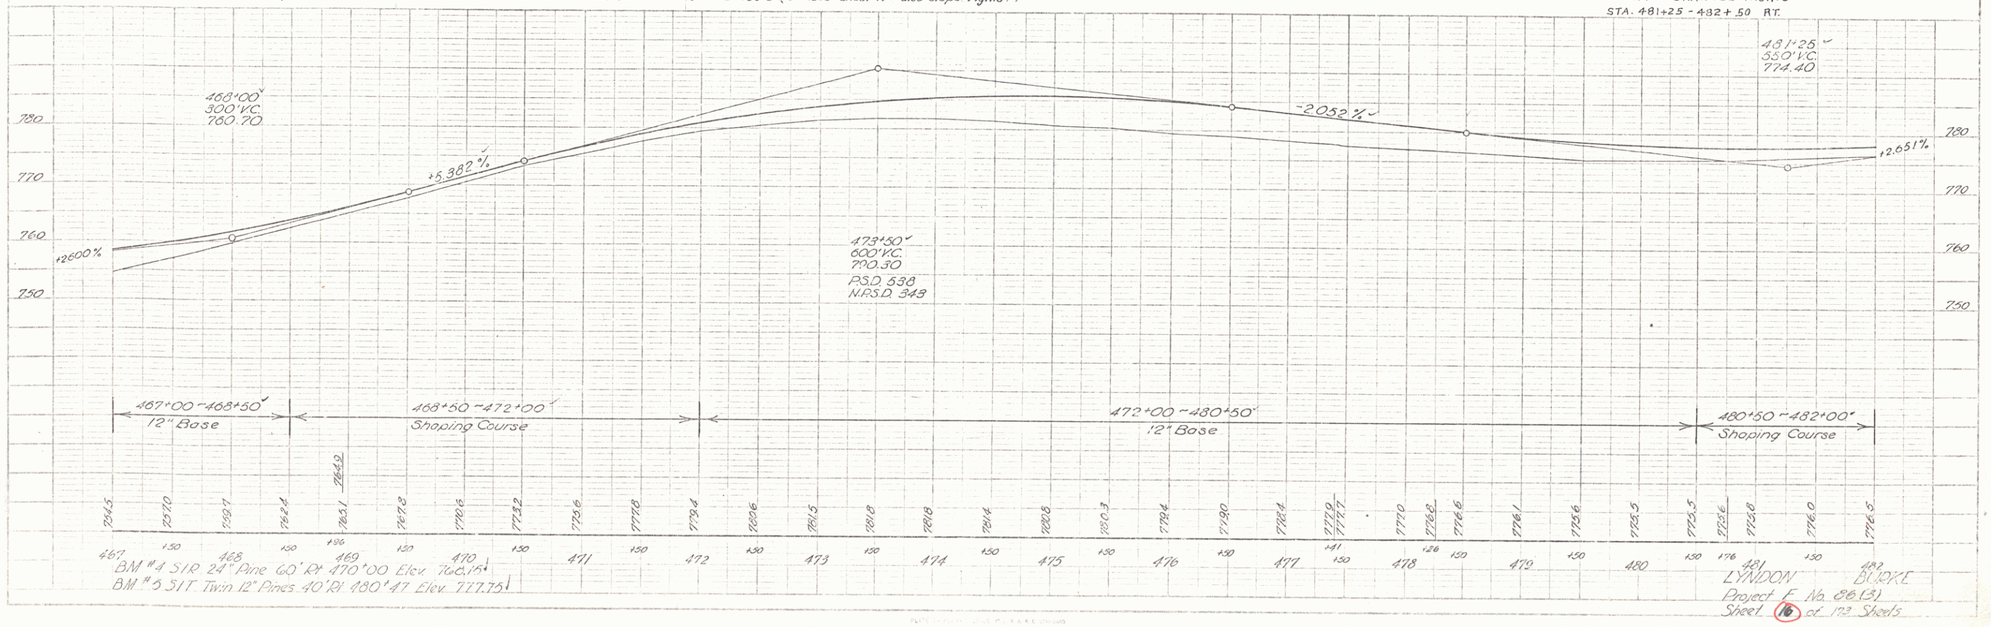

LYNDON BLOCKE
Project F No. 86(3)
Sheet 16 of 172 Sheets