WOOD GUIDE POSTS
Lt 16' o/c
499+75 ~ 505+71
Rt
509+40 ~ 511+10

TWO CABLE GUARD RAIL
~~495+00 ~ 499+98 Lt~~

CONSTRUCT DRIVES
502+00 - 504+50 Rt

CLEARING & GRUBBING
~~498+50 - 503+05 Lt~~
504+00 - 507+75 Lt
~~498+00 - 503+50 Lt~~
~~505+50 - 507+85 Lt~~

REMOVAL & DISPOSAL OF PRESENT GUARD RAIL
~~495+00 ~ 499+32 Lt~~
498+00 - 498+25

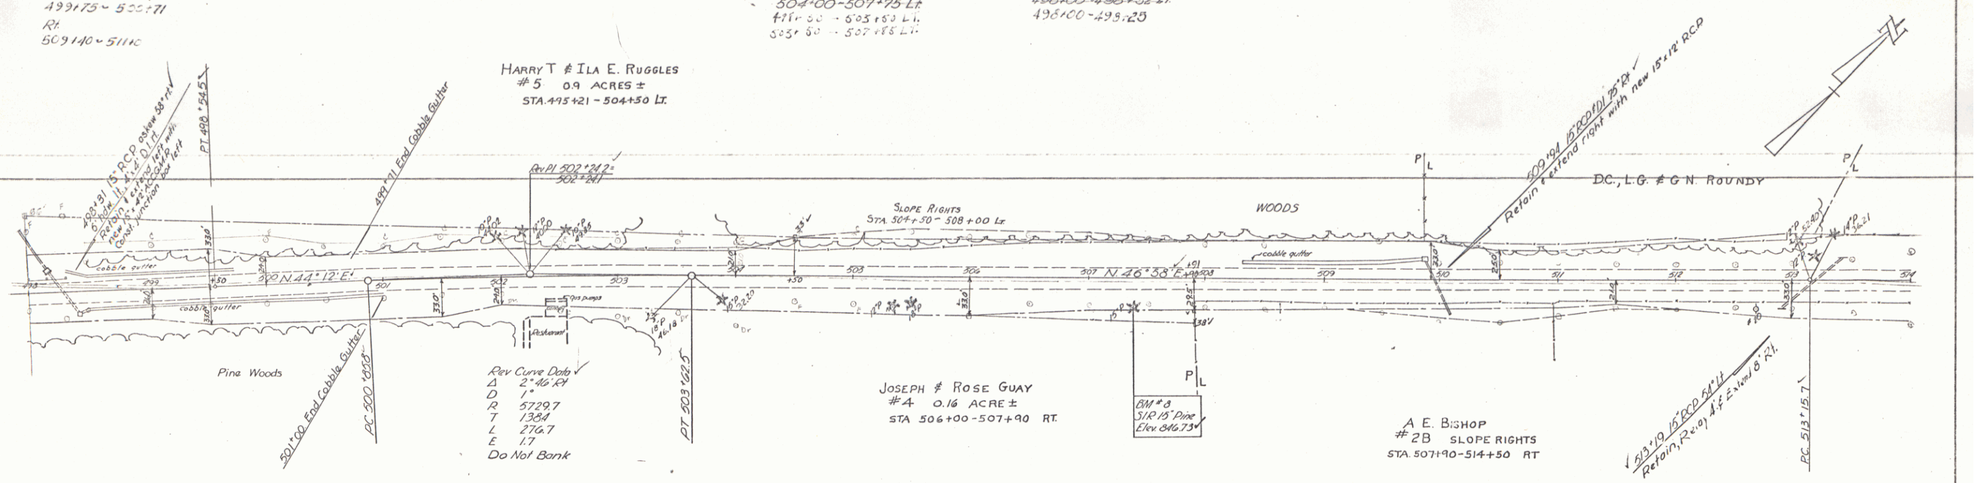

PARCEL	INSTRUMENT	DATE	GRANTOR	GRANTEE	RECORDED TOWN OF	Book	Page	Date	REMARKS
4	WDOE	11-3-55	JOSEPH & ROSE GUAY	ST OF VT	LYNDON	45	434	2-2-56	
5	WDOE	11-3-55	HARRY T & ILA E RUGGLES	ST OF VT	LYNDON	45	433	2-2-56	see also sheet 17

GRADE RAISED 3" STA 510+50 to STA 512+50
Tapered to Designation on each end in 300 Ft.

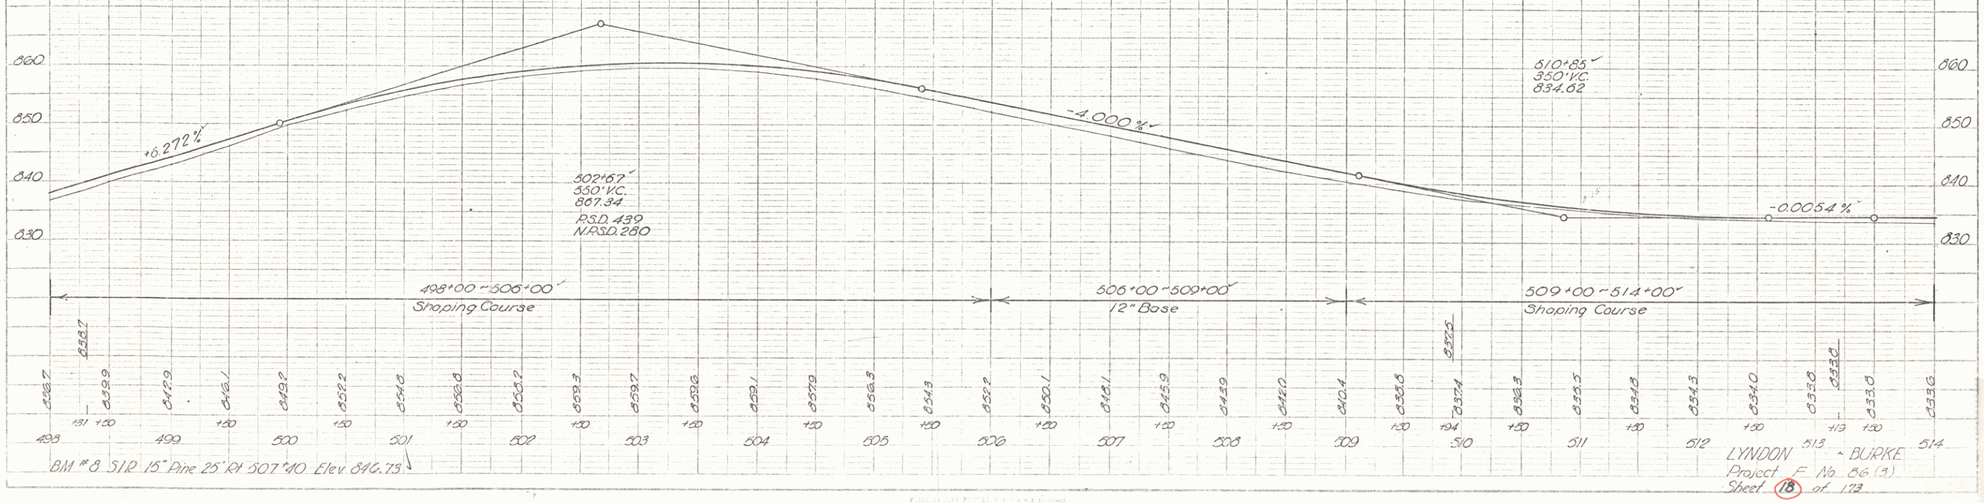

LYNDON - BURKE
Project F No. 86(3)
Sheet 18 of 172

7