CONSTRUCT DRIVES
544+30 Lt
551+00 Rt
552+00 Lt
552+85 Rt
553+70 Rt
544+65 Rt
552+00 Rt
555+10 Rt

WOOD GUIDE POSTS
L.T. 16' o/c
547+50 ~ 550+16

CLEARING & GRUBBING
~~542+00 - 544+09 Rt~~
542+00 - 542+22 Rt.

TWO CABLE GUARD RAIL
~~542+00 - 542+50~~
540+30 - 544+06 Rt

REMOVAL & DISPOSAL OF PRESENT GUARD RAIL
542+00 - 544+11 Rt
~~542+00 - 550+13 Lt~~
548+03 - 550+06 Lt

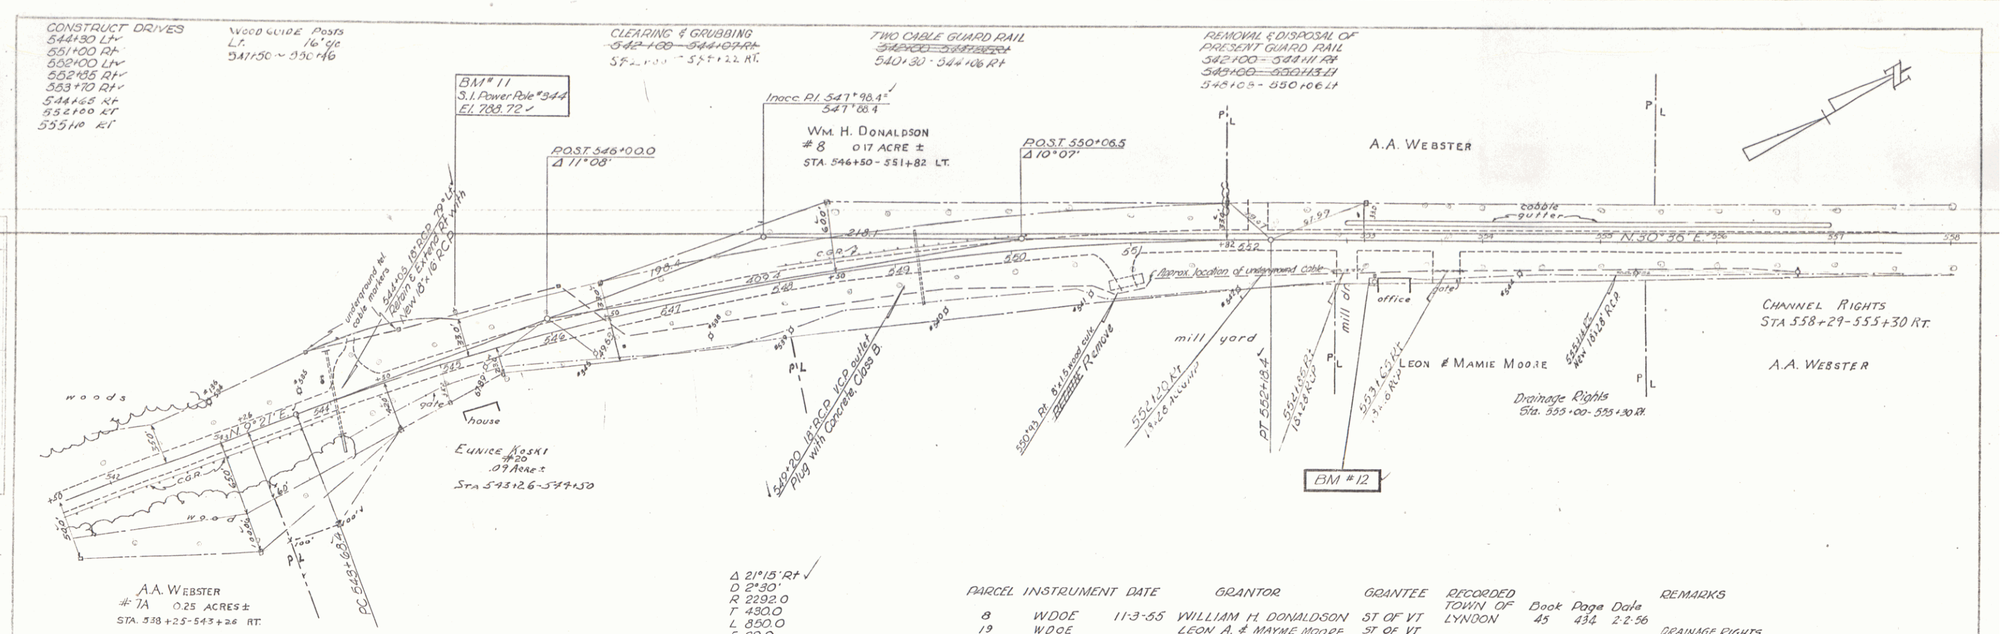

Δ 21°15' Rt
D 2°30'
R 2292.0
T 430.0
L 850.0
E 39.9
Bank ½ per ft

PARCEL	INSTRUMENT	DATE	GRANTOR	GRANTEE	RECORDED TOWN OF	Book	Page	Date	REMARKS
8	WDOE	11-3-55	WILLIAM H. DONALDSON	ST OF VT	LYNDON	45	454	7-10-56	
19	WDOE		LEON A. & MAYME MOORE	ST OF VT					DRAINAGE RIGHTS
20	WDOE	7-6-56	EUNICE KOSKI	ST OF VT					

Grade Raised 3" 3 ra. 554+00 to 556+00
Tapered back to existing grade each end
1:1 300 ft.

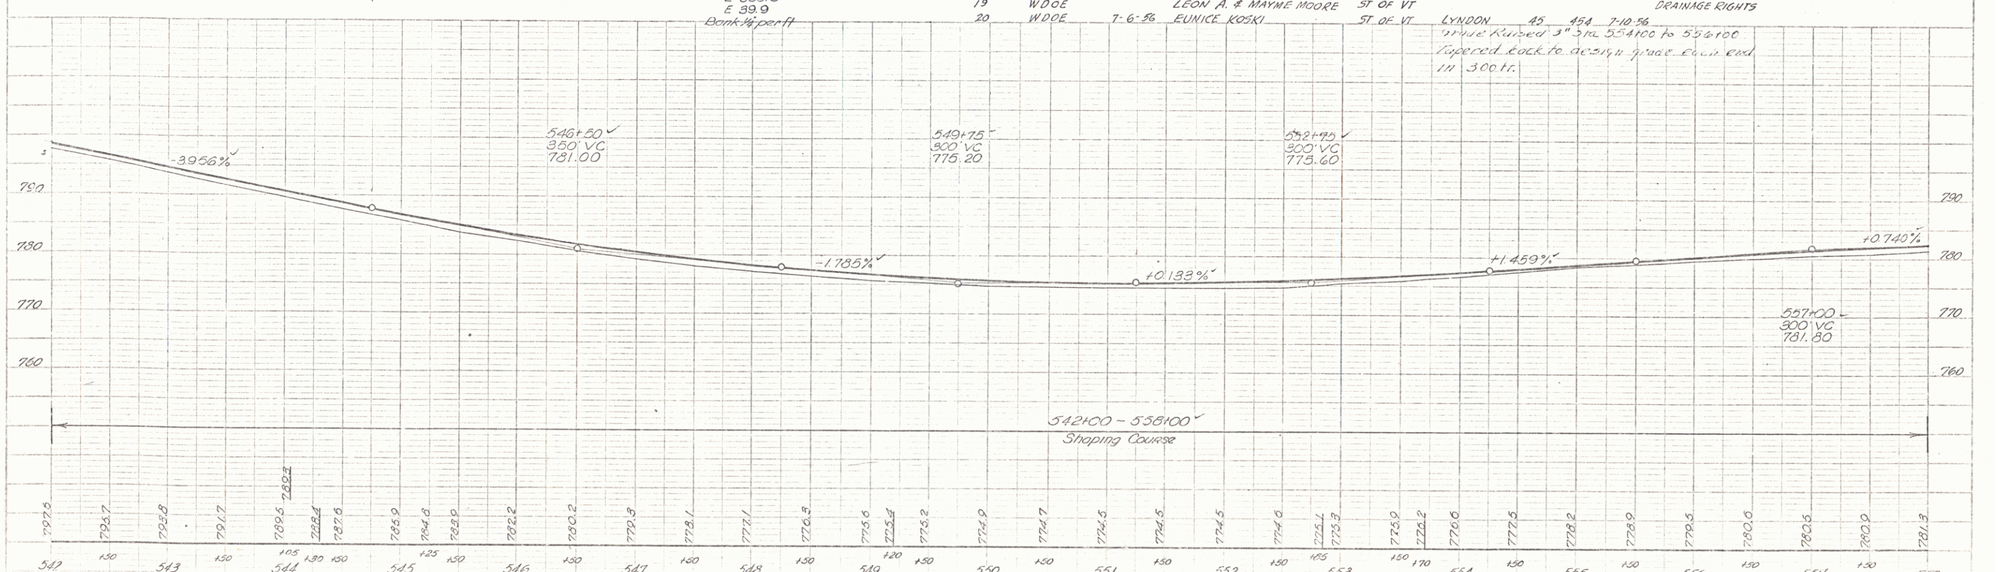

BM # 11 S.I. Power Pole #344 40' Lt. Sta. 545+25 El. 768.72
BM # 12 Spot on Wood Gas Pump Fdn. 34' Rt. Sta. 553+05 El. 776.83

LYNDONVILLE - BURKE
Project F No. 86 (3)
Sheet 21 of 173

10