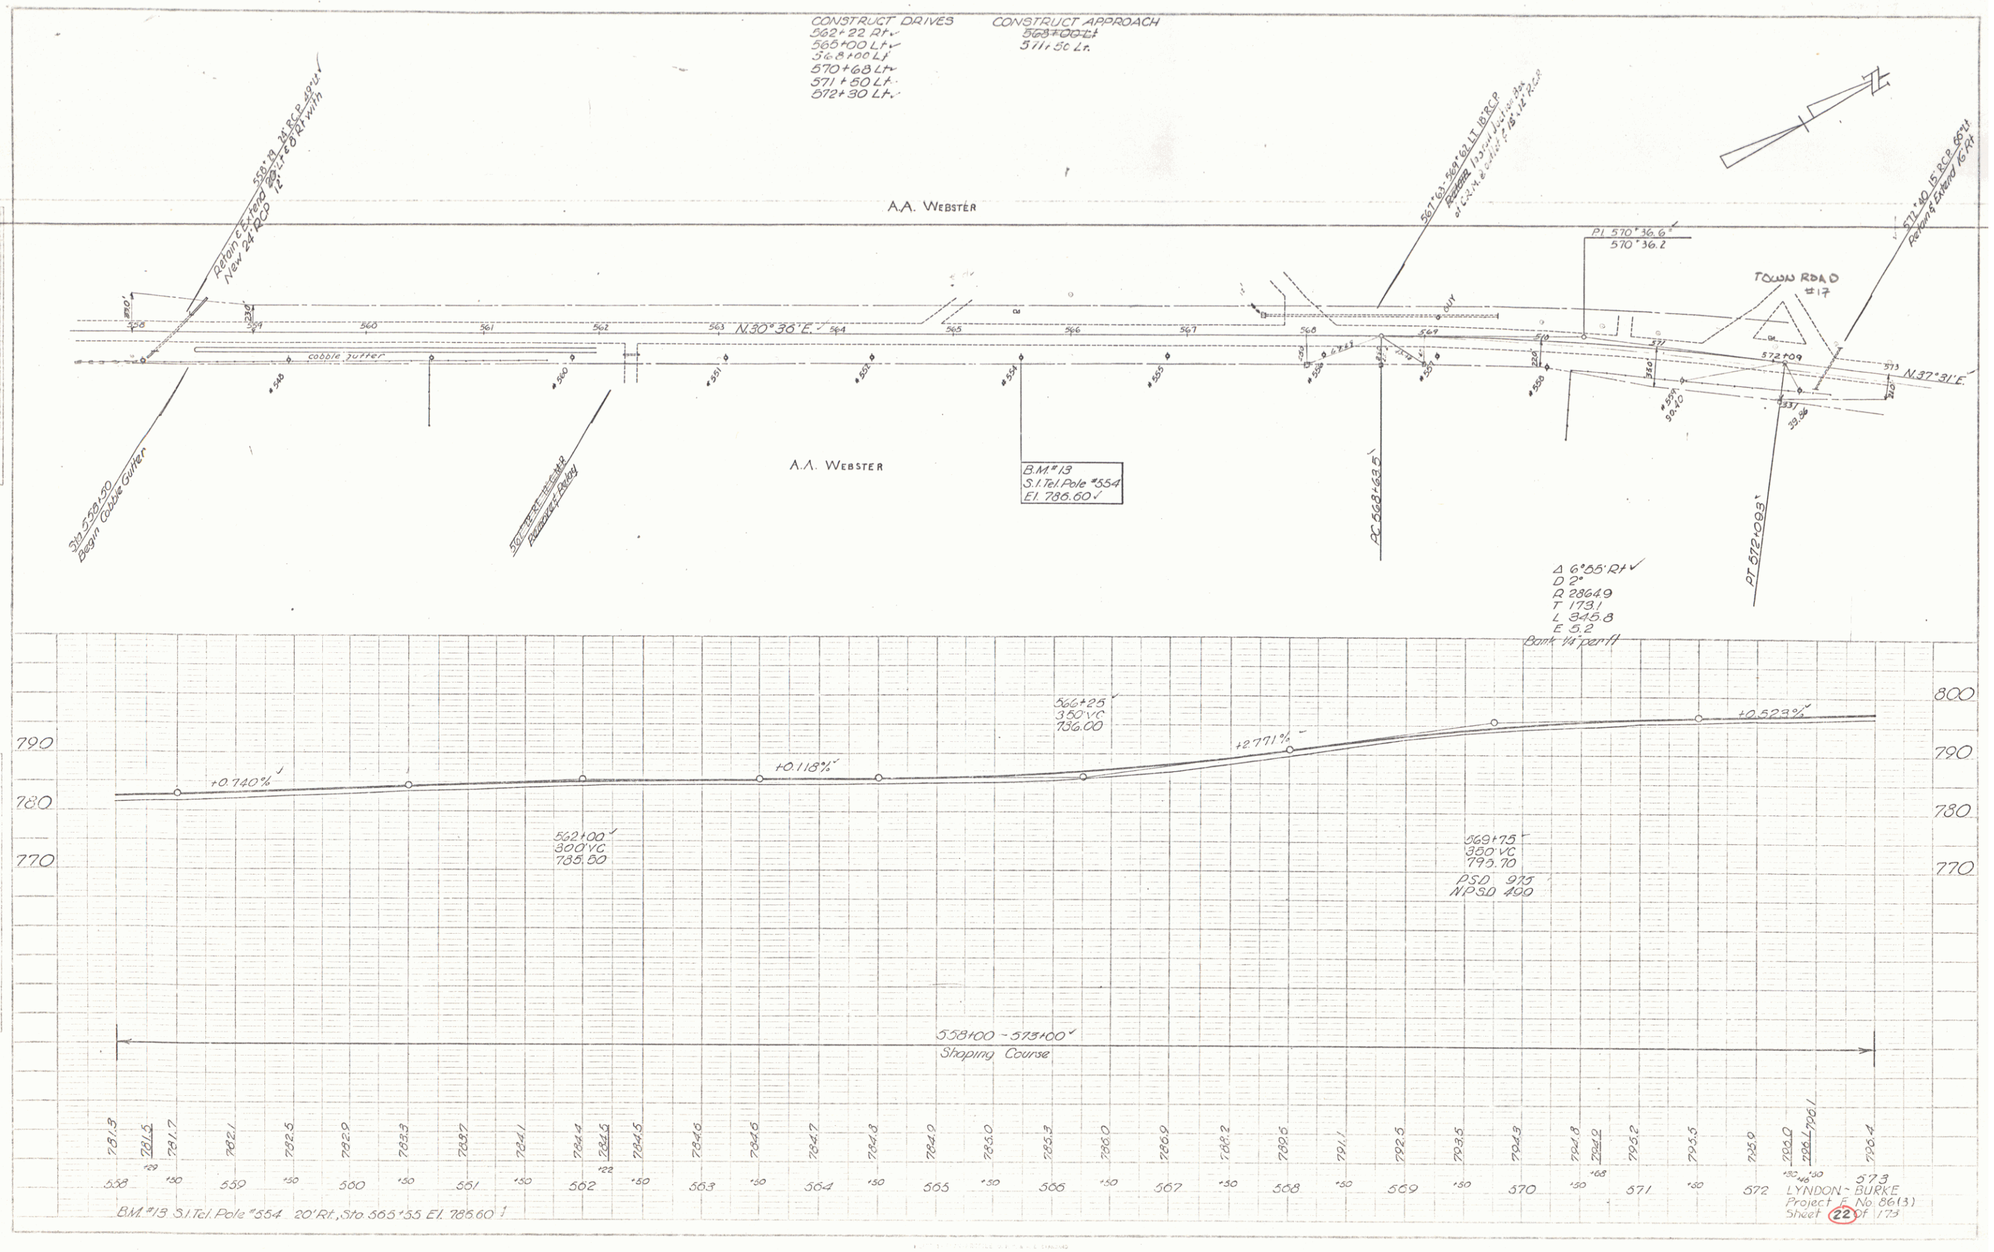
CONSTRUCT DRIVES
562+22 Rt
565+00 Lt
566+00 Lt
570+68 Lt
571+50 Lt
572+30 Lt
CONSTRUCT APPROACH
568+00 Lt
571+50 Lt
A.A. WEBSTER
N.30° 36' E.
cobble gutter
Sta 558+50
Begin Cobble Gutter
B.M. #13
S.I. Tel. Pole #554
El. 786.60
PC 568+63.8
PI 570+36.6
570+36.2
TOWN ROAD #17
572+09
N.37° 31' E.
PT 572+08
Δ 6°55' Rt
D 2°
R 2864.9
T 173.1
L 345.8
E 5.2
Bank 1¼" per ft
+0.740%
+0.118%
562+00
300' VC
785.50
566+25
350' VC
786.00
+2.771%
569+75
350' VC
790.70
PSD 975
NPSD 490
+0.523%
558+00 - 573+00
Shaping Course
B.M. #13 S.I. Tel. Pole #554 20' Rt., Sta. 565+55 El. 785.60
LYNDON - BURKE
Project F No. 86(3)
Sheet 22 of 173