TWO CABLE GUARD RAIL
~~575+20 - 580+64 RT~~
575+20 - 580+64 RT

CONSTRUCT DRIVES
573+50 Lt.
574+26 Lt.
575+25 Lt.
580+85 Rt

REMOVAL & DISPOSAL OF PRESENT GUARD RAIL
~~580+30 - 581+82~~
573+45 - 579+82 Rt.

WOOD GUIDE POSTS
Lt 16' ea
575+80 - 579+96

CONSTRUCT APPROACH
572+30 Lt

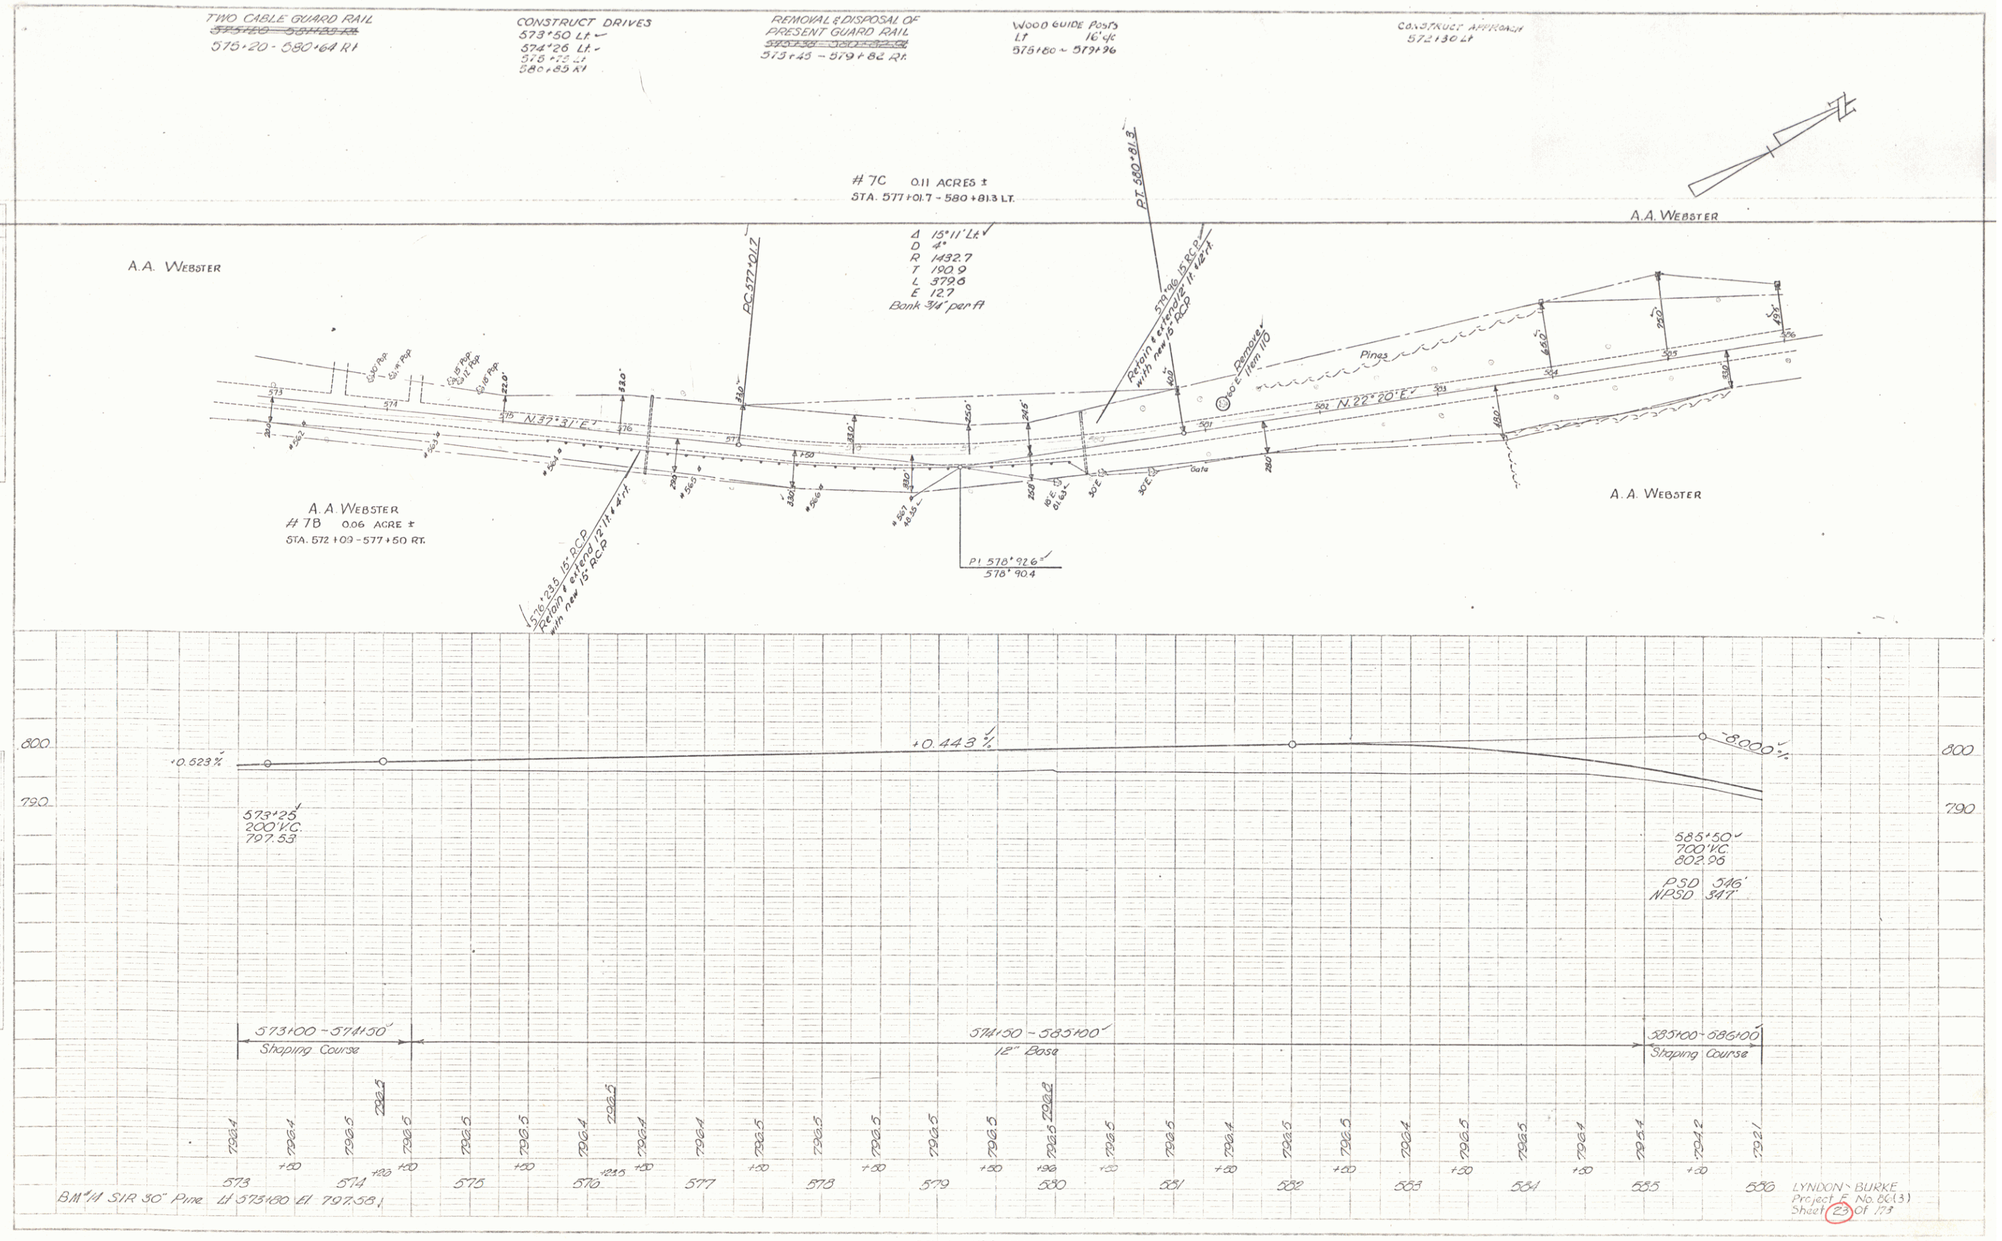

LYNDON - BURKE
Project F No. 86(3)
Sheet 23 of 73

12