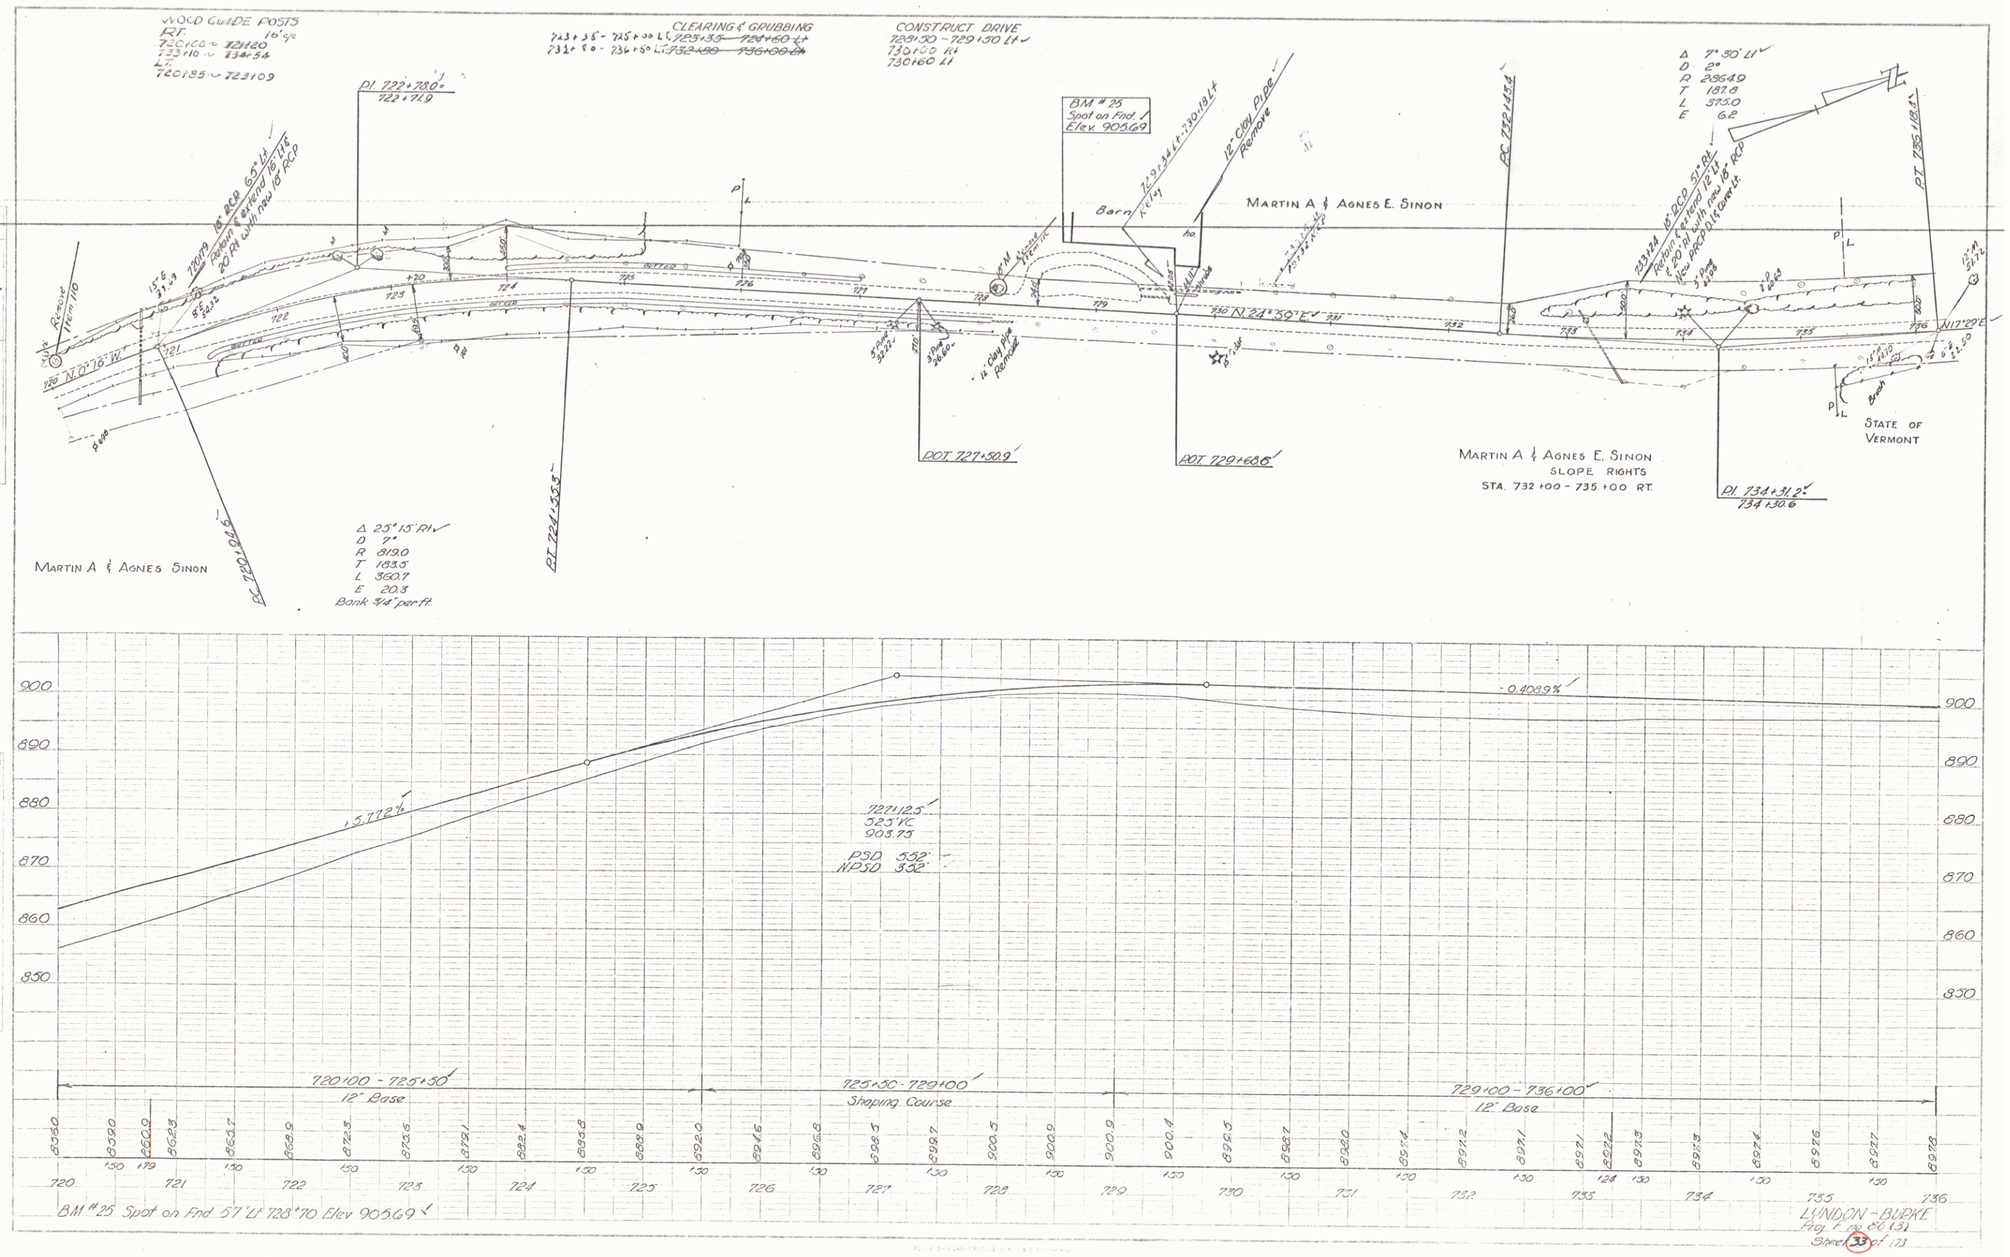
WOOD GUIDE POSTS
RT.
730+60 ~ 721+20
733+10 ~ 734+54
LT.
720+85 ~ 723+09
CLEARING & GRUBBING
723+35 - 725+00 Lt. 723+35 - 724+60 Lt
732+80 - 736+50 Lt. 732+80 - 736+00 Lt
CONSTRUCT DRIVE
729+30 - 729+50 Lt
730+00 Rt
730+60 Lt
PI 722+780
722+71.9
BM # 25
Spot on Fnd.
Elev. 905.69
12" Clay Pipe Remove
Barn
MARTIN A & AGNES E. SINON
PC 732+14.54
PT 735+18.41
Δ 7° 30' Lt
D 2°
R 2864.9
T 187.8
L 375.0
E 6.2
N 0°16' W
N 24°39' E
N 17°20' E
POT 727+50.9
POT 729+68.6
MARTIN A & AGNES E. SINON
SLOPE RIGHTS
STA. 732+00 - 735+00 RT.
PI 734+31.2
734+30.6
STATE OF VERMONT
Brush
MARTIN A & AGNES SINON
PC 720+06.6
PT 724+55.5
Δ 25° 15' Rt
D 7°
R 819.0
T 183.5
L 360.7
E 20.3
Bank 3/4 per ft.
-0.409%
+5.772%
727+12.5
5.25% VC
903.79
PSD 3.52
NPSD 3.92
720+00 - 725+50
12" Base
725+50 - 729+00
Shaping Course
729+00 - 736+00
12" Base
BM #25 Spot on Fnd. 57' Lt 728+70 Elev 905.69
LYNDON - BURKE
Proj. F 019-2 (3)
Sheet 33 of 173

22