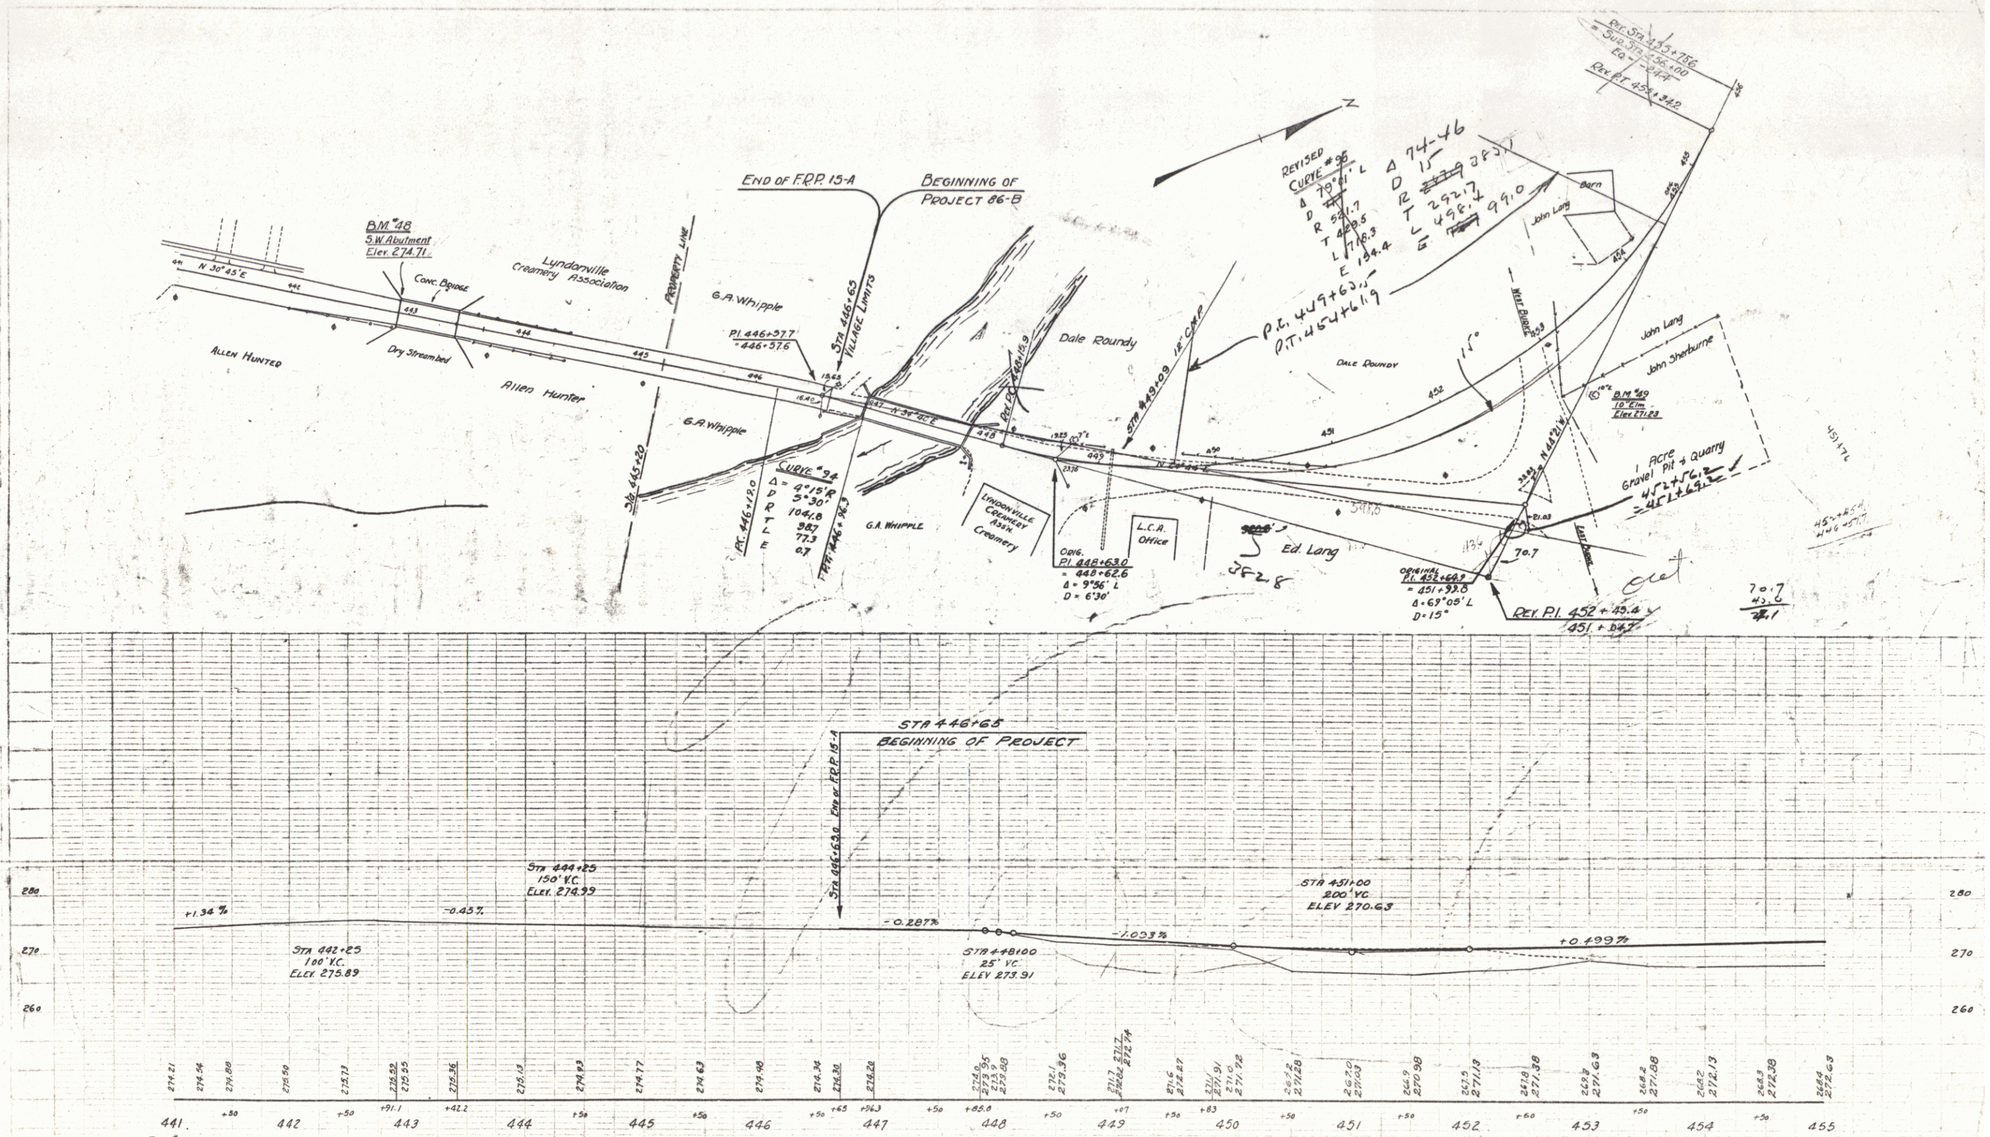
END OF F.D.P. 15-A
BEGINNING OF PROJECT 86-B
B.M. "48" S.W. Abutment Elev. 274.71
Conc. Bridge
Lyndonville Creamery Association
PROPERTY LINE
G.A. Whipple
P.I. 446+37.7 = 446+57.6
STA. 446+65 VILLAGE LIMITS
Dry Streambed
ALLEN HUNTER
Allen Hunter
Dale Roundy
18" CMP
P.C. 449+63.1
P.T. 454+61.9
DALE ROUNDY
Barn
John Lang
John Sherburne
B.M. "49" 10" Elm Elev. 271.23
1 Acre Gravel Pit + Quarry
LYNDONVILLE CREAMERY ASSN. Creamery
L.C.A. Office
Ed. Lang
Culv. P.I. 448+63.0 = 448+62.6 Δ = 9°36' L D = 6°30'
Culv. P.I. 452+69.9 = 451+93.0 Δ = 69°05' L D = 15°
Rev. P.I. 452+49.4
451+047
STA. 446+65 BEGINNING OF PROJECT
STA. 444+25 150' V.C. ELEV. 274.99
STA. 442+25 100' V.C. ELEV. 275.89
STA. 448+00 25' V.C. ELEV. 273.91
STA. 451+00 200' V.C. ELEV. 270.63
+1.34%
-0.43%
-0.28%
-1.03%
+0.49%
441 442 443 444 445 446 447 448 449 450 451 452 453 454 455
B.M. "48" S.W. corner bridge abutment Sta. 442+92 Lt. Elev. 274.71
B.M. "49" Spike in root 10" Elm Sta. 453+26, 34' Rt. Elev. 271.23

SHEET 4A OF

3