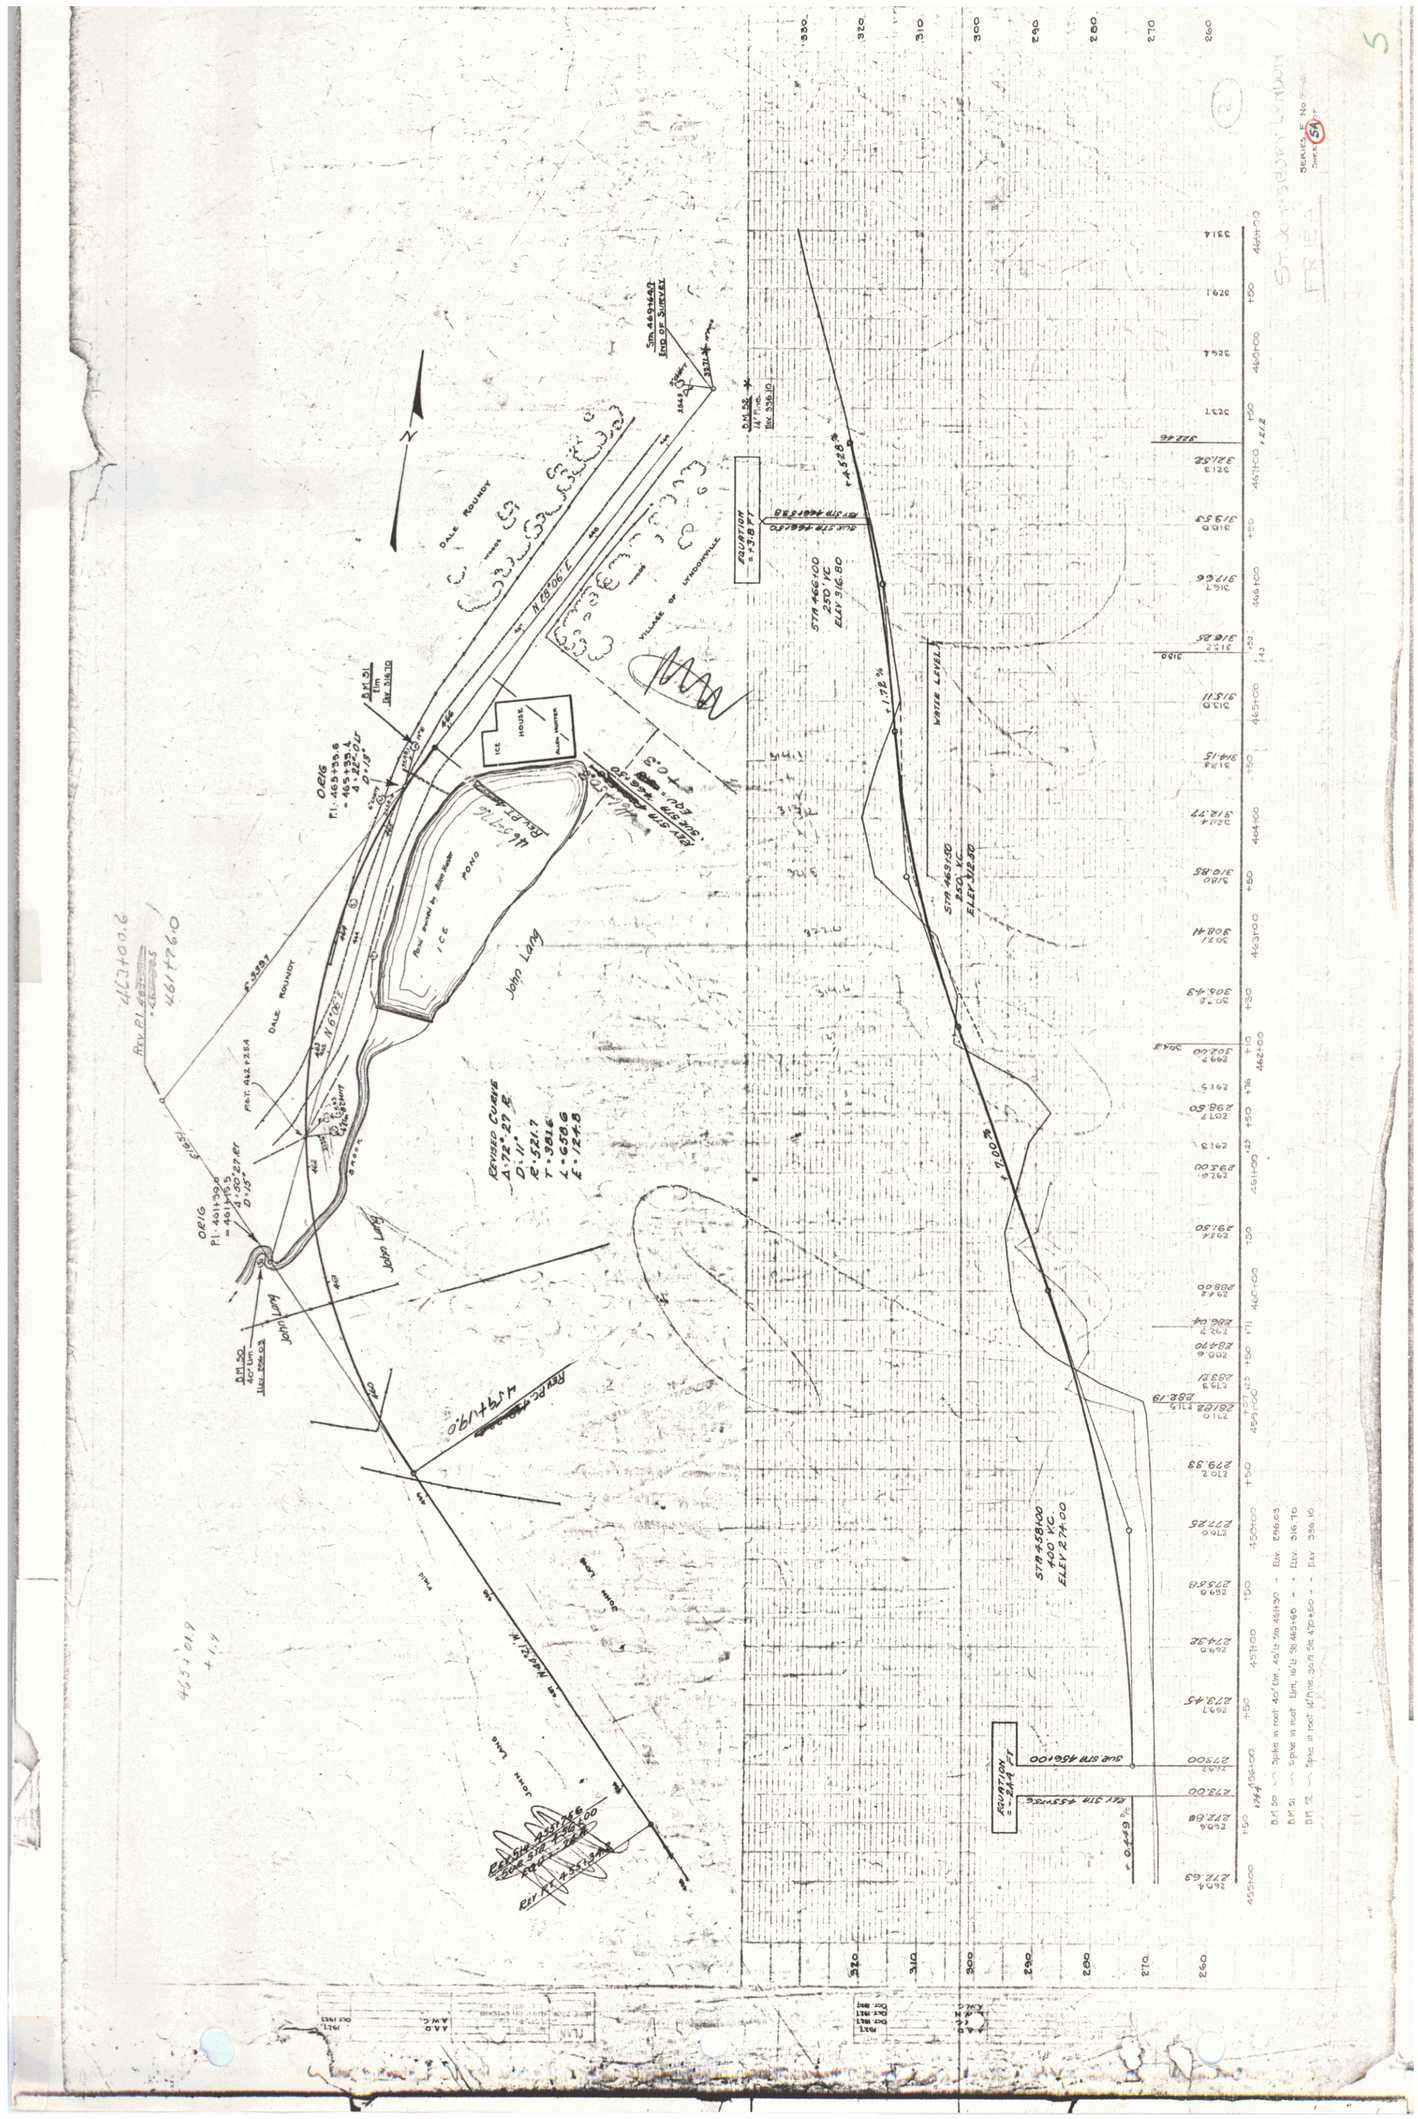
DALE ROUNDUP
VILLAGE OF LYNDONVILLE
ICE HOUSE
ICE POND
John Lang
Sm 469+63
End of Survey
EQUATION = -2.84 FT
STA 466+00
250' VC
ELEV 316.80
STA 458+00
400' VC
ELEV 274.00
WATER LEVEL
REVISED CURVE
Δ: 72°27' E
D: 11°
R: 521.7
T: 381.6
L: 658.6
E: 124.8
ORIG
PI: 461+39.0
= 461+65.5
D: 10°
ORIG
PI: 465+39.8
= 465+25.1
D: 18°
Rev. PI
= 461+65.5
D: 10°
STA 462+25.4
DALE ROUNDUP
Rev. PI
= 465+25.1
D: 18°
Rev. PI
= 461+65.5
D: 10°