Wood Guide Posts

Culv. Sta.	Left	Right
694+00	1	–

Cable Guard Rail Required

Stations	Leng.	Const.	Ray. leng.
698+00-698+20 Rt.	520	40	560'
697+00 Lt.	48	40	88
701+60-704+00 Lt.	240	20	260

New Reinf. Conc. Pipe Culverts Required

Station	Diam.	Leng.	Conc. R. 1.8 cy.	Steel 157#	C.R.M.
697+00					1.2 cy.
694+00	15"	36'	–	–	2.3 cy.

Parcel	Kind of Instrument	Date of Instrument	Grantor	Grantee	Recorded Burke Book	Page	Date	Remarks
C' Culv. "1a" 2	Q.C.D.	8-9-32	C.M. Darling	St. of W.	190	154	8-31-32	Culv. Sta. 694+00
D	"	2-4-32	C.H. & J. Batchholder	" "	18	306	3-17-32	& 697+00.
A'	W.D.	2-4-32	C.H. & J. Batchholder	" "	190	60	3-17-32	

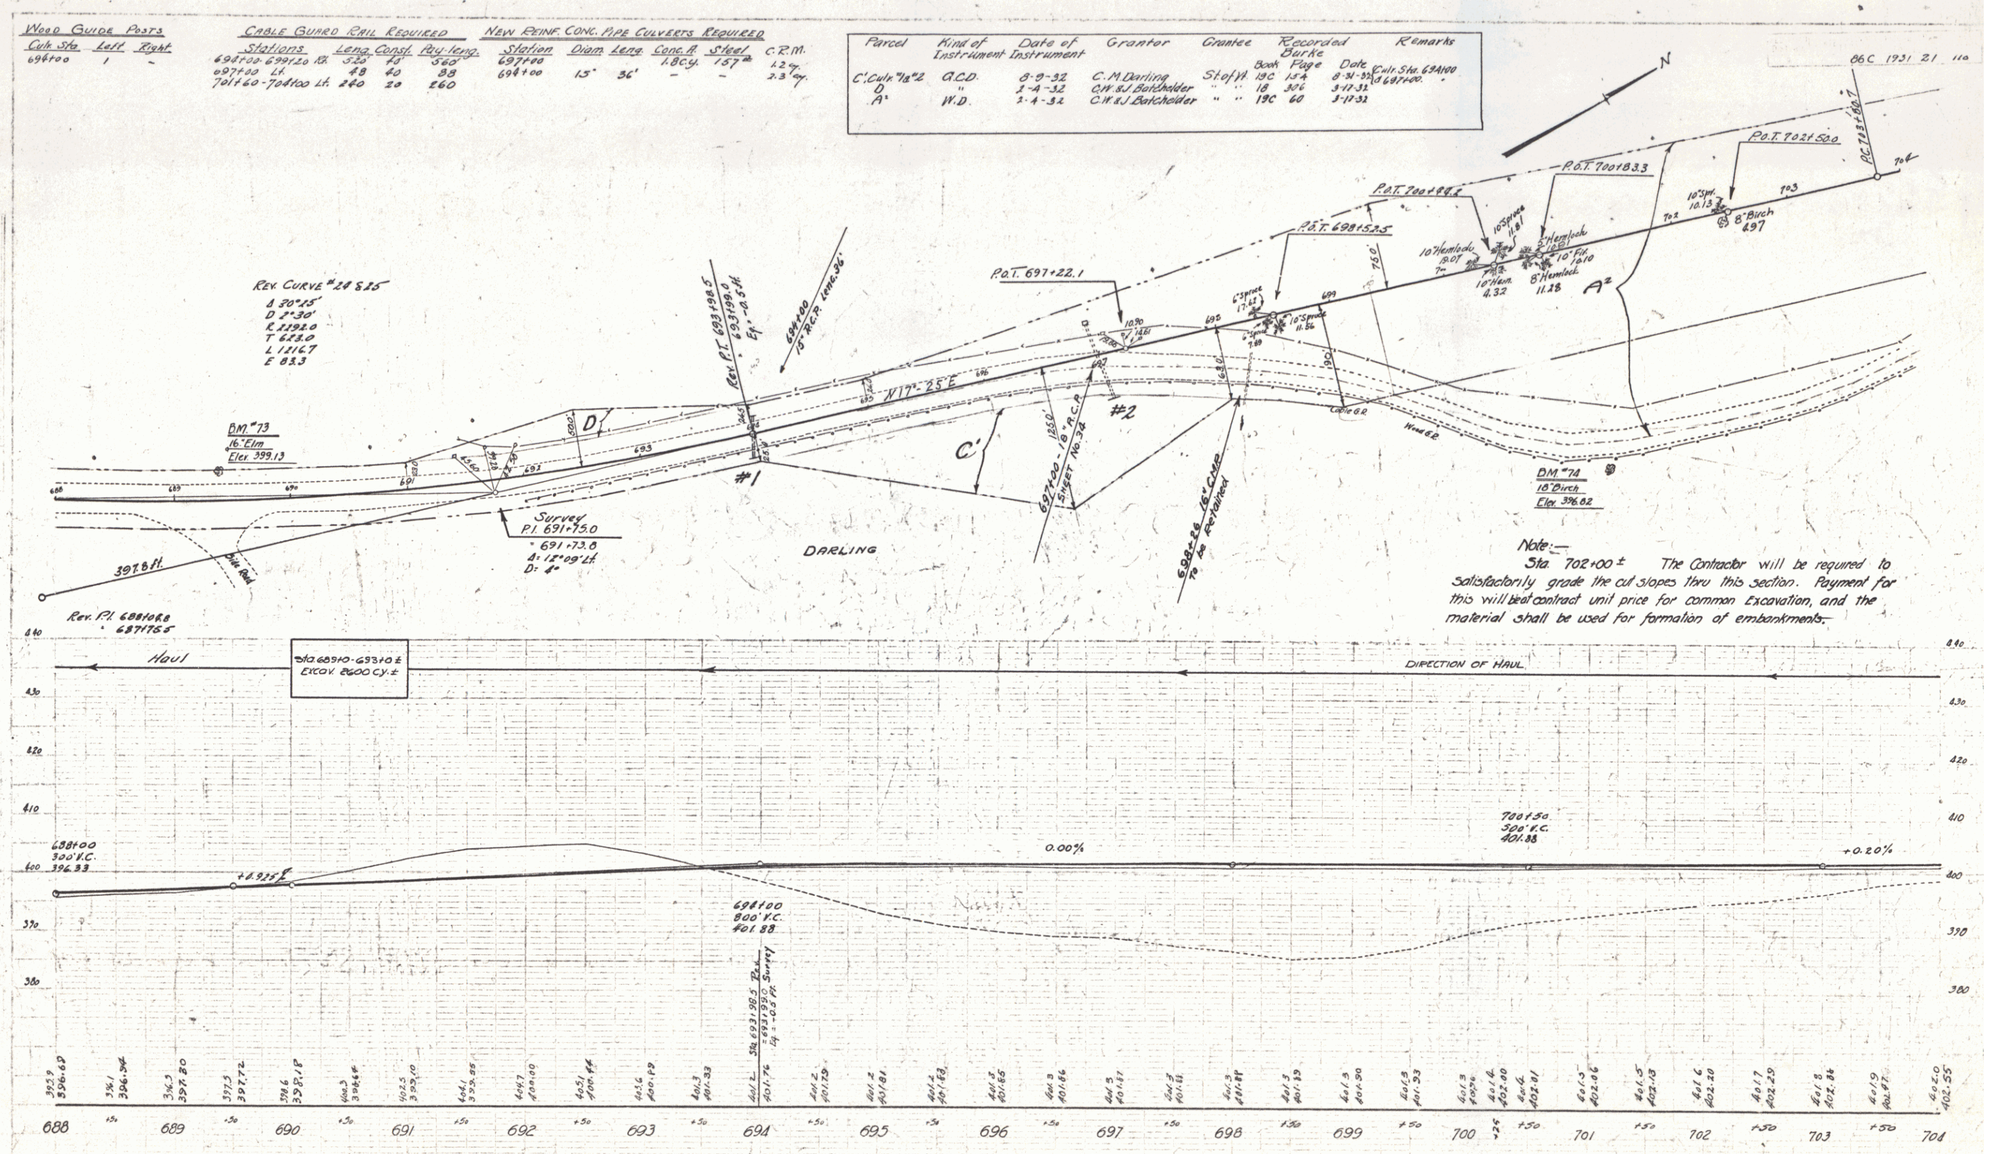

Series F No. 86C
Sheet 21 of 110

21