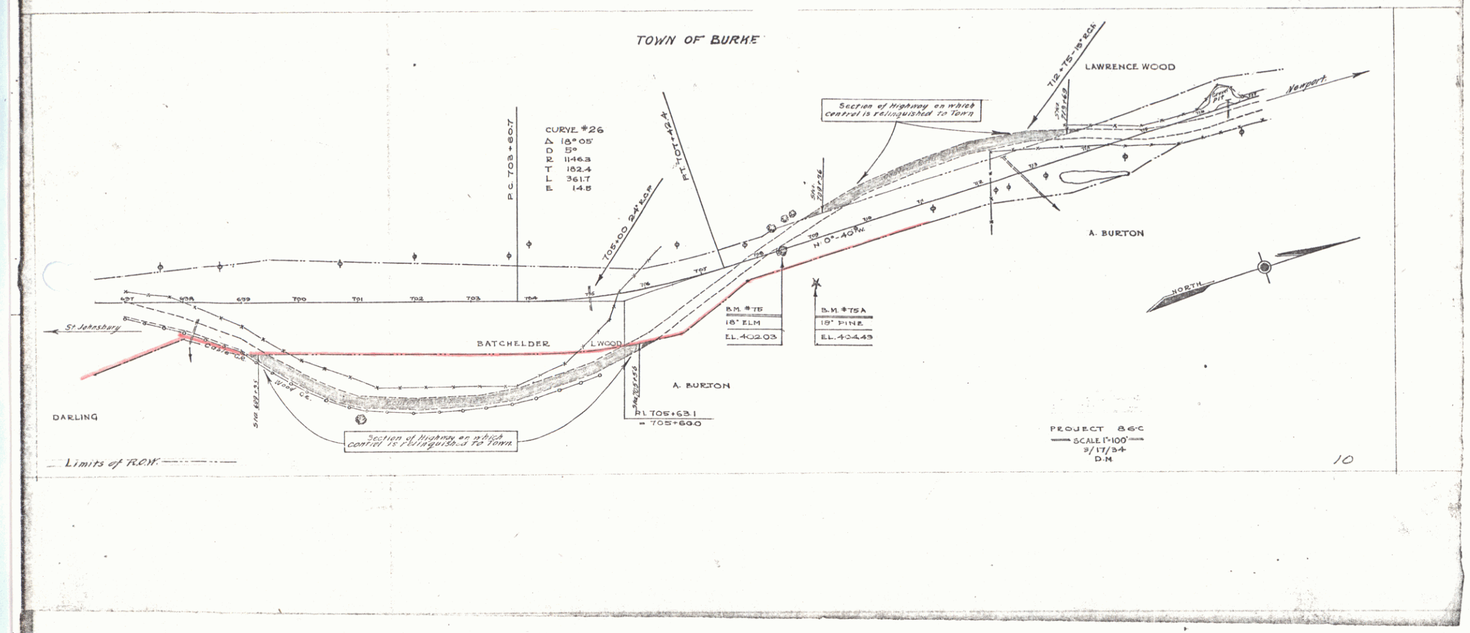
TOWN OF BURKE
LAWRENCE WOOD
Section of Highway on which control is relinquished to Town
CURVE #26
Δ 18°05'
D 5°
R 1146.3
T 182.4
L 361.7
E 14.8
P.C. 705+80.7
P.T. 707+42.4
705+00 24'+00'
N 0°-40' W.
A. BURTON
NORTH
B.M. #75
18" ELM
EL. 402.03
B.M. #75A
18" PINE
EL. 404.49
St Johnsbury
BATCHELDER
L. WOOD
A. BURTON
DARLING
P.T. 705+63.1
= 705+60.0
Section of Highway on which control is relinquished to Town
Limits of R.O.W.
PROJECT 86-C
SCALE 1"=100'
3/17/34
D.H.
10

22A

23