


Town: Burke
 Route: US 5
 Project: F&C

FED. ROAD DIST. NO.	STATE	PROJ. NO.	YEAR	SHEET NO.	TOTAL SHEETS
9	VT.				

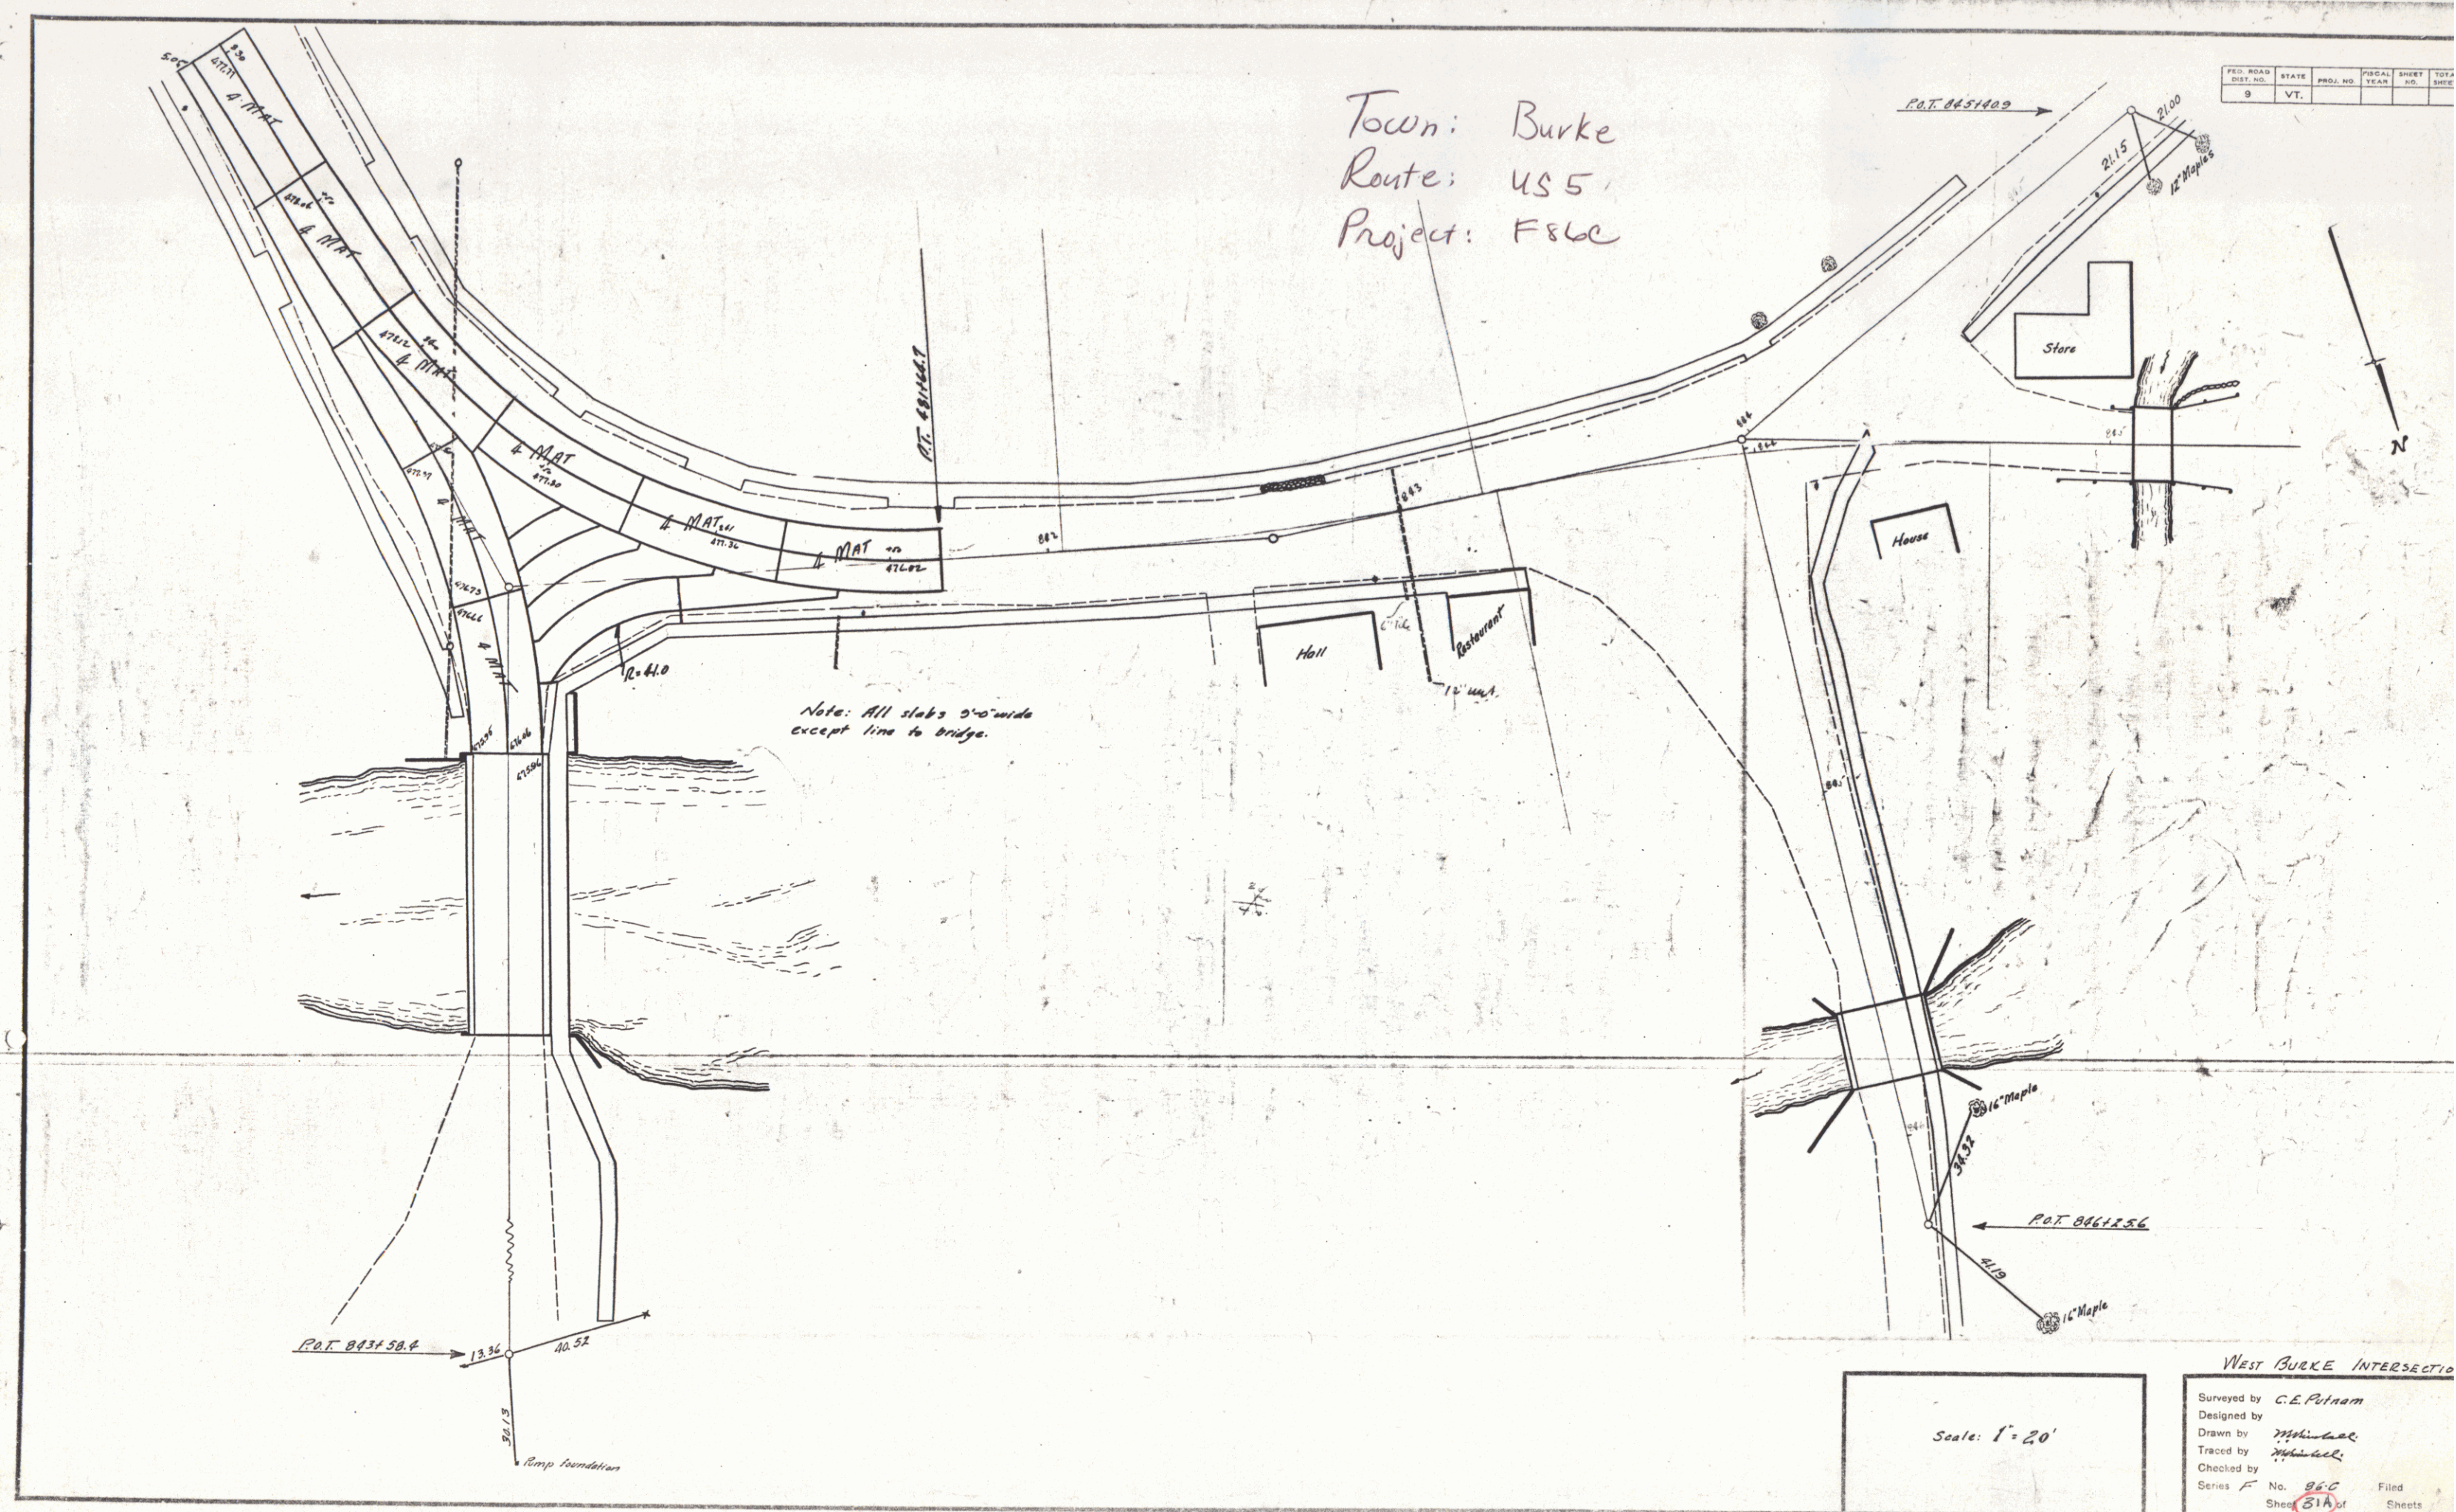

Note: All slabs 9'-0" wide except line to bridge.

Scale: 1" = 20'

WEST BURKE INTERSECTION

Surveyed by C.E. Pinnam
 Designed by
 Drawn by
 Traced by
 Checked by
 Series F No. 86-C Filed
 Sheet 51A of Sheets