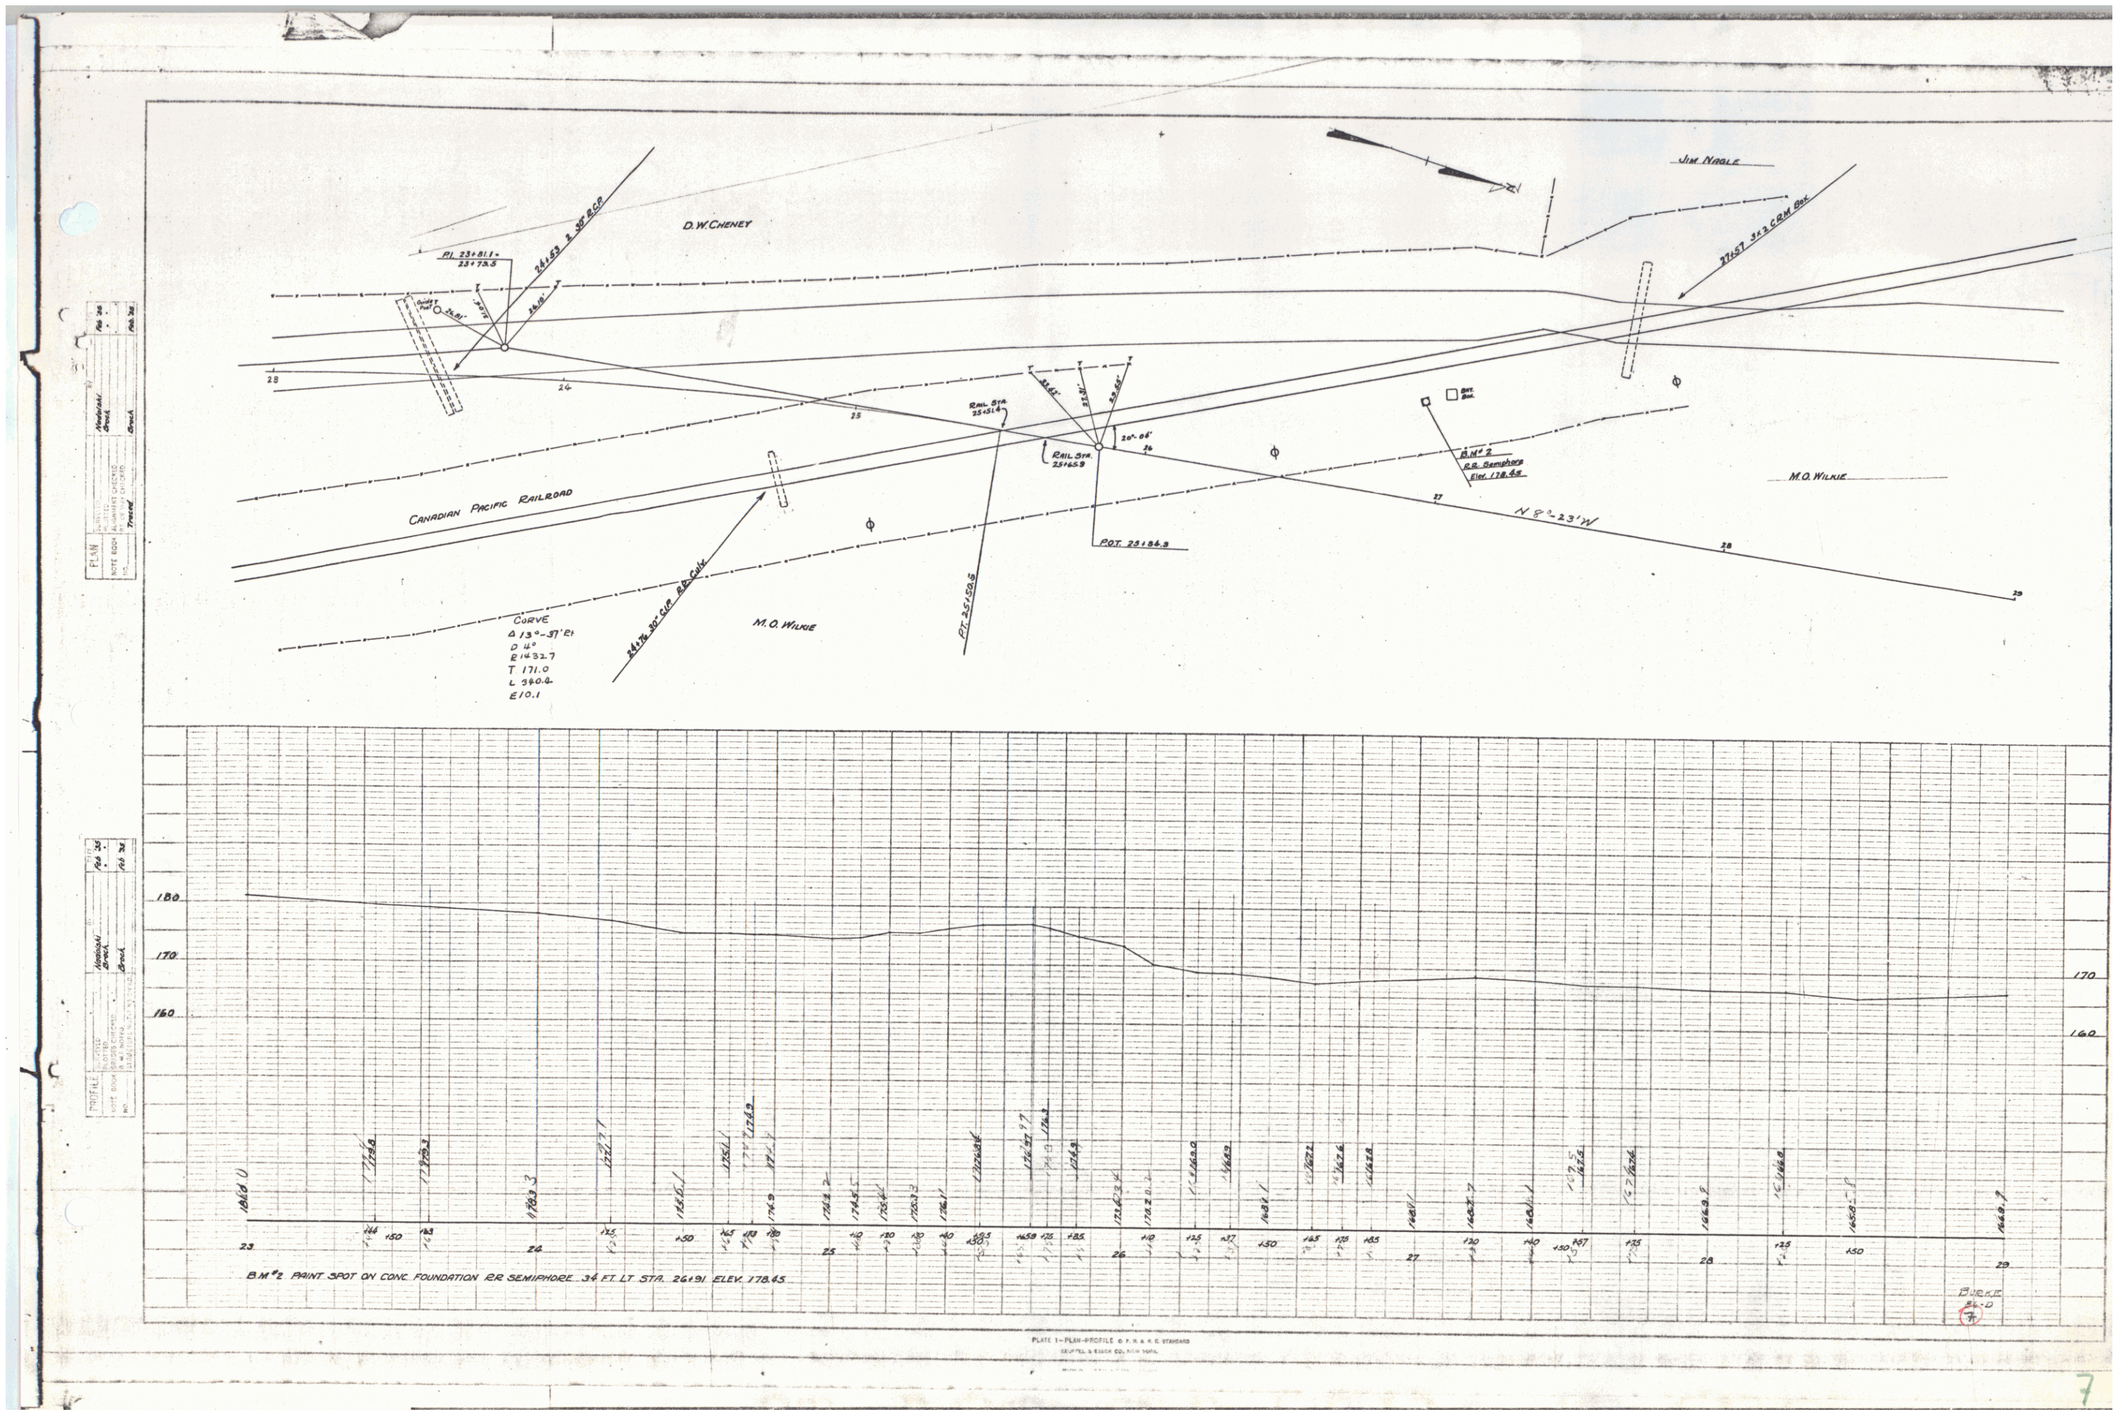

PLATE 1—PLAN-PROFILE © P. R. & R. E. STANDARD
SEUFFEL & GRAGE CO. NEW YORK.

BUCKE
EL-D
7