



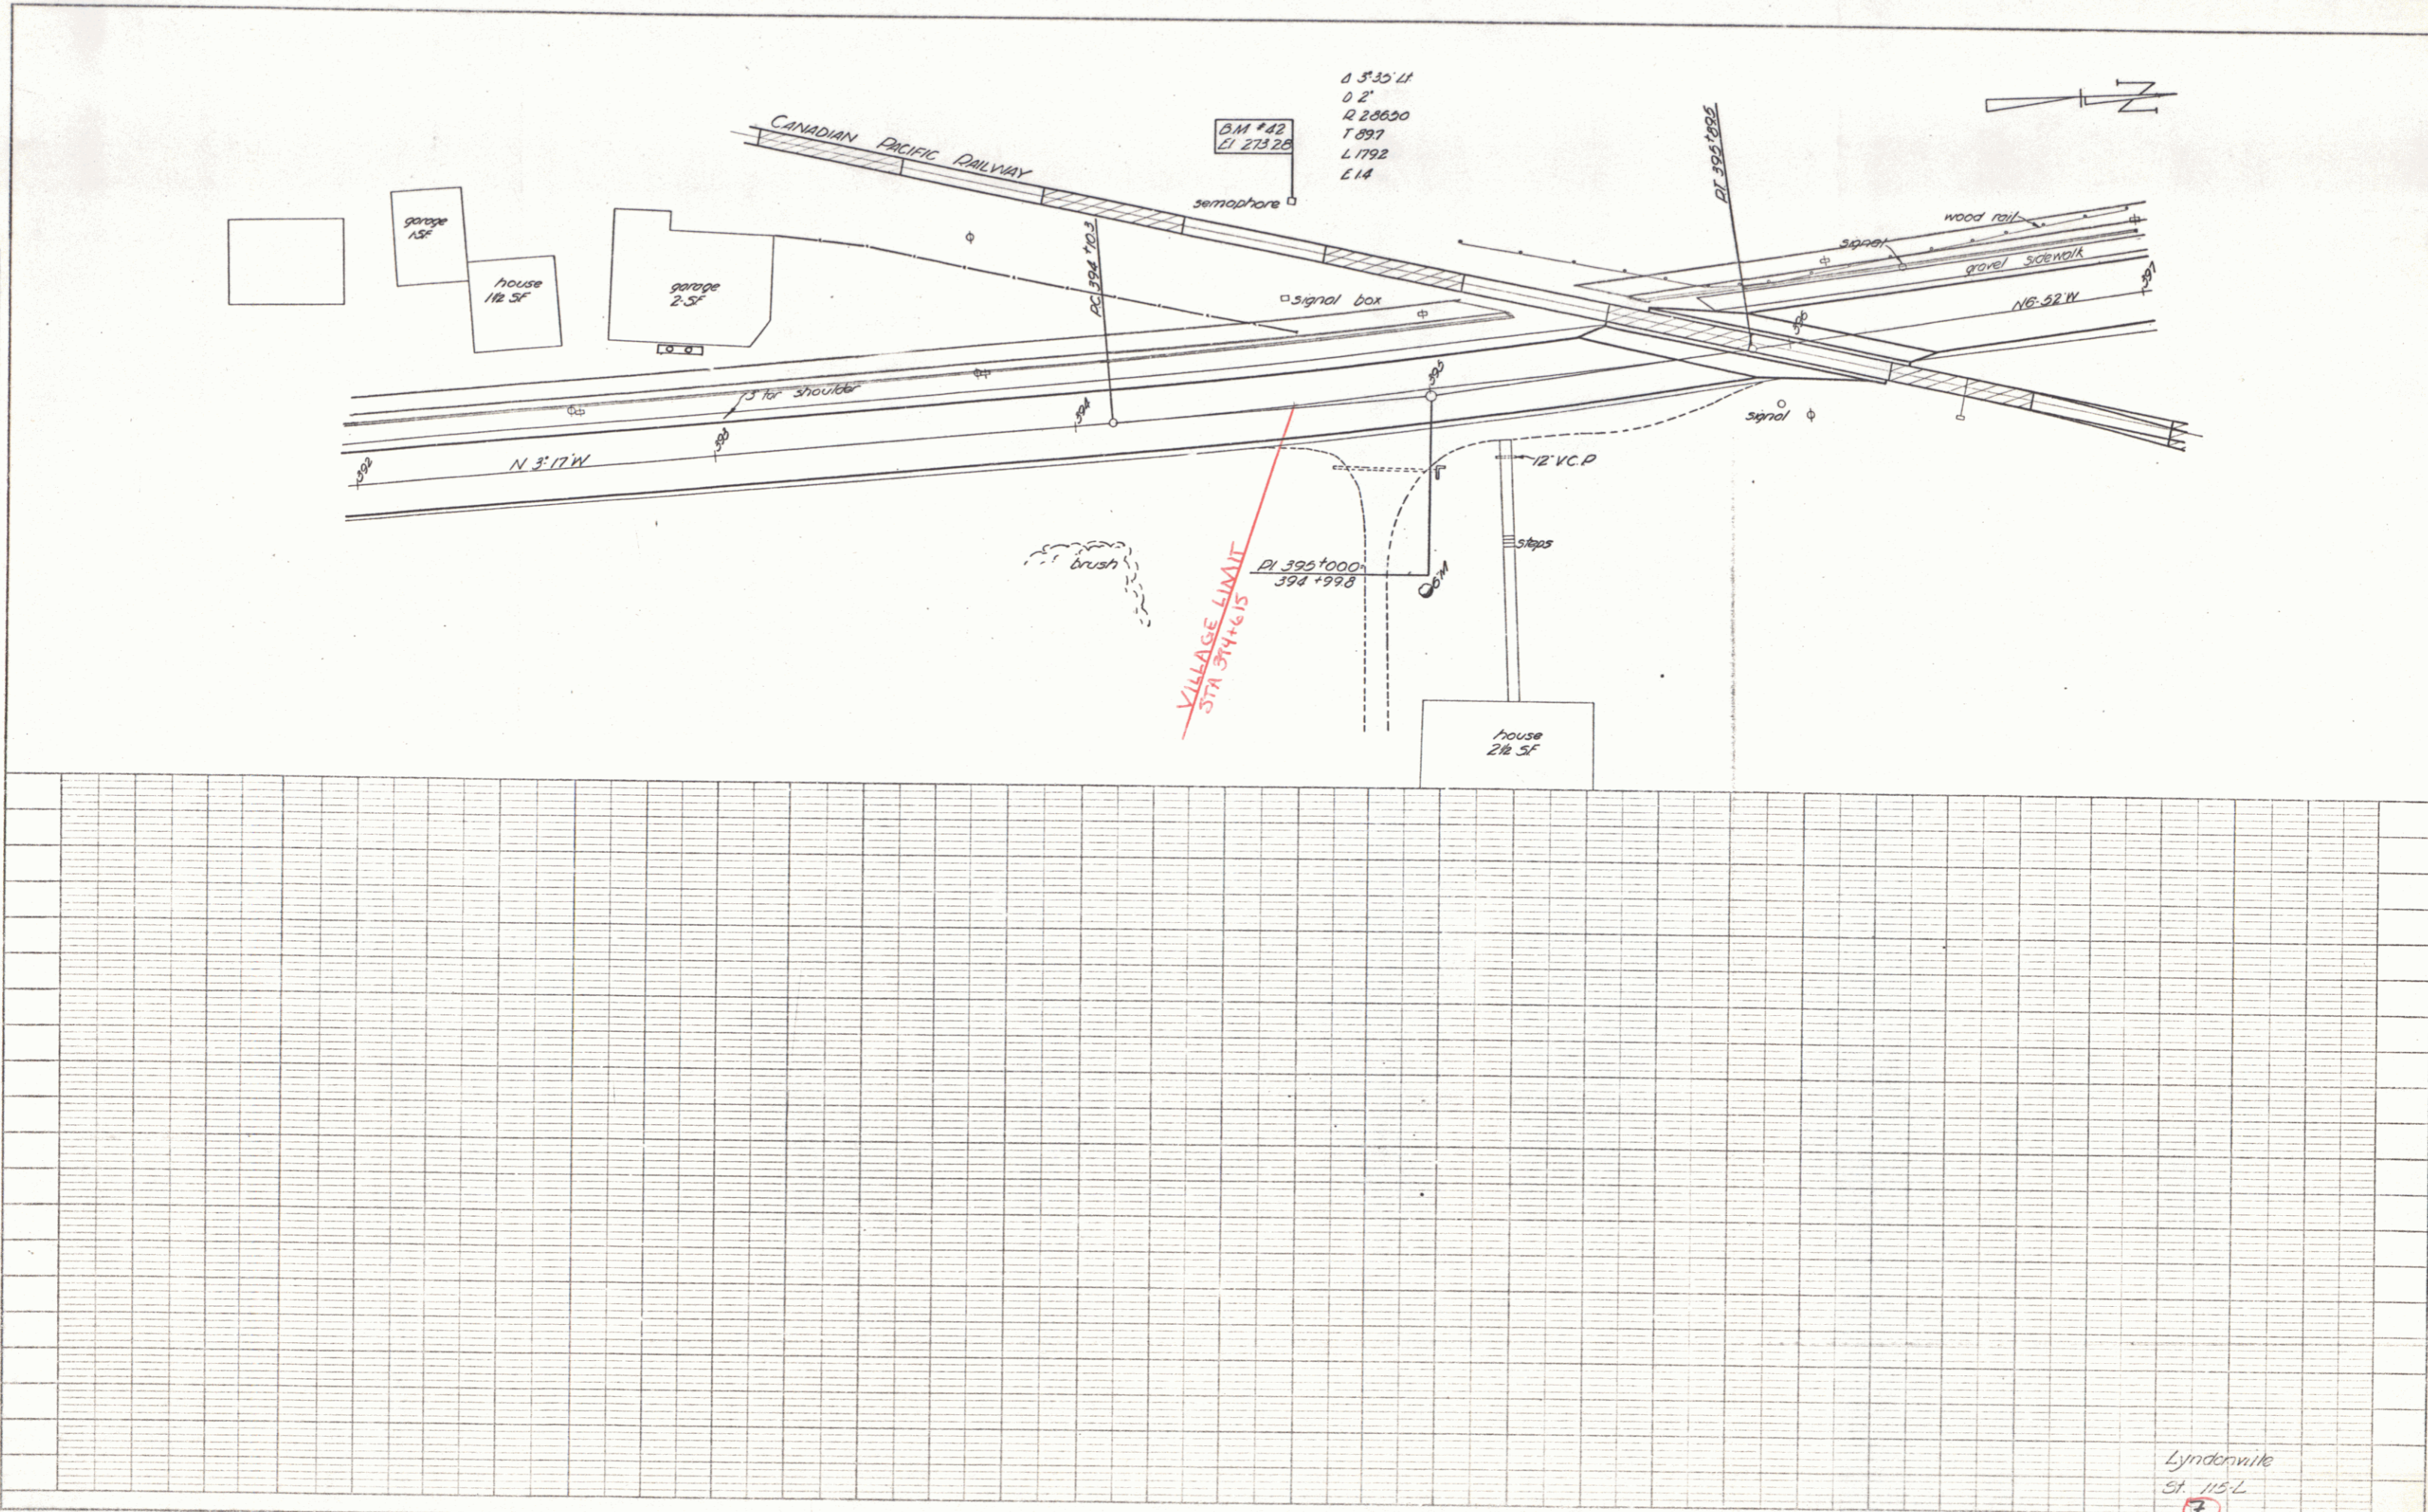



Lyndonville  
 St. 115-L

#6  
 7