FED. ROAD DIST. NO.	STATE	F.A.G.H. PROJ. NO.	FISCAL YEAR	SHEET NO.	TOTAL SHEETS
3	VT.	115-E	1938	2	5

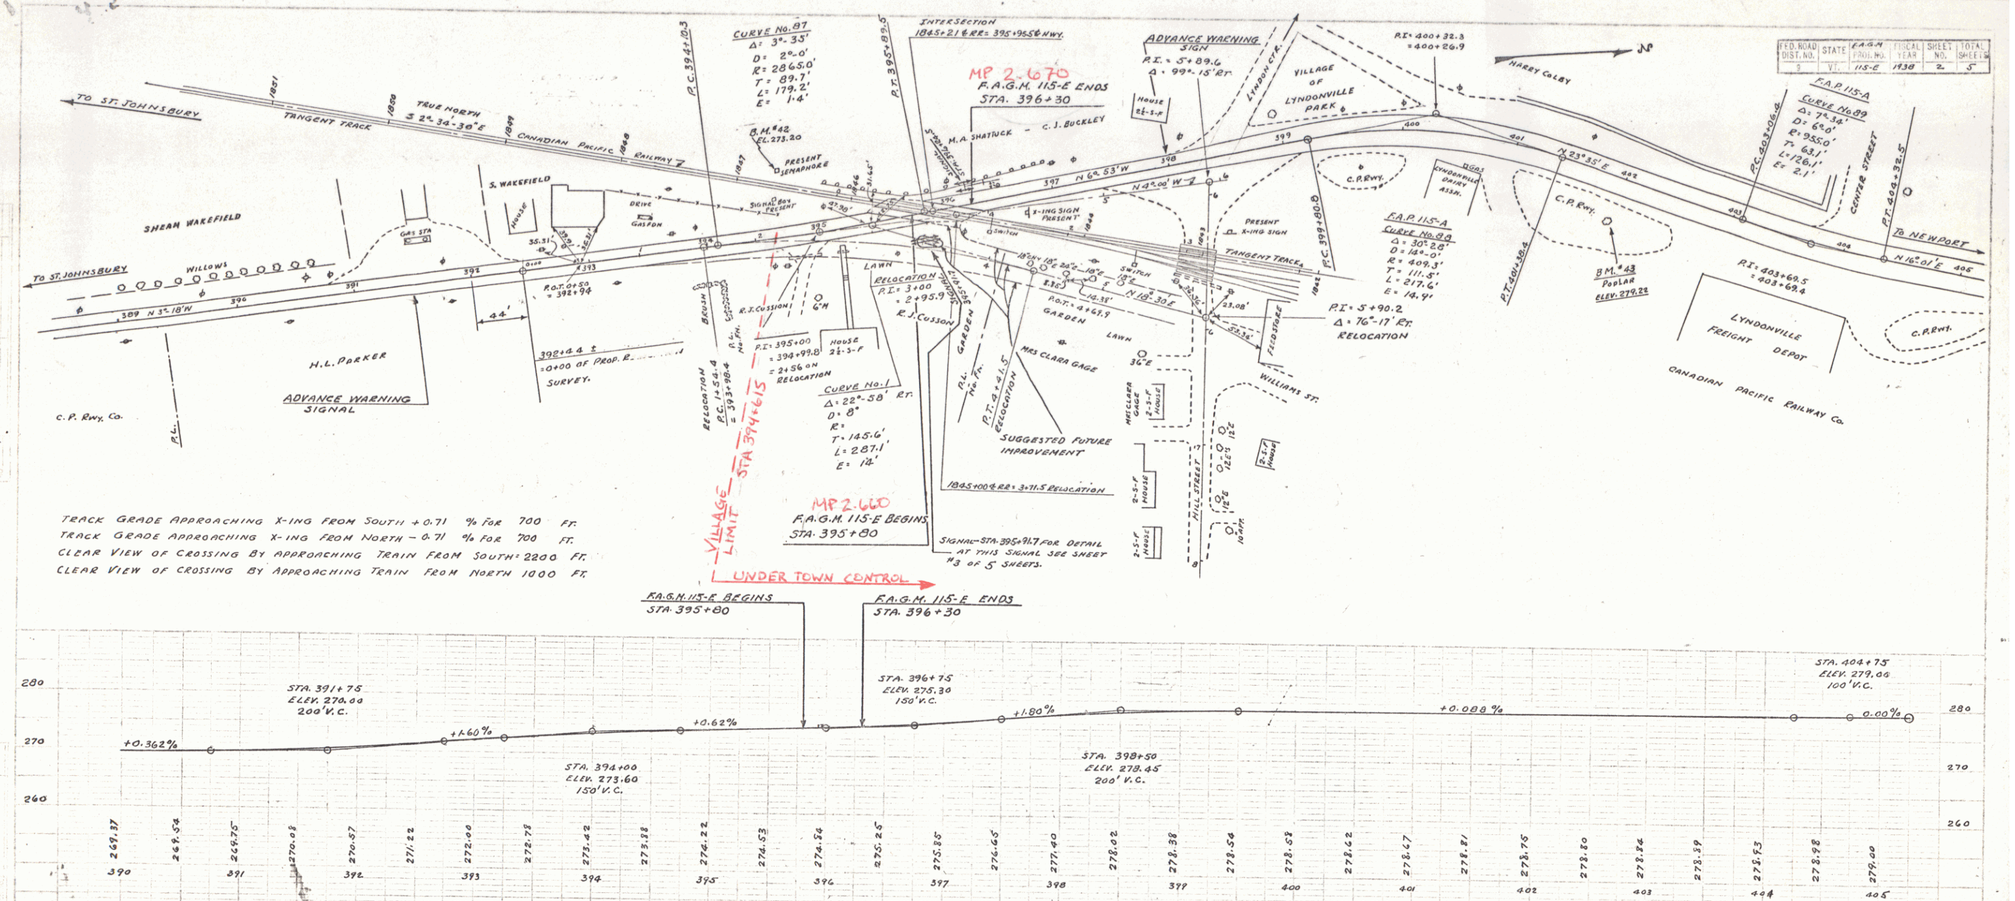

ADVANCED WARNING SIGNS WILL BE ERECTED, IF THEY ARE NOT ALREADY IN PLACE, IN ACCORDANCE WITH "MANUAL ON UNIFORM TRAFFIC CONTROL DEVICES ON STREETS AND HIGHWAYS." (1934)

AUTOMATIC FLASH SIGNAL
GRADE CROSSING AT LYNDONVILLE
OVER
CANADIAN PACIFIC RAILWAY

VT. F.A.G.H.-115-E — LYNDON, VT
ROUTE U.S. 5 — STA. 396+00

SHEET 2 OF 5 SHEETS

9