

POOR ORIGINAL COPY

REMOVAL AND DISPOSAL OF PREVIOUS
GUARD RAIL, ITEM 549

VERTICAL GRANITE CURB, ITEM 556-B
445+00 - 446+36 2'

CONSTRUCT DRIVE
445+50 LT

BITUMINOUS CONCRETE
SIDEWALK, ITEM 562
445+00 - 446+36 2'


THREE CABLE GUARD RAIL
WITH STEEL POSTS, ITEM 542
445+00 - 446+22 2'
445+71 - 446+51 2'

STANDARD STEEL BEAM GUARD RAIL
W/ STEEL POSTS, ITEM 545-A

BEGIN PROJECT BP 041-5-6603 R.O.W.
END PROJECT SA 6810 R.O.W.
STA 444+96
SEE SHEET No. 3

END PROJECT BP 041-5-6603 R.O.W.
STA 449+06

NOTE: SEE SHEET No. 3
FOR PROJECT CONSTRUCTION
DATA

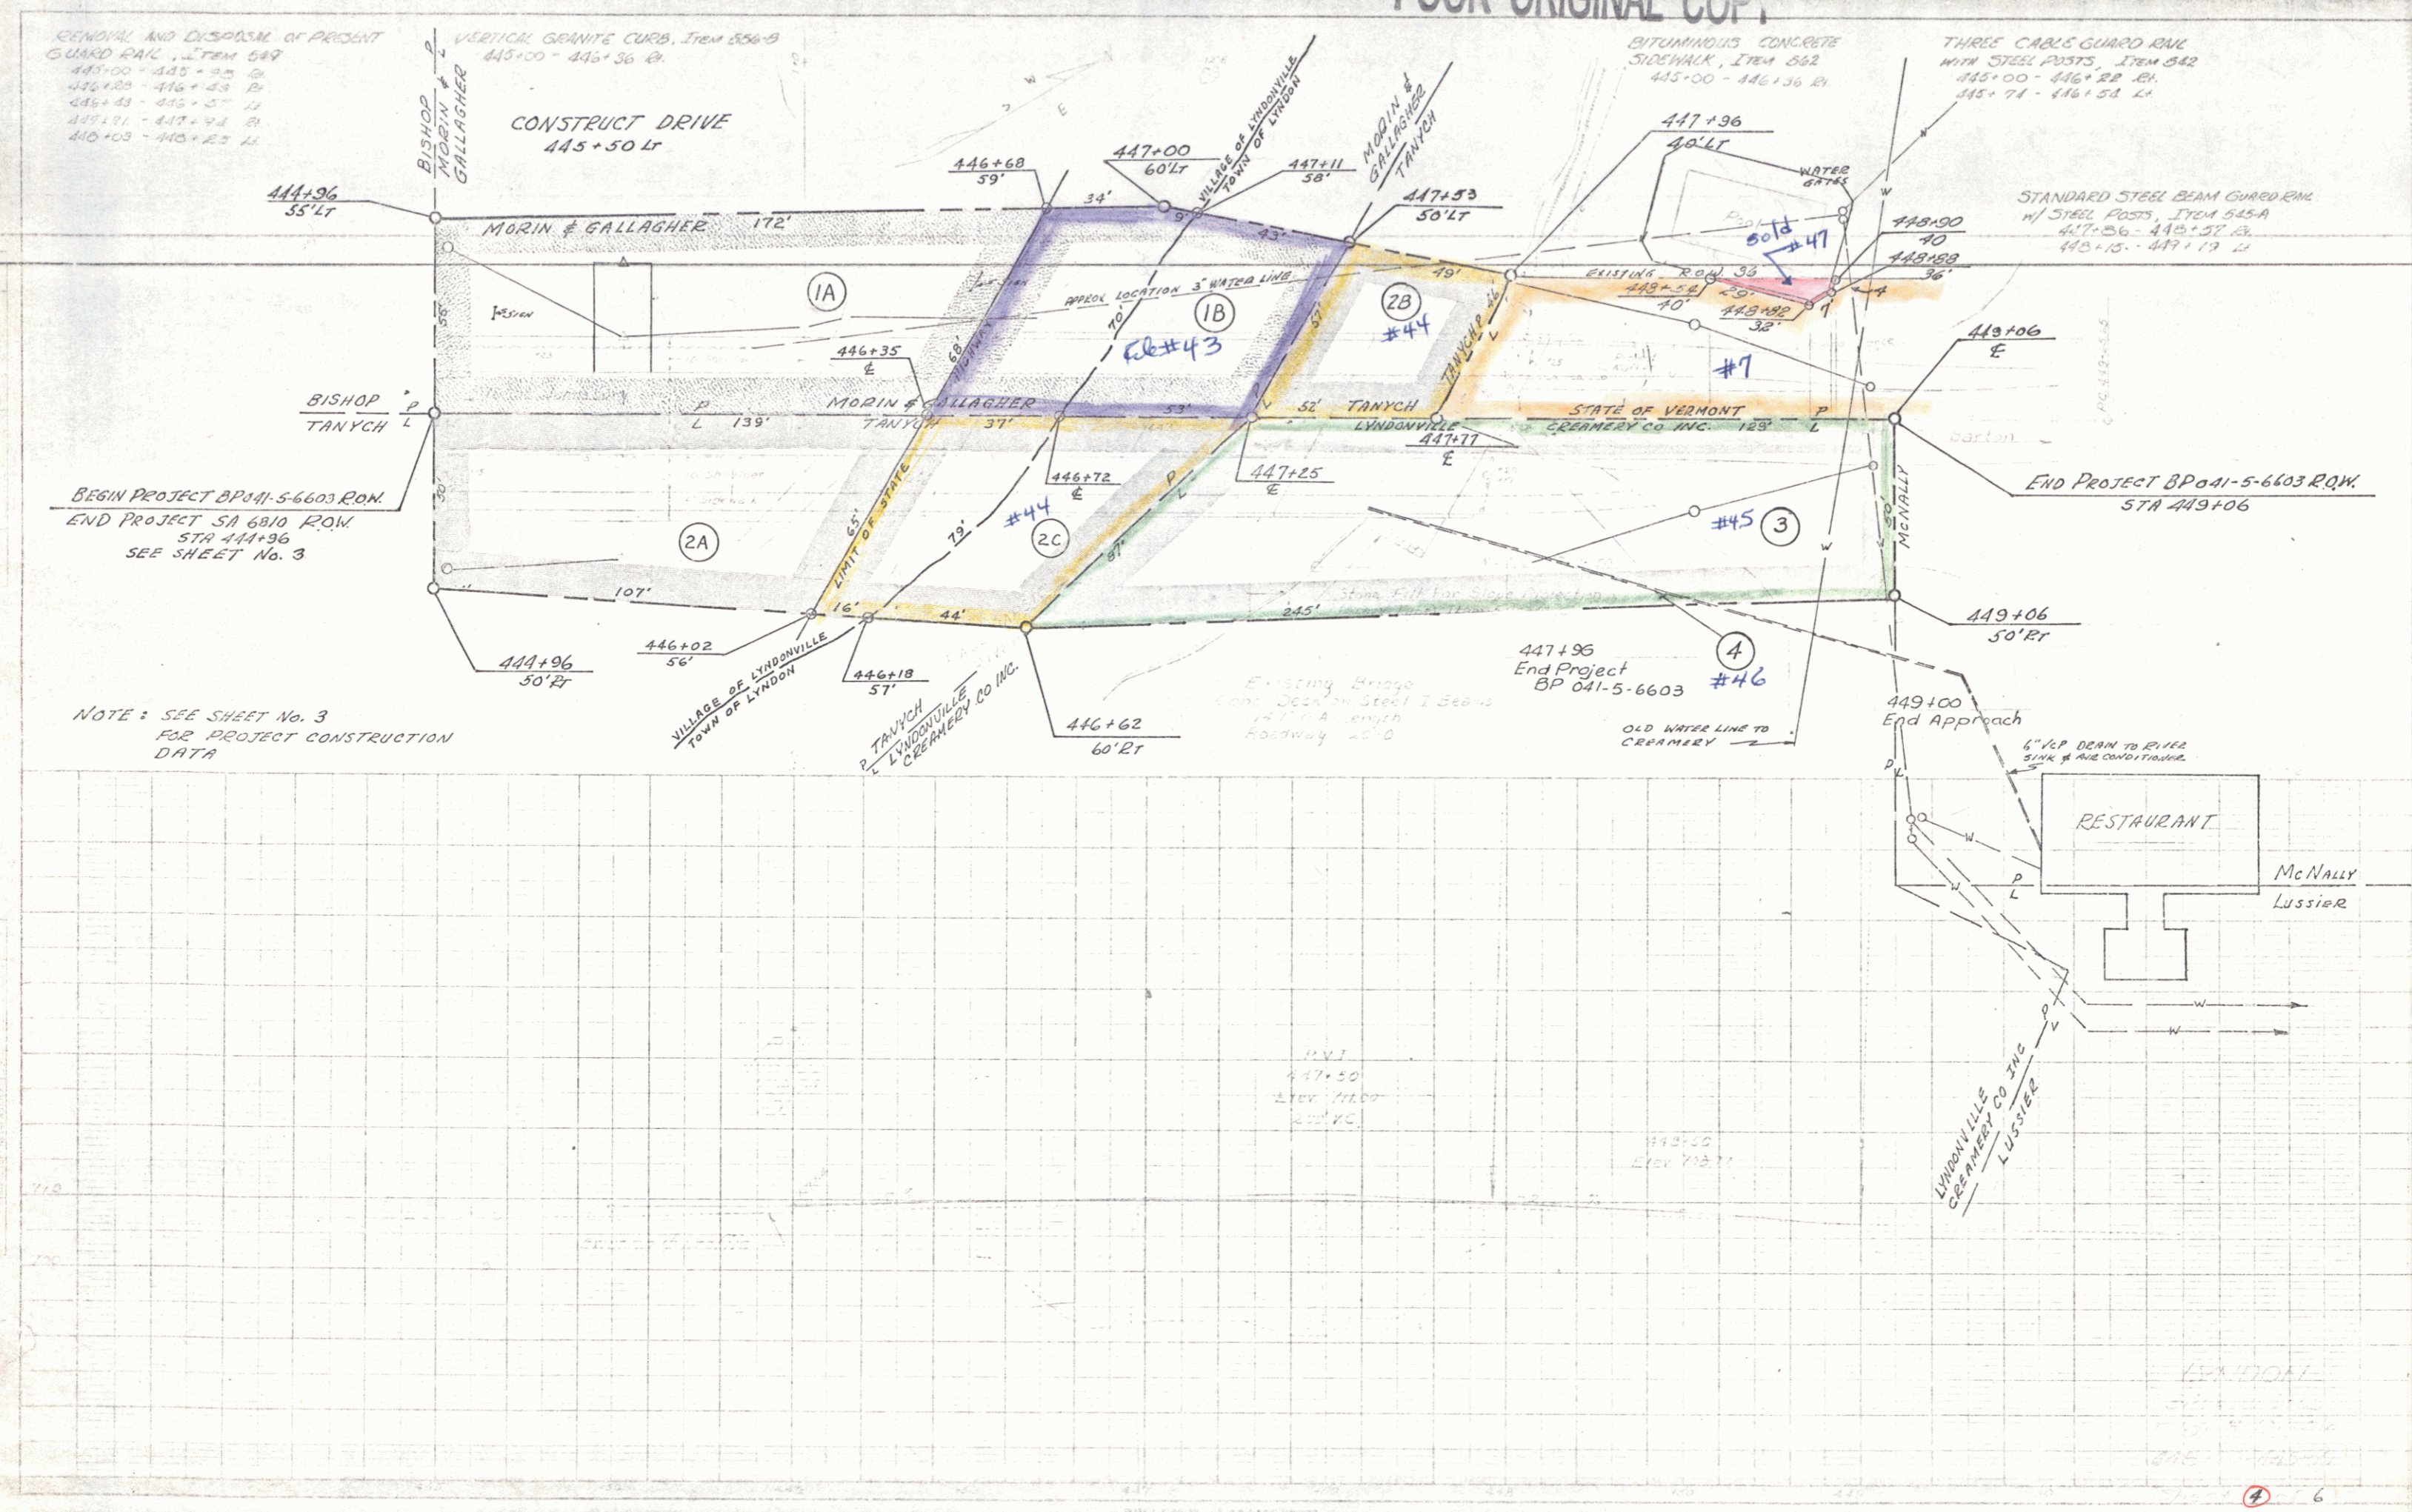

PLAN

PROFILE