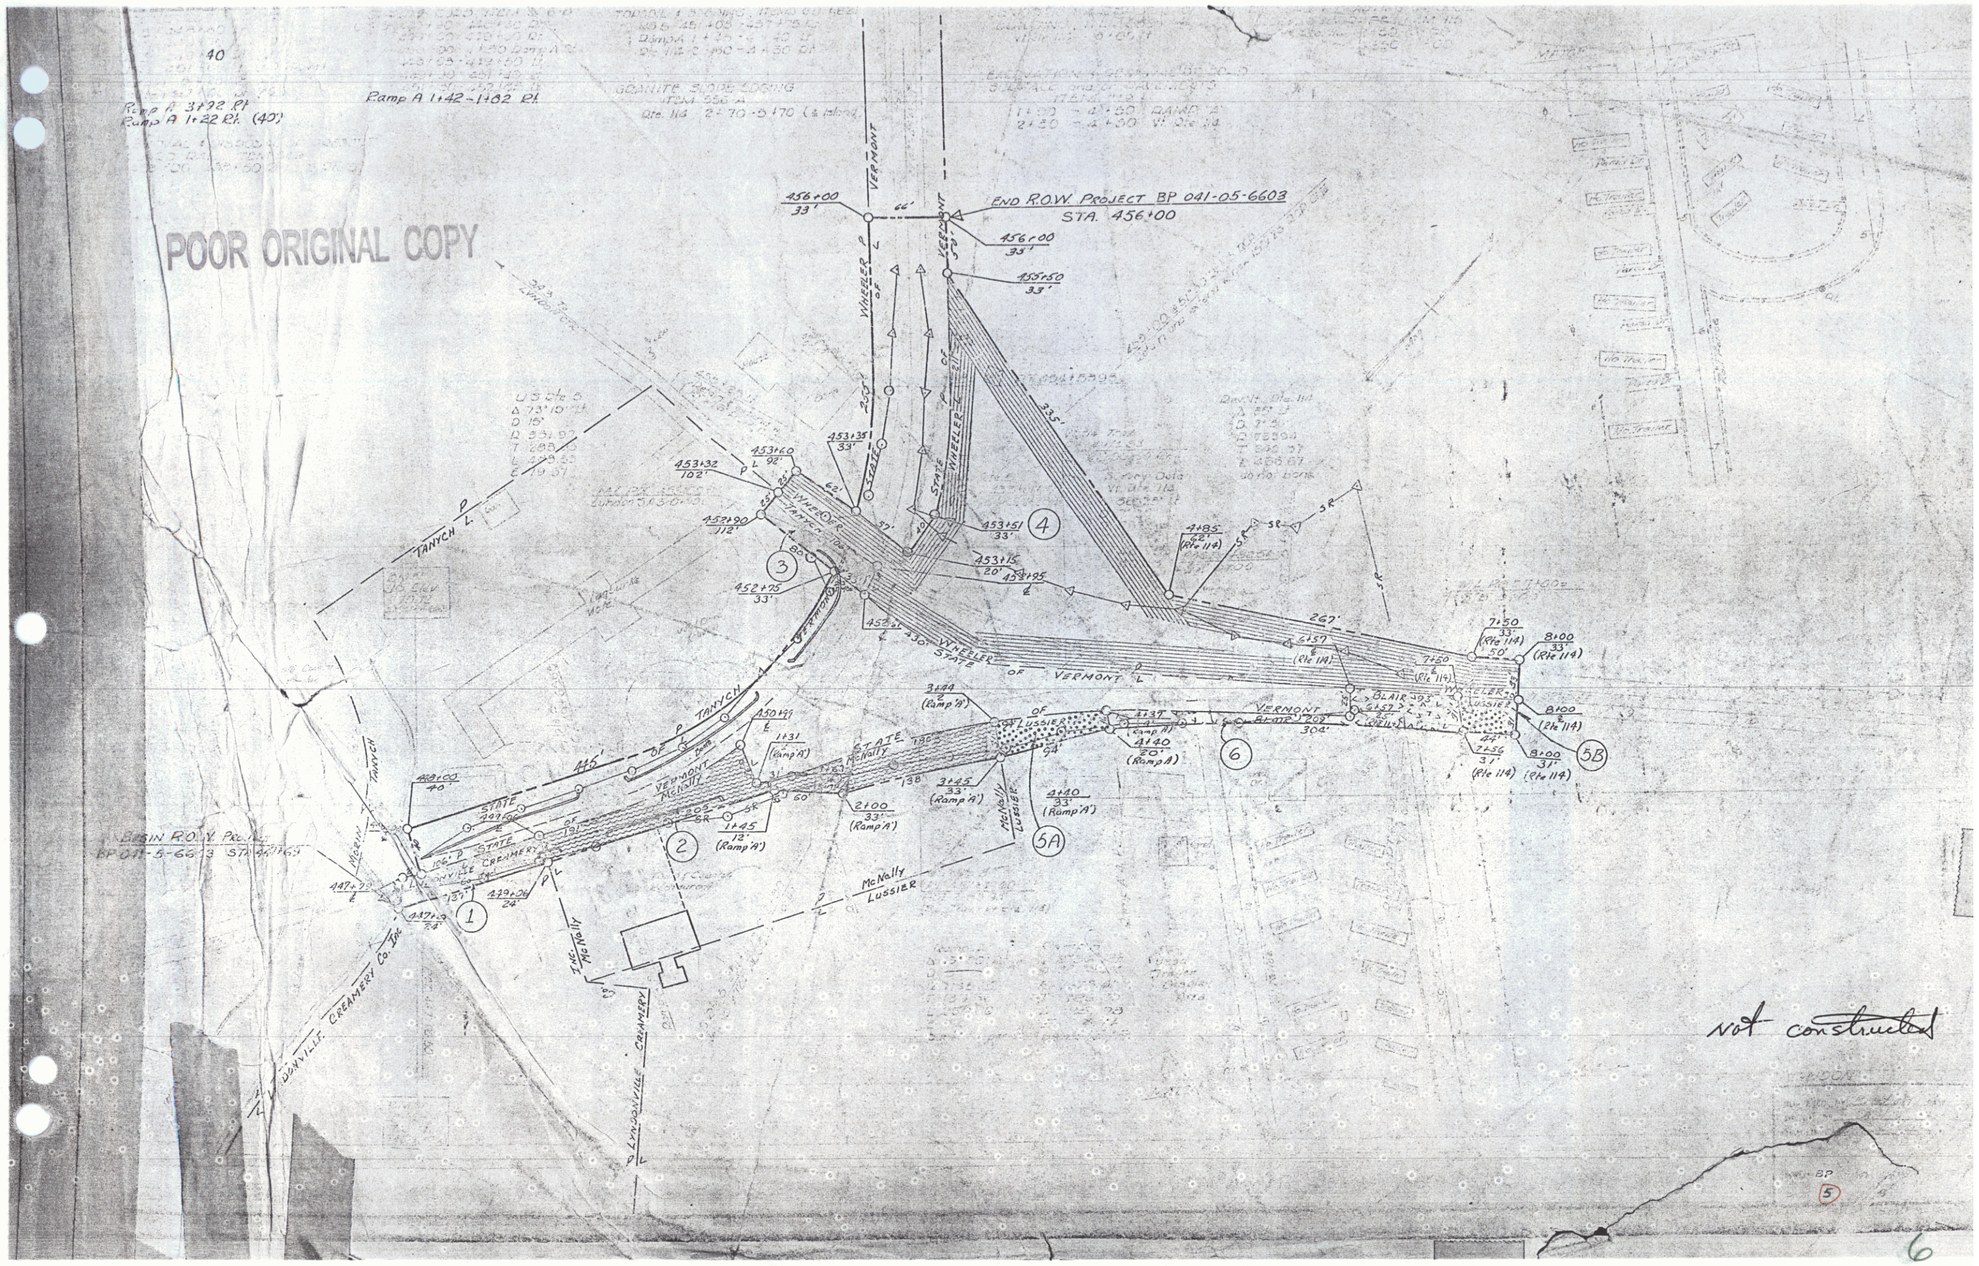
POOR ORIGINAL COPY
Ramp A 3+72 Rt.
Ramp A 1+22 Rt. (40')
Ramp A 1+42 - 1+82 Rt.
END R.O.W. PROJECT BP 041-05-6603
STA. 456+00
456+00
33'
455+50
33'
453+35
33'
453+60
98'
453+32
102'
453+90
112'
452+75
33'
453+51
33'
453+15
20'
453+95
452+30
4+85
92'
(Rte 114)
7+50
33'
50'
(Rte 114)
8+00
33'
(Rte 114)
7+56
37'
(Rte 114)
8+00
37'
(Rte 114)
3+44
(Ramp 'A')
4+37
(Ramp 'A')
4+40
80'
(Ramp A)
4+40
33'
(Ramp 'A')
3+45
33'
(Ramp 'A')
2+00
33'
(Ramp 'A')
1+45
13'
(Ramp 'A')
1+31
(Ramp 'A')
450+59
450+00
40
439+26
24
437+79
24
437+79
24
BEGIN R.O.W. PROJECT
BP 041-5-6603 STA. 437+65
VERMONT
WHEELER
STATE OF VERMONT
TANYCH
McNally
McNally LUSSIER
BLAIR
LUSSIER
STATE OF VERMONT
STATE OF VERMONT McNally
STATE OF VERMONT BLAIR
STATE OF VERMONT LUSSIER
STATE OF VERMONT CREAMERY
LYNDONVILLE CREAMERY CO. INC.
LYNDONVILLE CREAMERY
335'
267'
445'
304'
1
2
3
4
5A
5B
6
not constructed

6