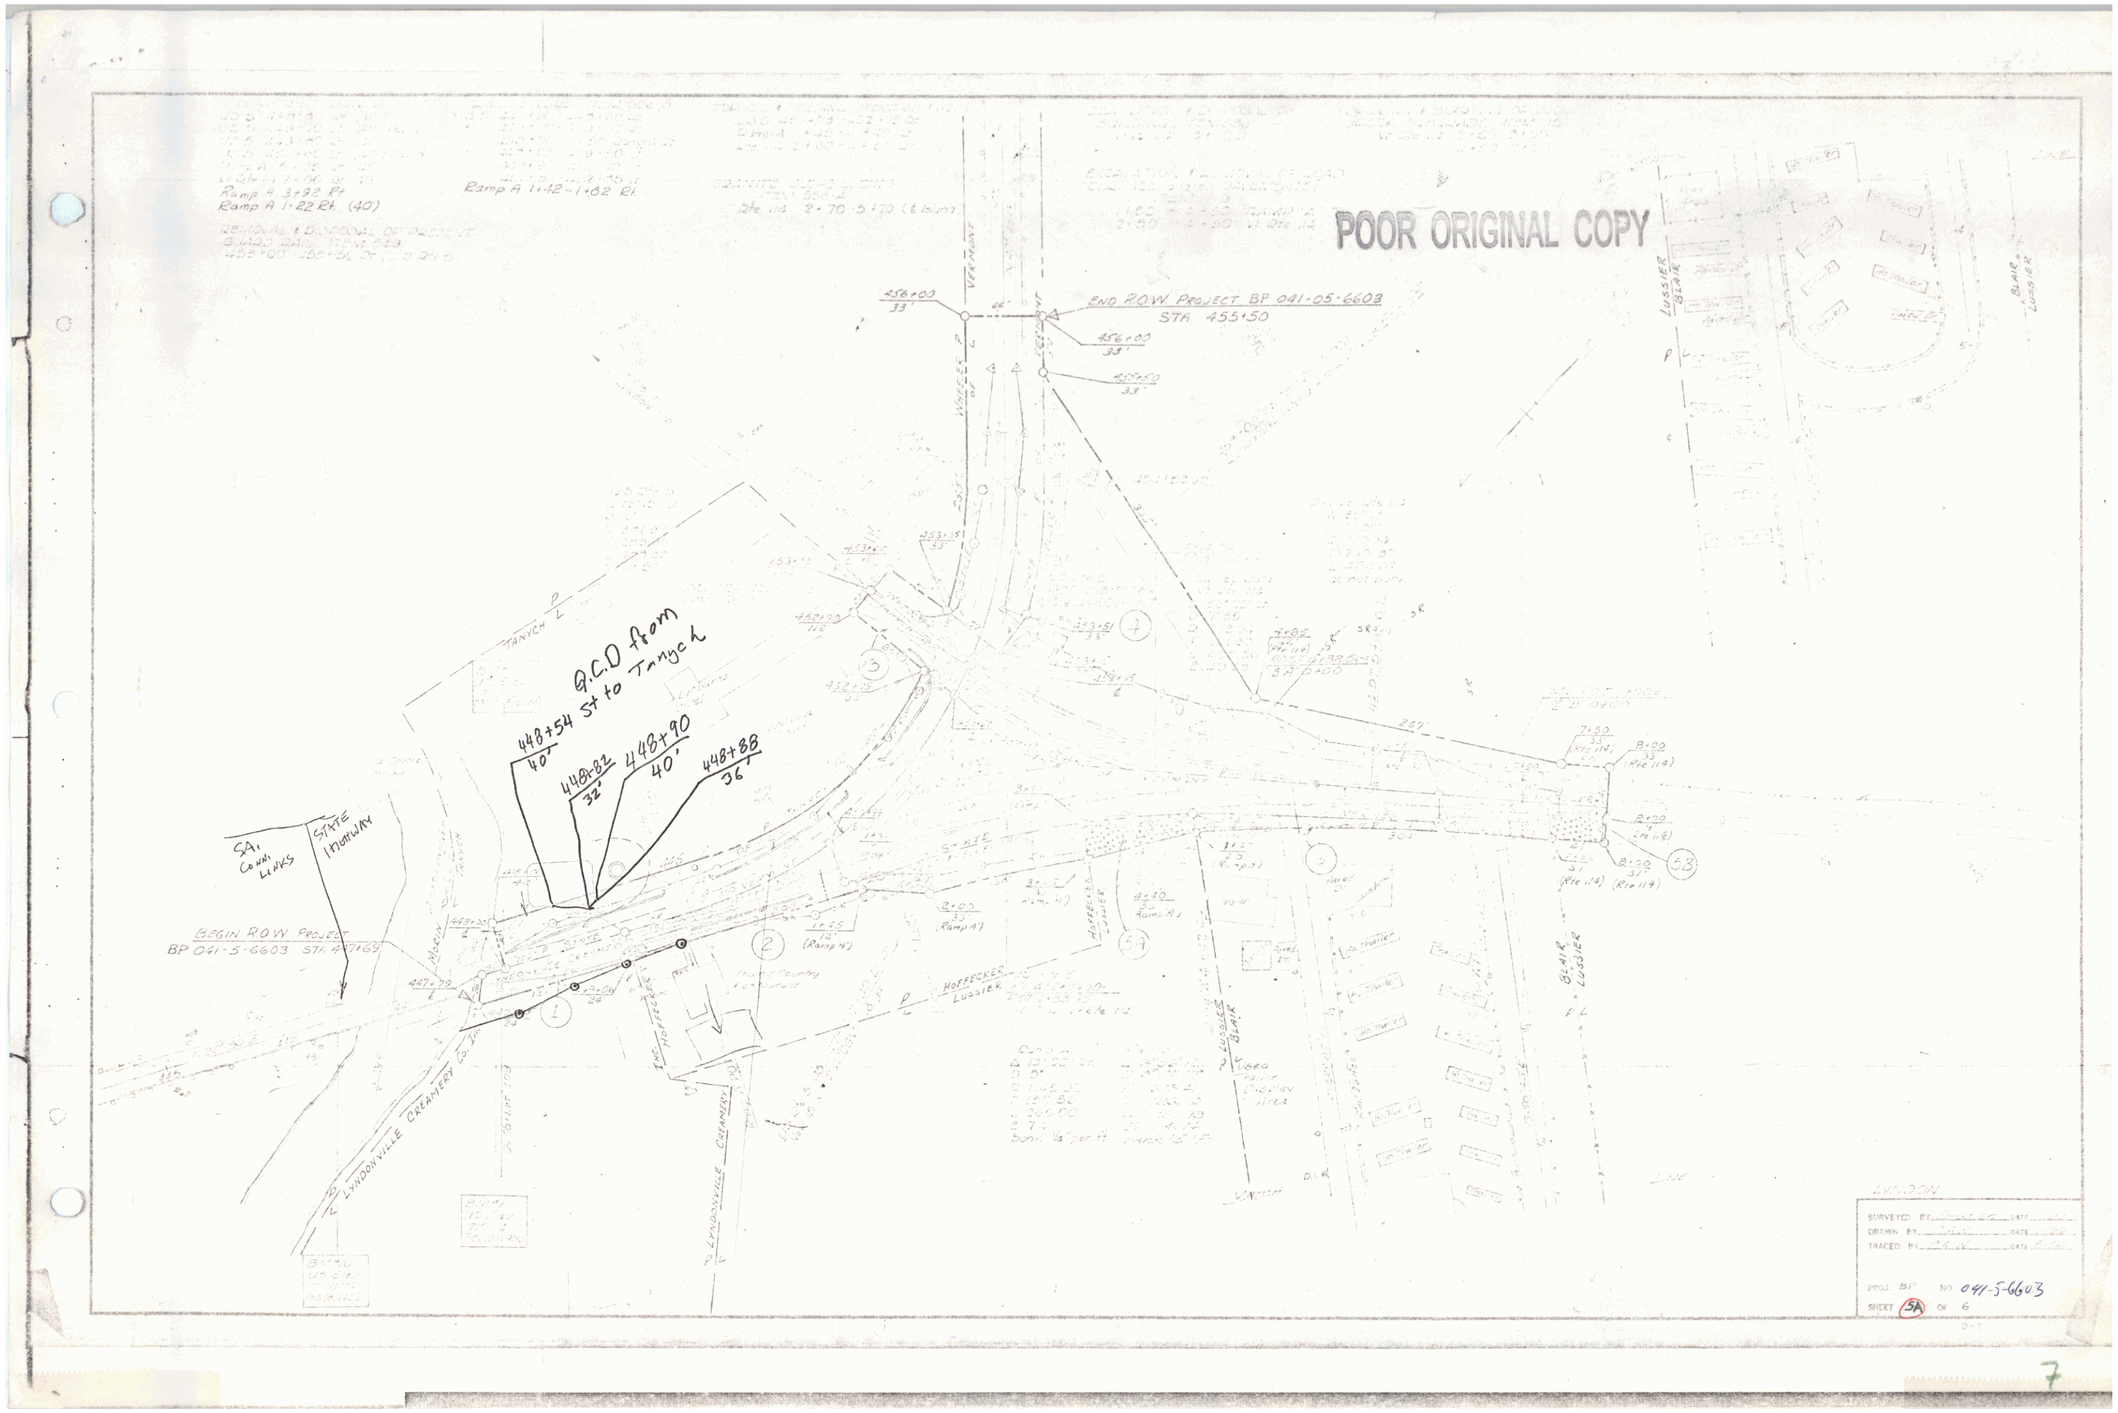
POOR ORIGINAL COPY
Ramp A 3+92 Rt
Ramp A 1+22 Rt (40)
Ramp A 1+42-1+62 Rt
456+00
33'
END R.O.W. PROJECT BP 041-05-6603
STA. 455+50
456+00
33'
455+50
33'
453+51
33'
452+90
112'
453+12
33'
453+15
50'
453+50
42'
453+51
33'
454+15
50'
