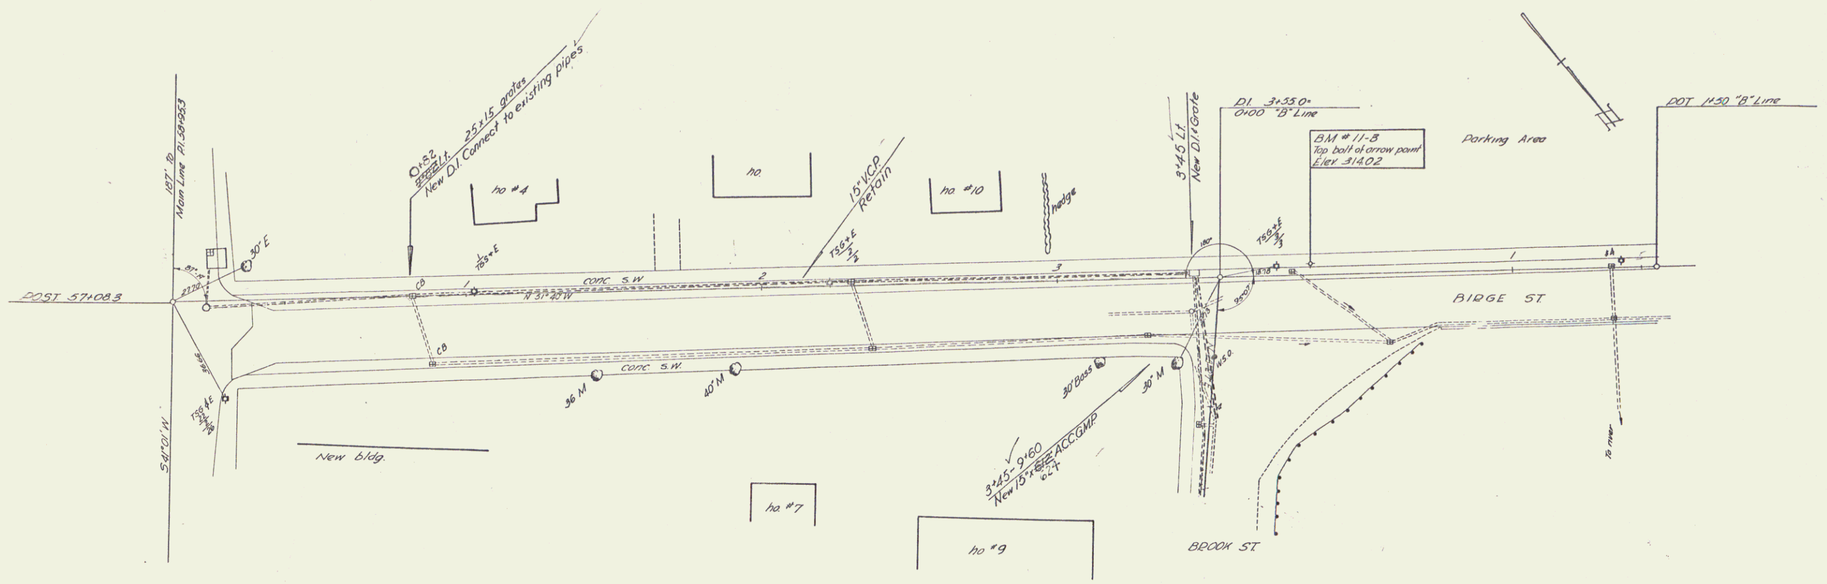

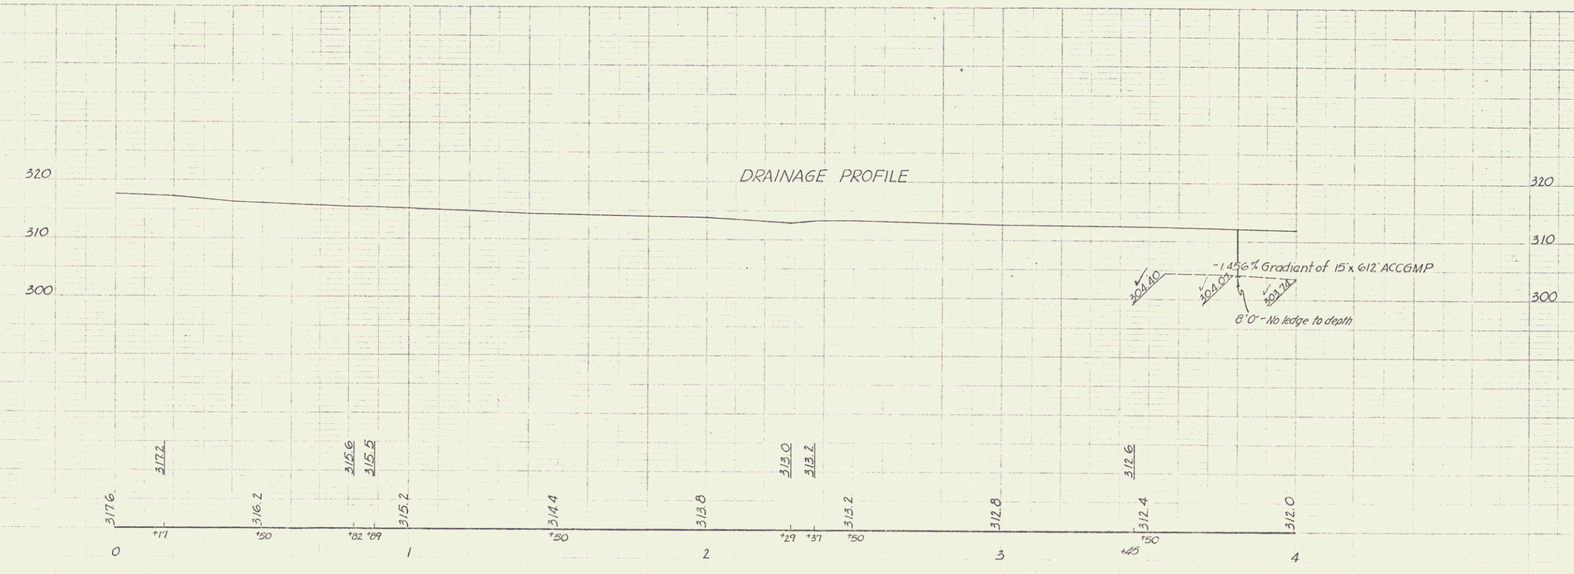

BRATTLEBORO
Project U.I. no 39(3)
Sheet 9 of 61

3