F
39 (4) 19 27
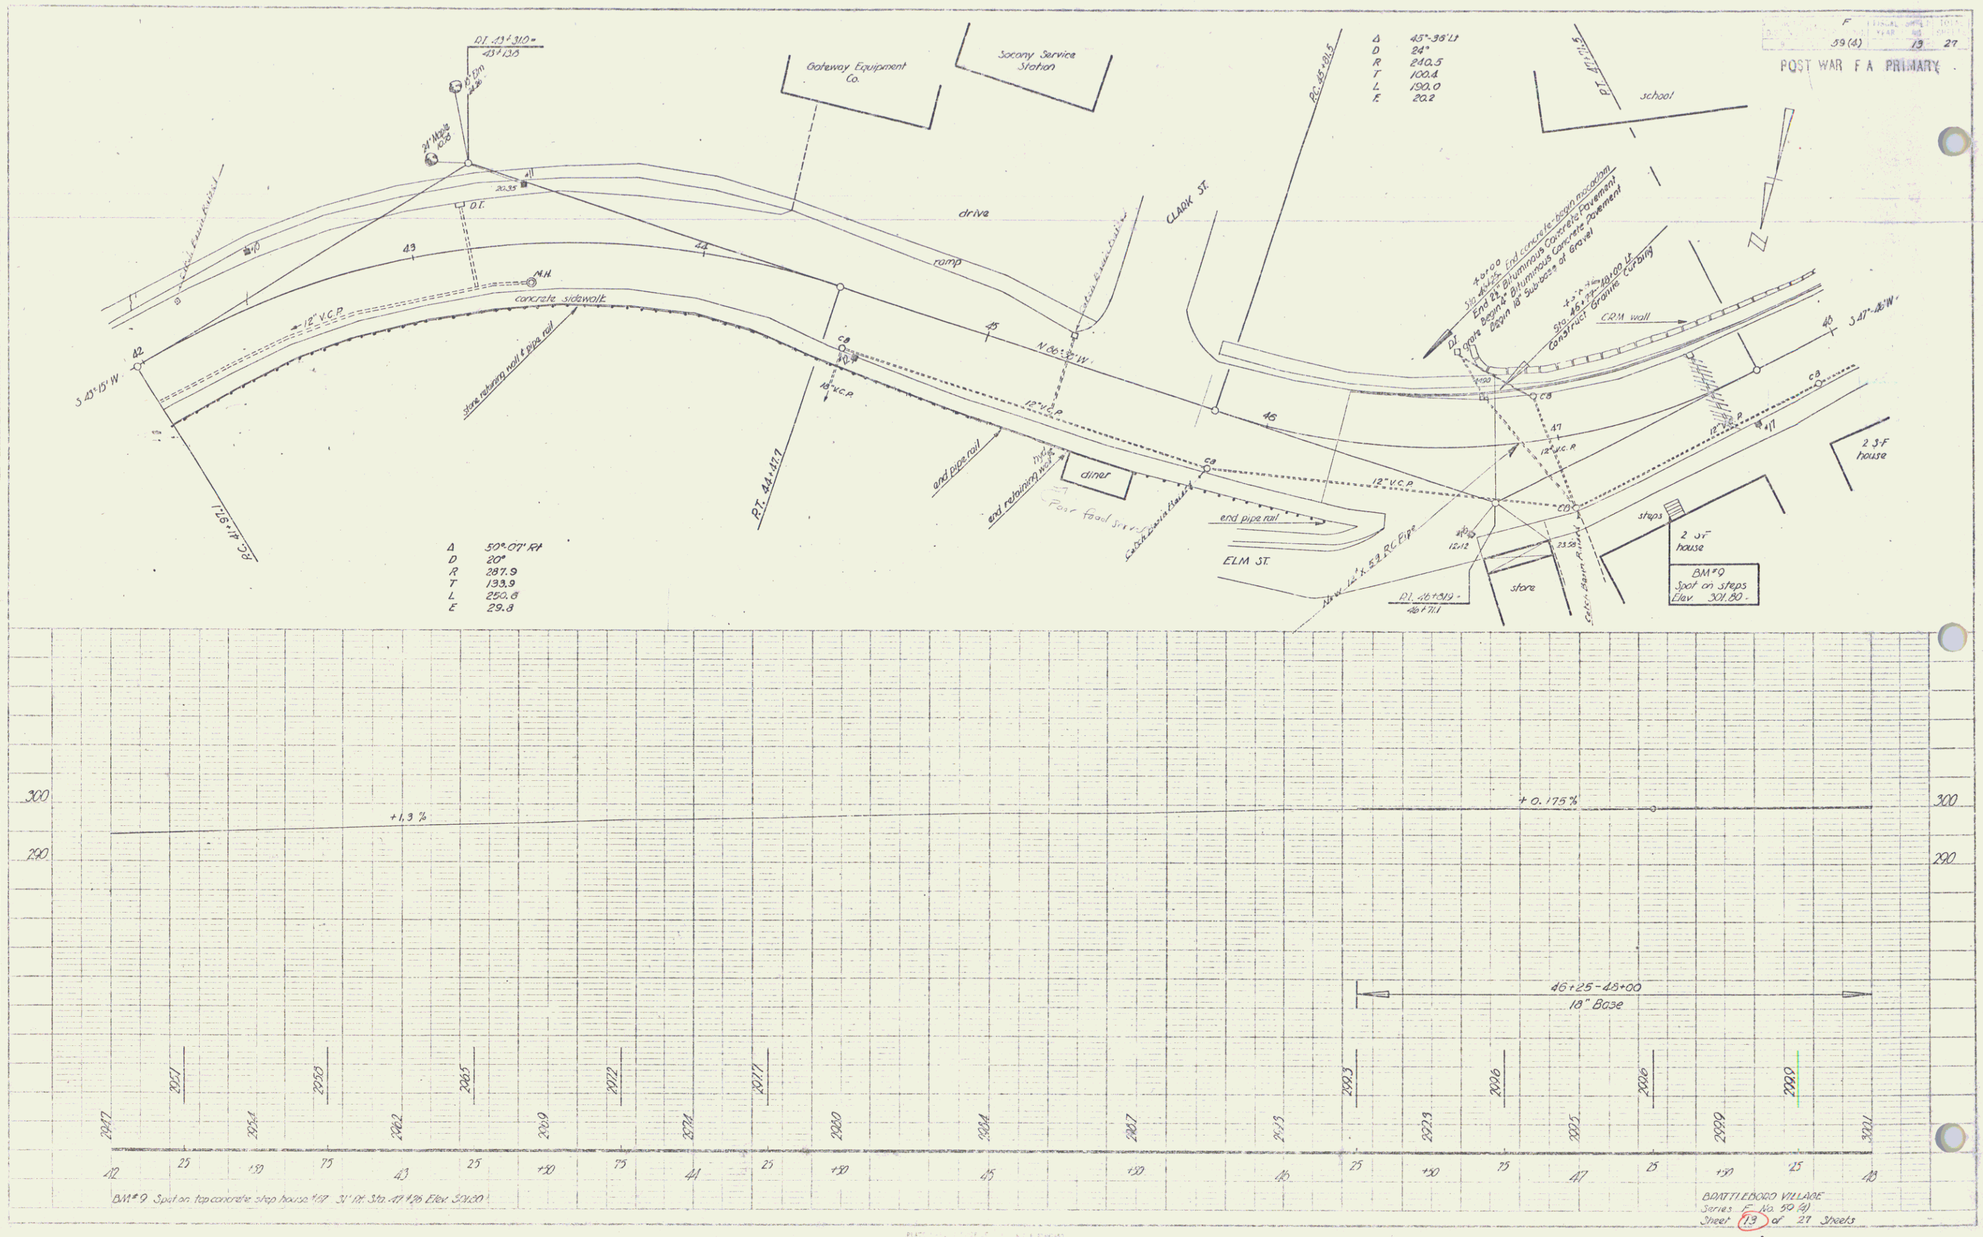
POST WAR F A PRIMARY