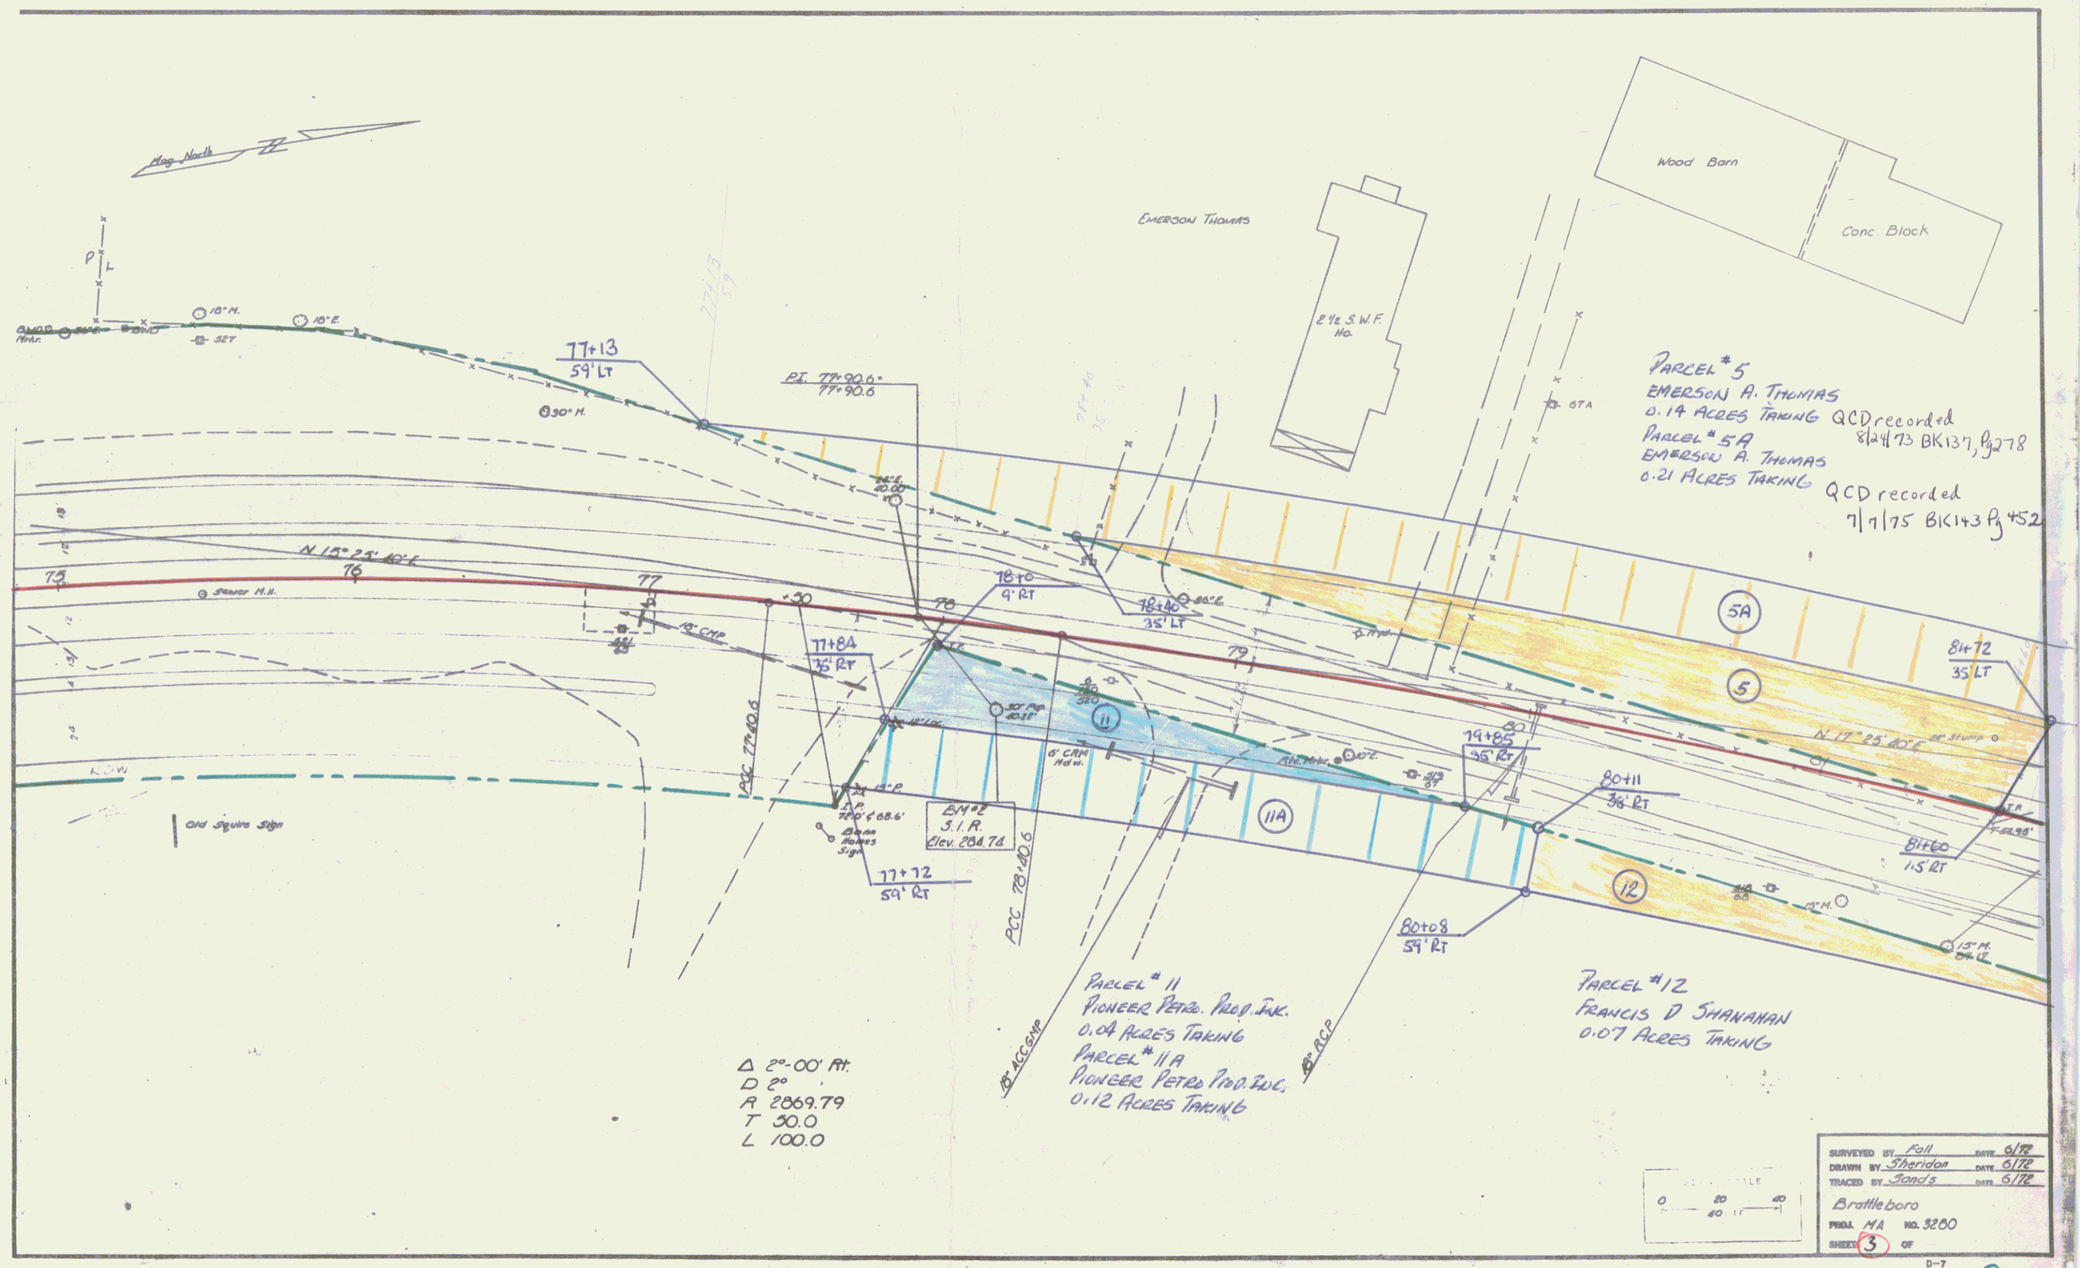
Mag. North
EMERSON THOMAS
Wood Barn
Conc. Block
2½ S.W.F. No.
PARCEL #5
EMERSON A. THOMAS
0.14 ACRES TAKING
QCD recorded 8/24/73 BK137, Pg278
PARCEL #5A
EMERSON A. THOMAS
0.21 ACRES TAKING
QCD recorded 7/7/75 BK143 Pg452
77+13
59' LT
P.I. 77+90.6
77+90.6
N 15° 25' 40" E
76
77
78
79
Sewer M.H.
18" CMP
77+84
35' RT
18+10
9' RT
18+40
35' LT
PCC 77+40.6
BM #2
S.I.R.
Elev. 284.74
77+72
59' RT
PCC 78+40.6
11
11A
5A
5
12
19+85
35' RT
80+11
38' RT
80+08
59' RT
81+72
35' LT
81+60
1.5' RT
N 17° 25' 40" E
Old Squire Sign
PARCEL #11
PIONEER PETRO. PROD. INC.
0.04 ACRES TAKING
PARCEL #11A
PIONEER PETRO PROD. INC.
0.12 ACRES TAKING
PARCEL #12
FRANCIS D SHANAHAN
0.07 ACRES TAKING
Δ 2°-00' Rt.
D 2°
R 2869.79
T 50.0
L 100.0
SURVEYED BY Fall DATE 6/72
DRAWN BY Sheridan DATE 6/72
TRACED BY Sands DATE 6/72
Brattleboro
PROJ. MA NO. 3280
SHEET 3 OF
D-7

9