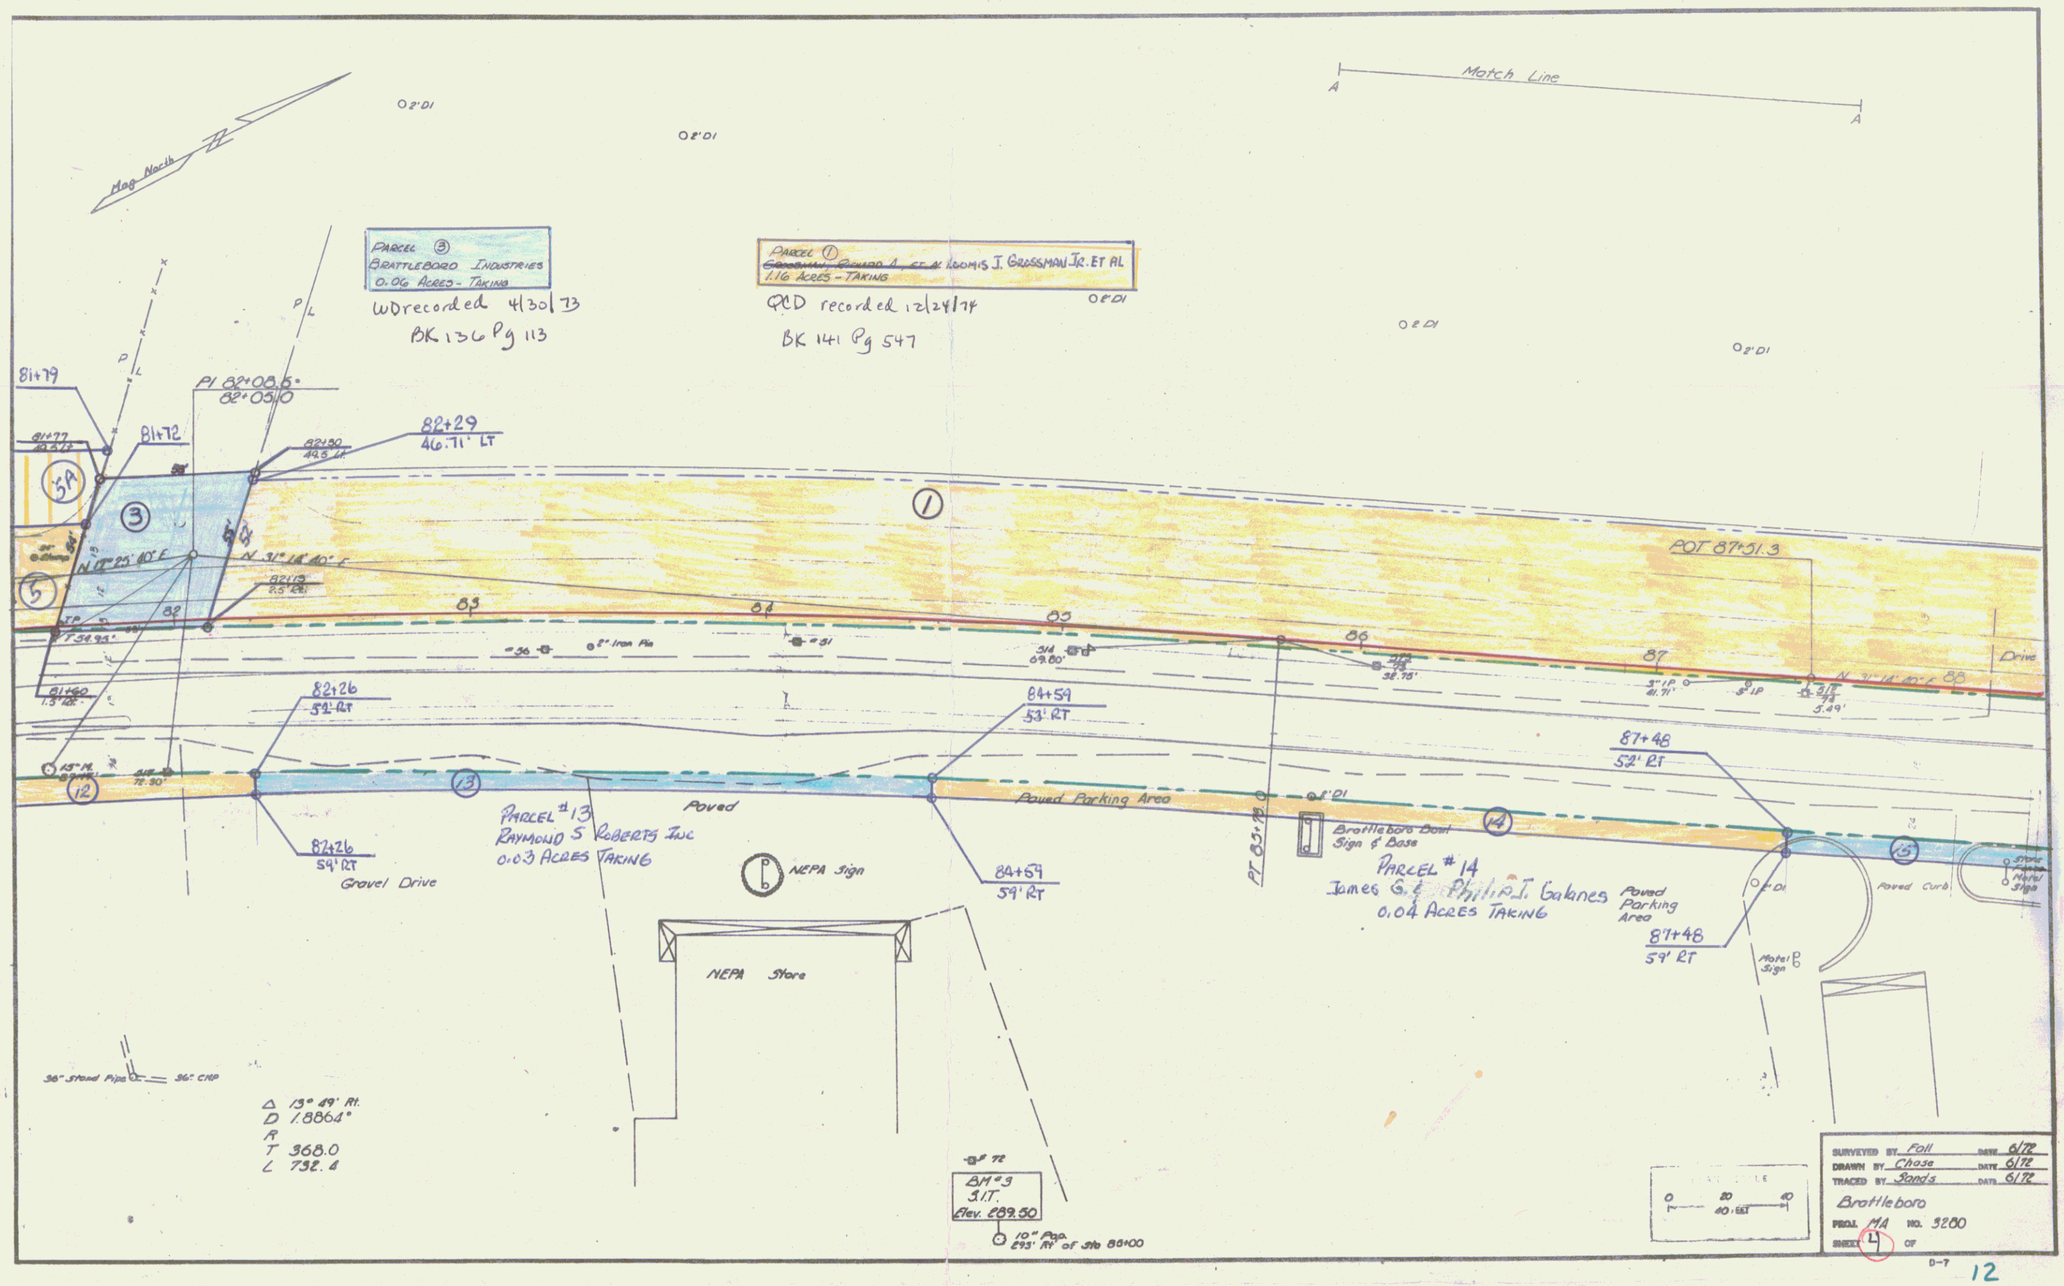
Mag North
Match Line
A
A
PARCEL 3
BRATTLEBORO INDUSTRIES
0.06 ACRES - TAKING
WD recorded 4/30/73
BK 136 Pg 113
PARCEL 1
LOOMIS J. GROSSMAN JR. ET AL
1.16 ACRES - TAKING
QCD recorded 12/24/74
BK 141 Pg 547
81+79
81+77
81+72
PI 82+08.6°
82°05'0"
82+29
46.71' LT
82+30
44.3' LT
82+19
2.5' RT
81+60
1.5' RT
N 31°25' 40" E
N 31°14' 40" E
POT 87+51.3
82+26
52' RT
82+26
54' RT
Gravel Drive
PARCEL #13
RAYMOND S ROBERTS INC
0.03 ACRES TAKING
Paved
NEPA Sign
NEPA Store
84+59
53' RT
84+59
54' RT
Paved Parking Area
PT 85+70
Brattleboro Boat Sign & Base
PARCEL #14
James G. & Philip T. Gaines
0.04 ACRES TAKING
Paved Parking Area
87+48
52' RT
87+48
54' RT
Paved Curb
Drive
Motel Sign
Store Motel Sign
36" Stand Pipe
36" CMP
Δ 13° 49' Rt.
D 1.8864°
R
T 368.0
L 732.4
BM #3
S.I.T.
Elev. 289.50
10" Pine
293' Rt of Sta 85+00
SURVEYED BY Foll DATE 6/72
DRAWN BY Chase DATE 6/72
TRACED BY Sands DATE 6/72
Brattleboro
PROJ. MA NO. 3280
SHEET 4 OF
D-7
12