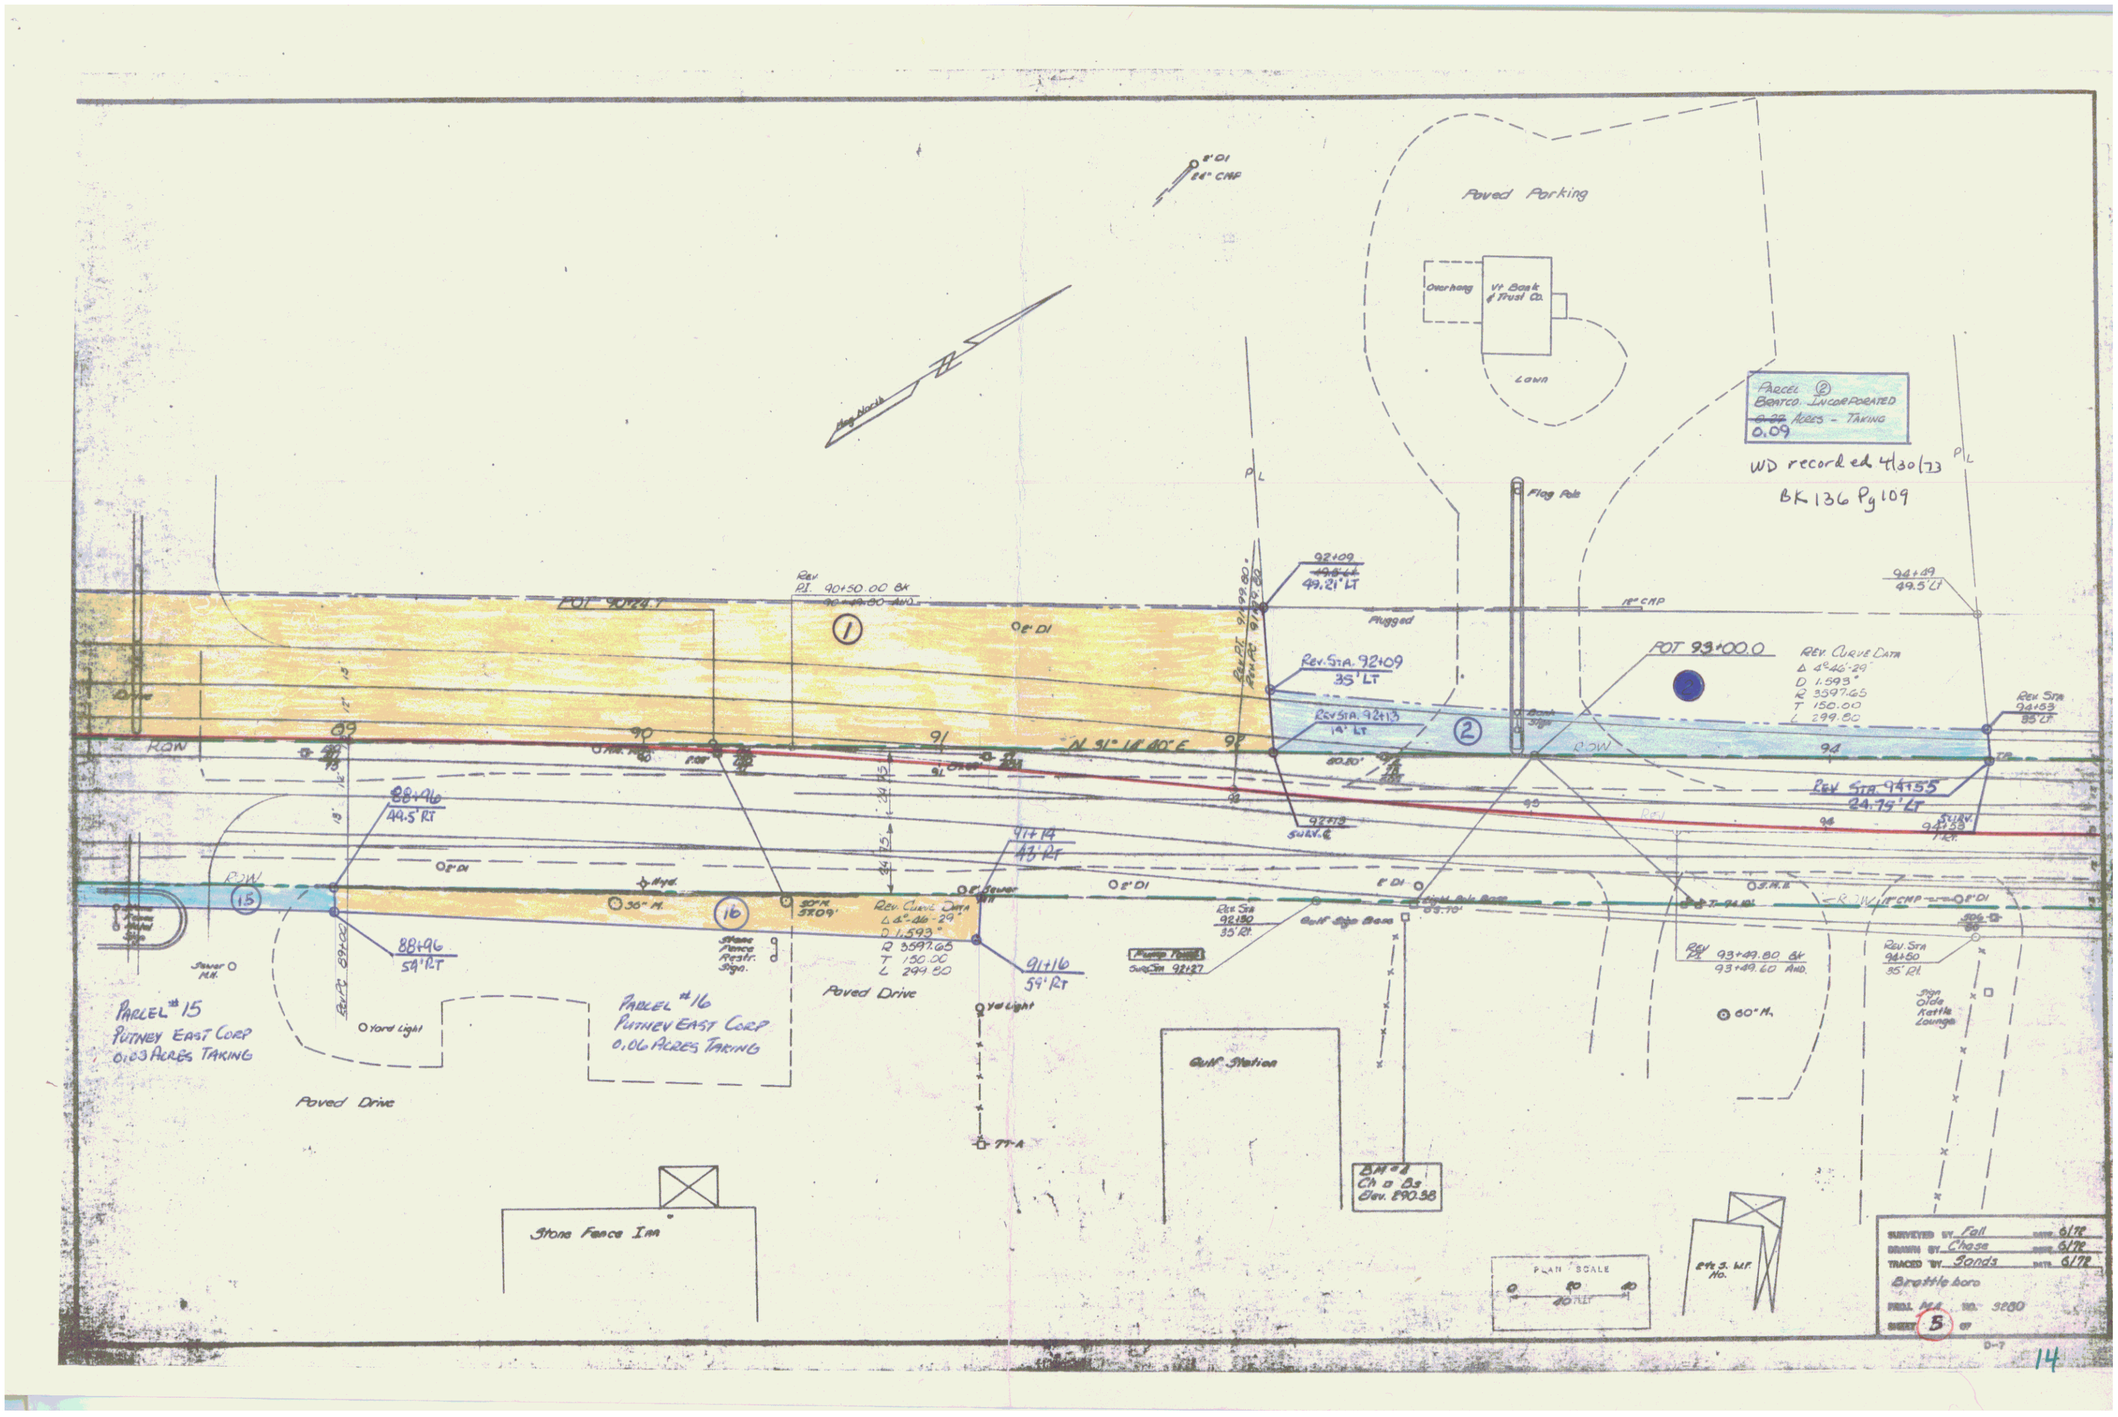
Paved Parking
Overhang
Vt. Bank & Trust Co.
Lawn
Parcel 2
Brattco. Incorporated
0.09 Acres - Taking
WD recorded 4/30/73
Bk 136 Pg 109
Flag Pole
Flag North
8" DI
24" CMP
P/L
92+09
49.21' LT
Plugged
Rev. Sta. 92+09
35' LT
Rev. Sta. 92+13
14' LT
POT 93+00.0
Rev. Curve Data
Δ 4°46'29"
D 1.593°
R 3597.65
T 150.00
L 299.80
Rev. Sta. 94+53
85' LT
Rev. Sta. 94+55
24.79' LT
94+49
49.5' LT
18" CMP
POT 90+24.1
Rev. P.I. 90+50.00 Bk
N 91° 16' 40" E
ROW
88+96
44.5' RT
88+96
54' RT
91+14
43' RT
91+16
59' RT
Rev. Curve Data
Δ 4°46'29"
D 1.593°
R 3597.65
T 150.00
L 299.80
Rev. Sta. 92+50
35' RT
Rev. Sta. 94+50
85' RT
Rev. P.I. 93+49.80 Bk
93+49.60 Ahd.
Sign Olde Rattle Lounge
Parcel #15
Putney East Corp
0.03 Acres Taking
Parcel #16
Putney East Corp
0.06 Acres Taking
Stone Fence Restr. Sign.
Paved Drive
Yard Light
Stone Fence Inn
Gulf Station
Gulf Sign Base
Pump Island
Sewer M.H.
Hyd.
36" M.
60" M.
TT-A
BM #1
Ch. o Bs
Elev. 890.38
PLAN SCALE
Surveyed by Fall
Drawn by Chase
Traced by Sands
Brattleboro
Proj. No. 9280
Sheet 5 of 7
14