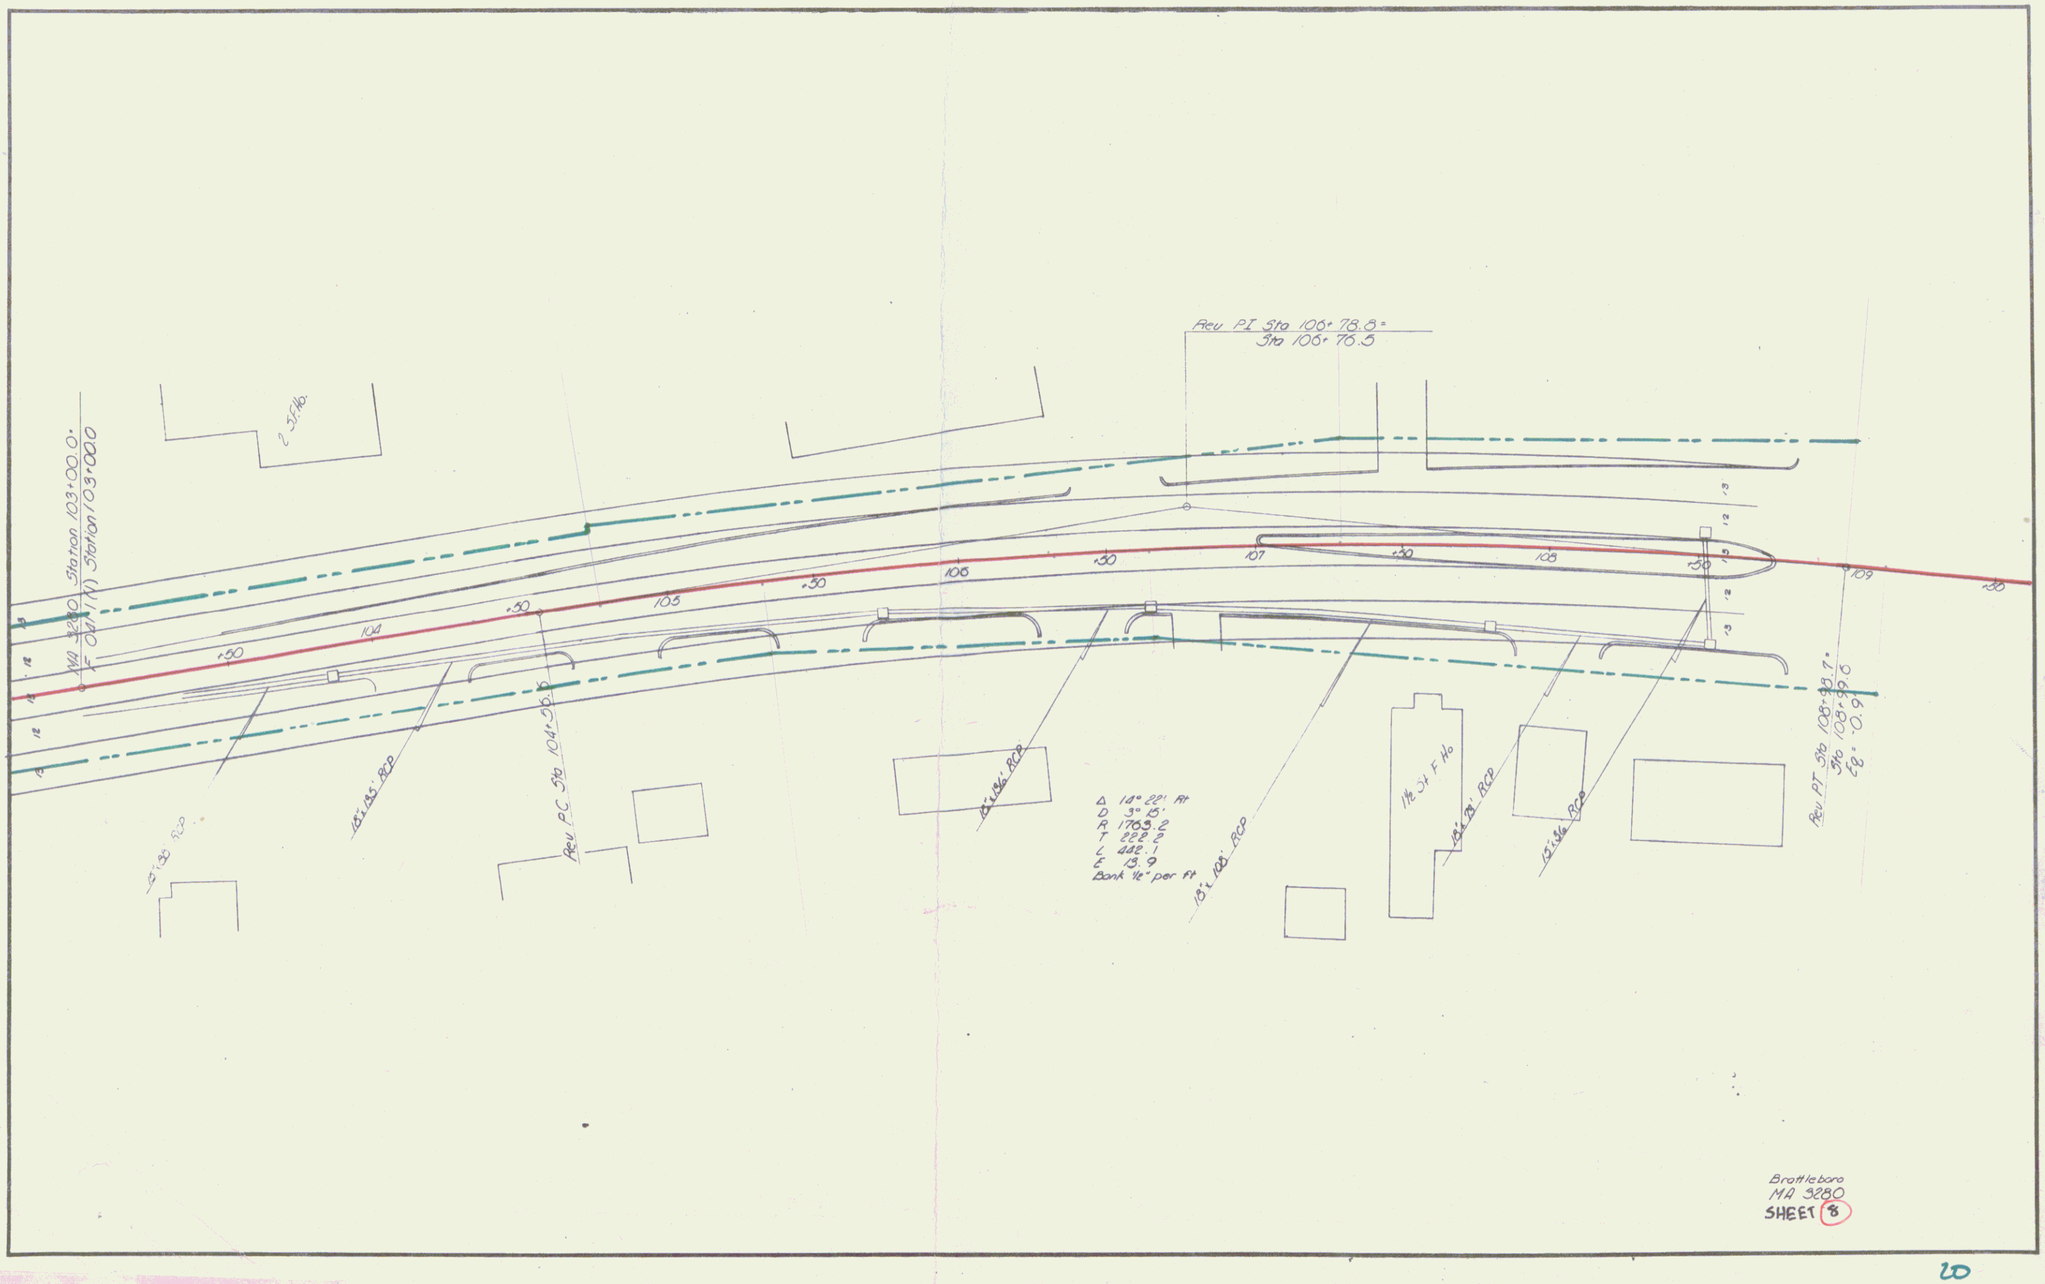
MA 3280 Station 103+00.0
F. Dist (N) Station 103+00.0
Rev PI Sta 106+78.8 =
Sta 106+76.5
Rev PC Sta 104+56.5
Rev PT Sta 108+88.7 =
Sta 108+99.0
Δ 14° 22' Rt
D 3° 15'
R 1763.2
T 222.2
L 442.1
E 13.9
Bank 1½" per ft
Brattleboro
MA 3280
SHEET 8