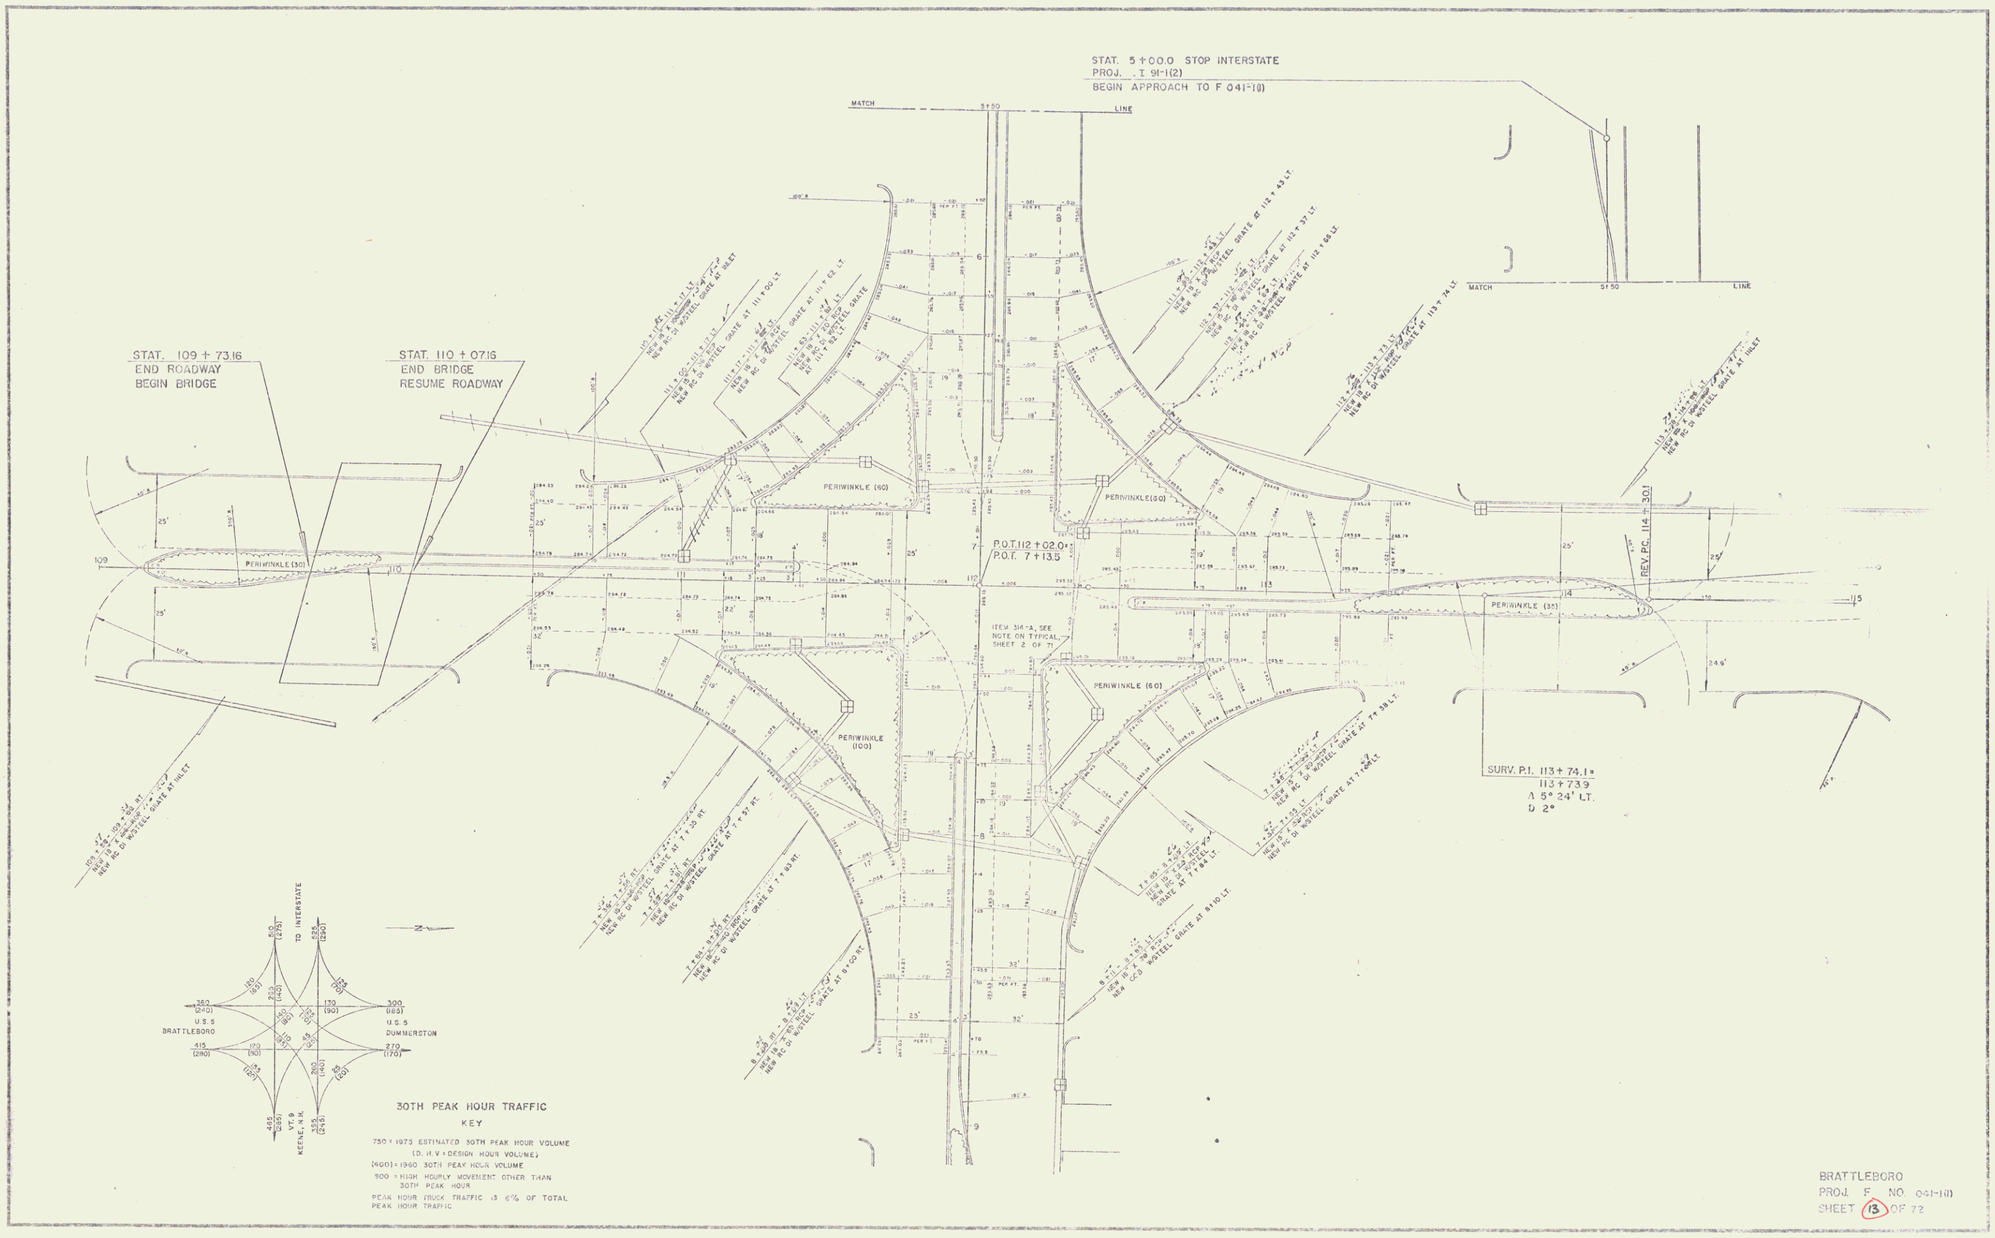

BRATTLEBORO
PROJ. F NO. 041-1(1)
SHEET 13 OF 72

7