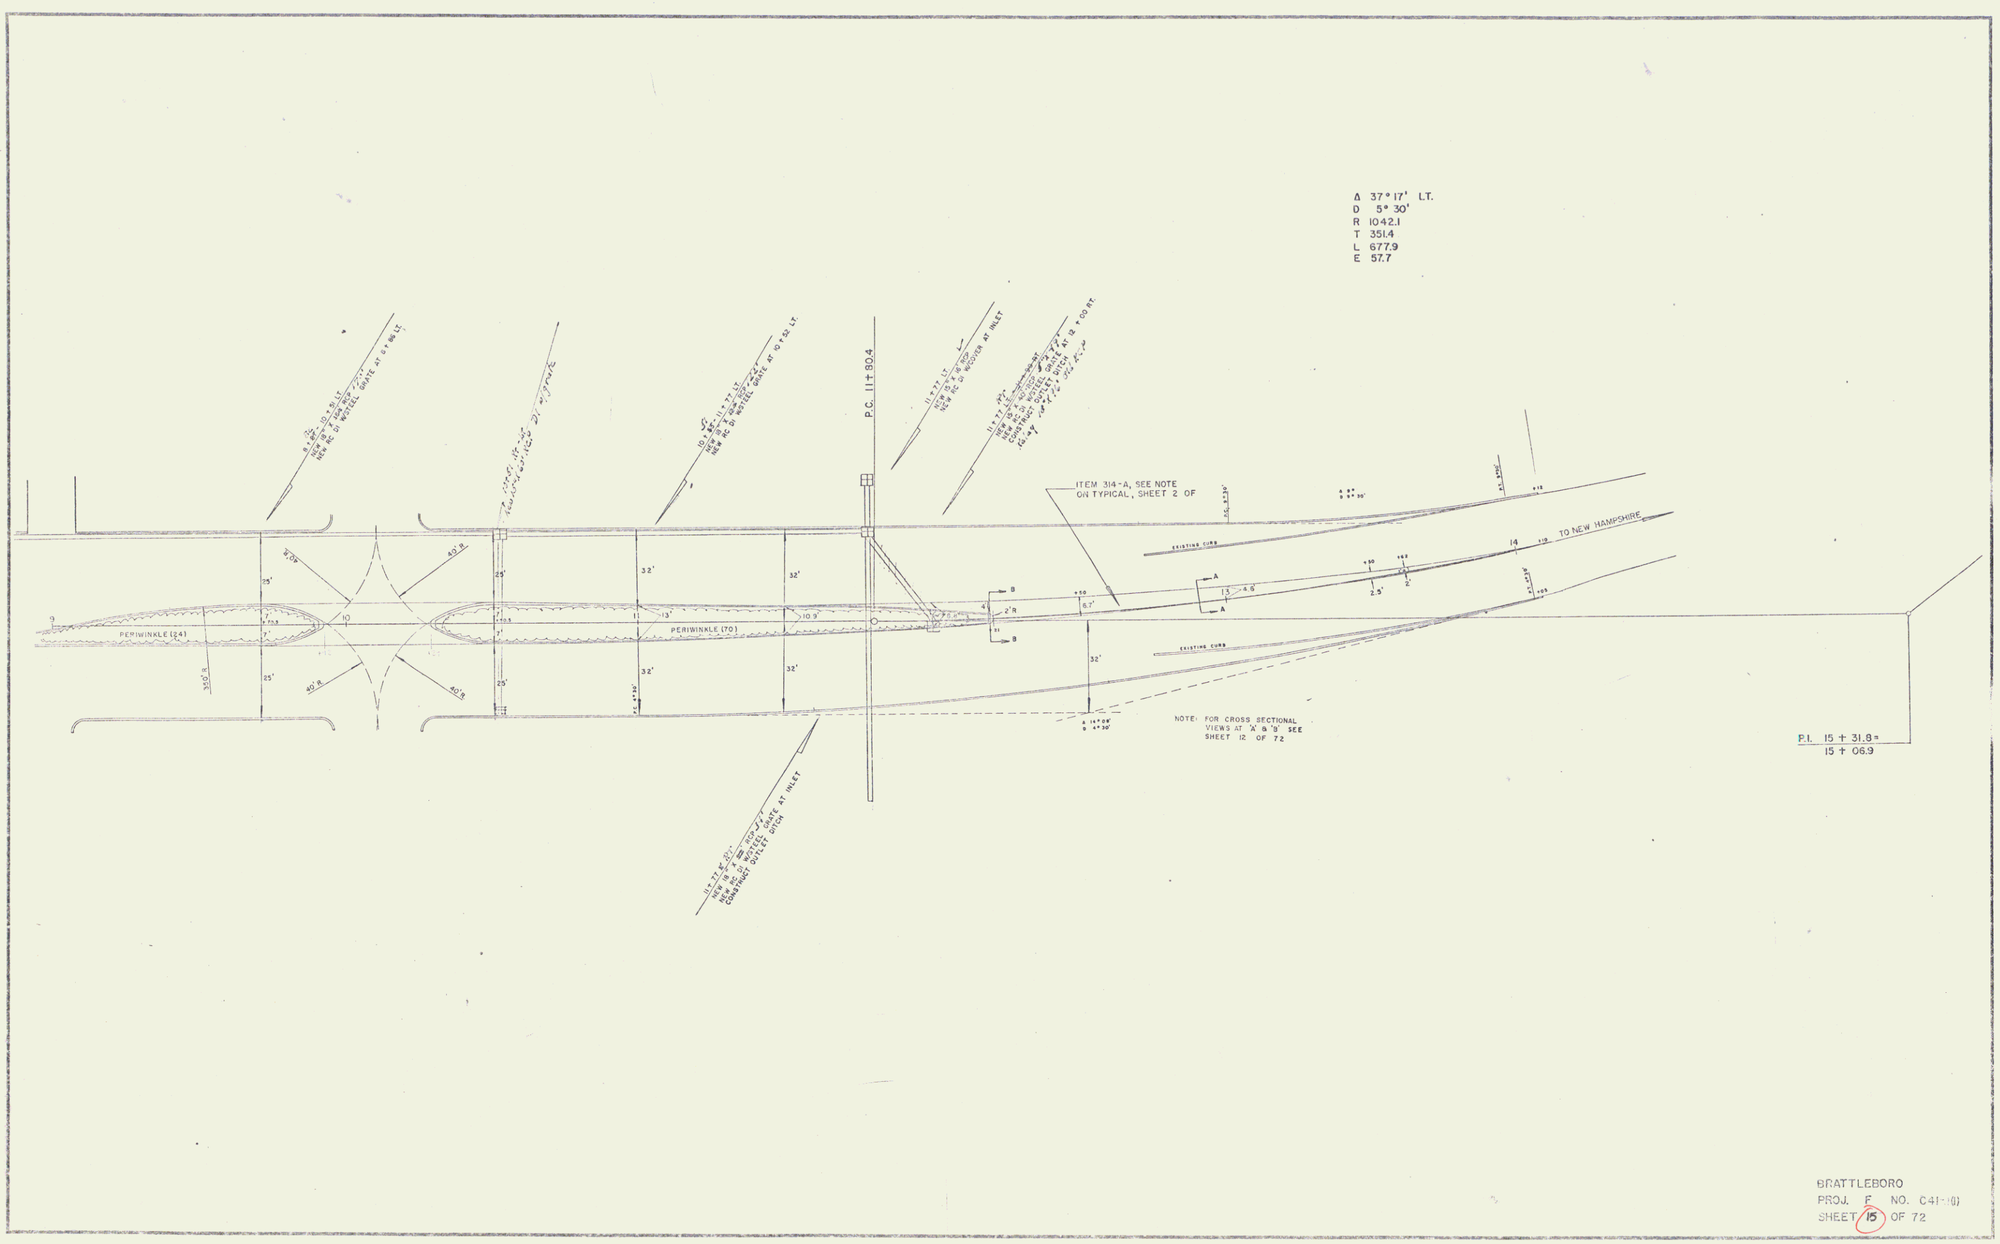

BRATTLEBORO
PROJ. F NO. C41-10
SHEET 15 OF 72

9